

8809
3-16-94

Benton County Surveyor's Office

C.S. FILE NO. 8809
FILING DATE 3-16-1994
FILE SIZE 8 1/2 x 14

Record of Survey
for
PAM PATTIESHAW

In The
S.W. 1/4 of S.E. 1/4 of Section 17
T. 10. S., R. 7 W., W.M.
BENTON CO., OREGON
19.8 Ac.




REGISTERED
PROFESSIONAL
LAND SURVEYOR

Richard W. Fail

OREGON
NOVEMBER 4, 1908
RICHARD W. FAIL
357

Ref: C.S. 3515 1" = 400'

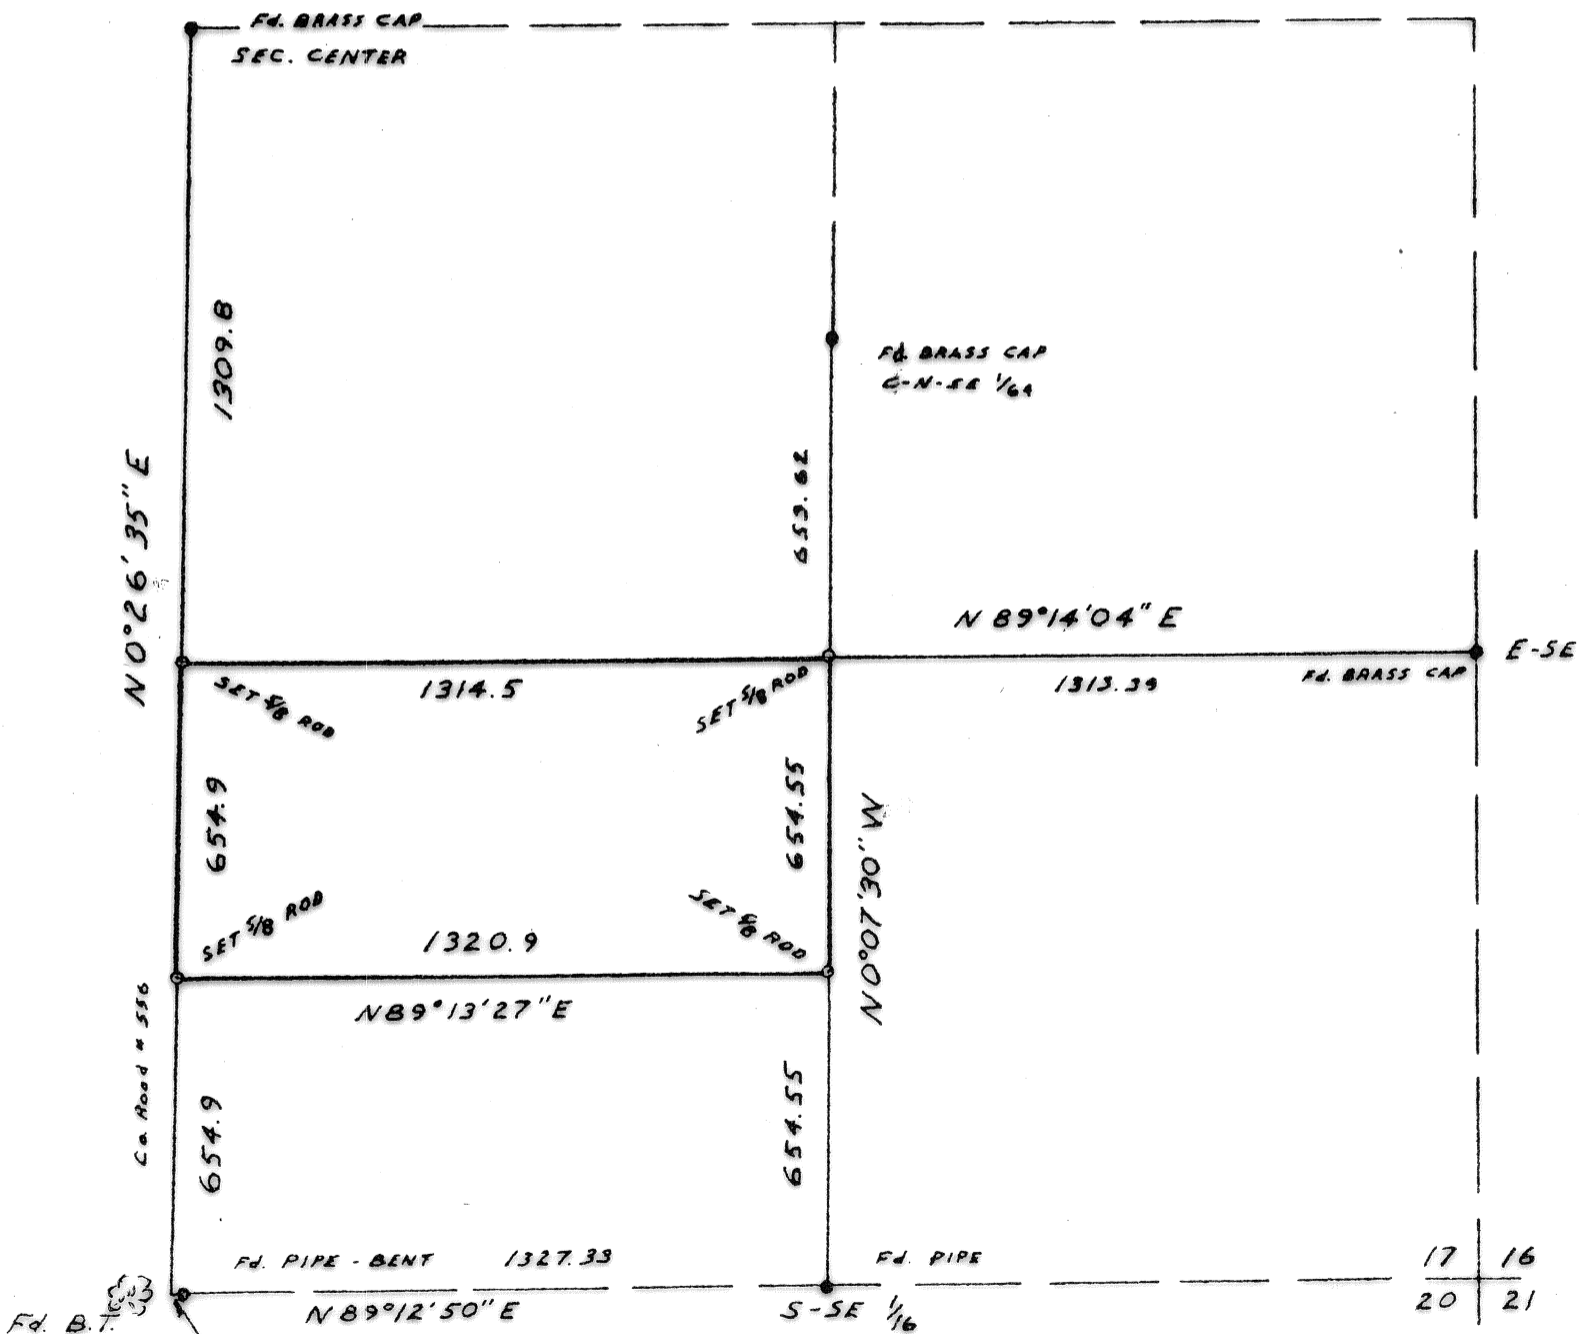

3-16-94 20-

NOTE: ALTHOUGH THIS MAP DOES NOT COMPLY WITH BENTON COUNTY MAP STANDARDS IT HAS BEEN ASSIGNED A COUNTY SURVEY NUMBER IN ORDER TO MAKE REFERENCE TO THE MONUMENTS SHOWN. THIS MAP WAS IN DEAN & DIANNA HANSON'S RECORDS. THIS MAP WAS DONE BY RICHARD W. FAIL.