


887

BLOCK 4

Rayburns ADDITION

CITY OF Corvallis

9th St.

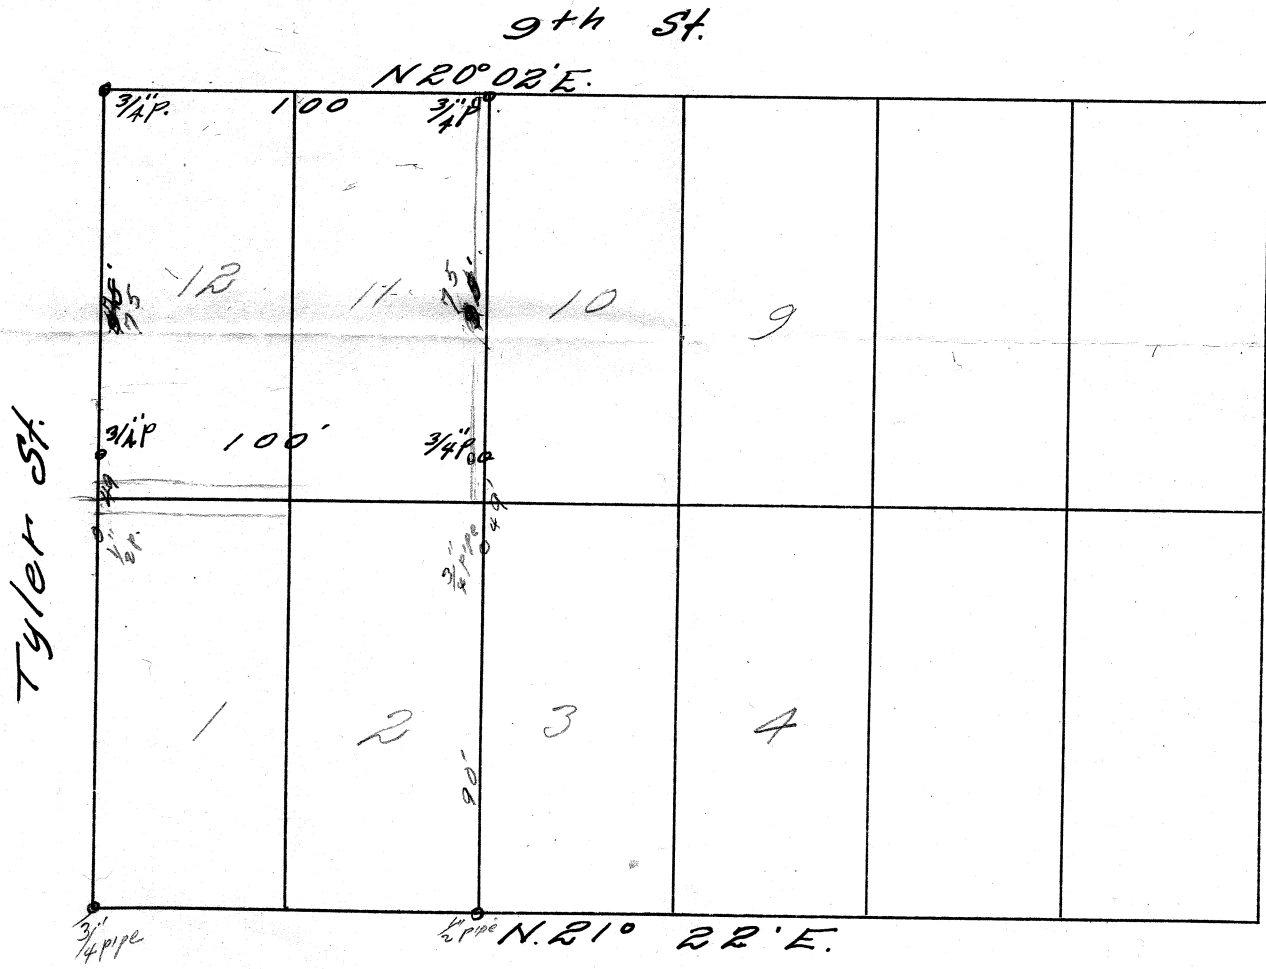

Tyler St.

Polk St.