


Dixon's 2nd Addition to the town of
Corvallis (formerly Marysville)

All the streets are 50 feet wide
All the alleys are 12 feet wide
All the lots are 50 by 100 feet

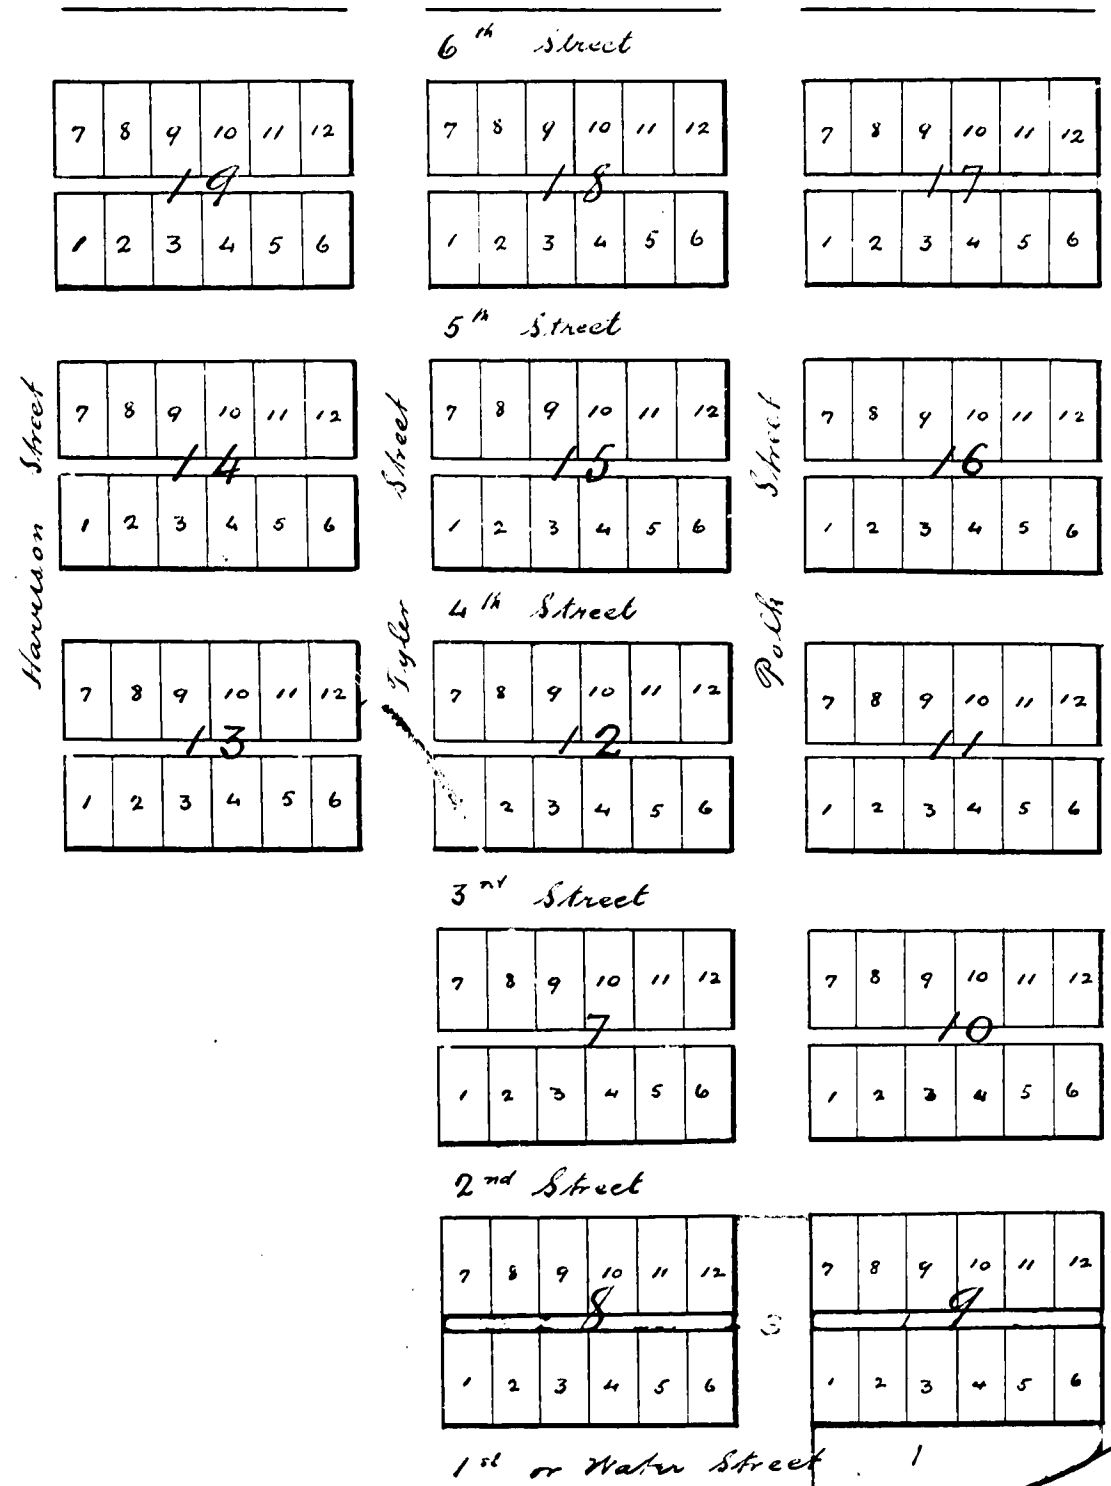

Notation No 1 Recorded in Sec 24, Page 299, Benton County, Ind Record

Personally appeared William F Dixon proprietor
of Dixon's addition to the town of Corvallis
(formerly Marysville) Benton County Or, and
acknowledged the above to be a correct plat of
Dixon's 2nd addition to said Town, this 8th day of
May A. D. 1854

Recorded May 8th 1854 By me

A. G. Hovey Recorder

May 8th 1854


Willamette River

I certify that I have compared the foregoing plat and
index with the original records of the
same, as received by me from pages 62
No. 1 of records of James Benton County, Oregon,
in compliance with an act of the Legislature of the
State of Oregon, passed Feb. 17, 1854, (see paper of 1854)
Session Laws of Oregon for 1854, and that it is a true and
correct transcript thereof, and of the whole thereof, and
that I am the legal custodian of the same. This 1st day
of July 1854.

D. W. Wilson
By [Signature] Deputy

Dixon's 2nd Addition to the town of
Corvallis (formerly Marysville)

All the Streets are 80 feet wide All the alleys are 14 feet wide
All the lots are 50 by 100 feet

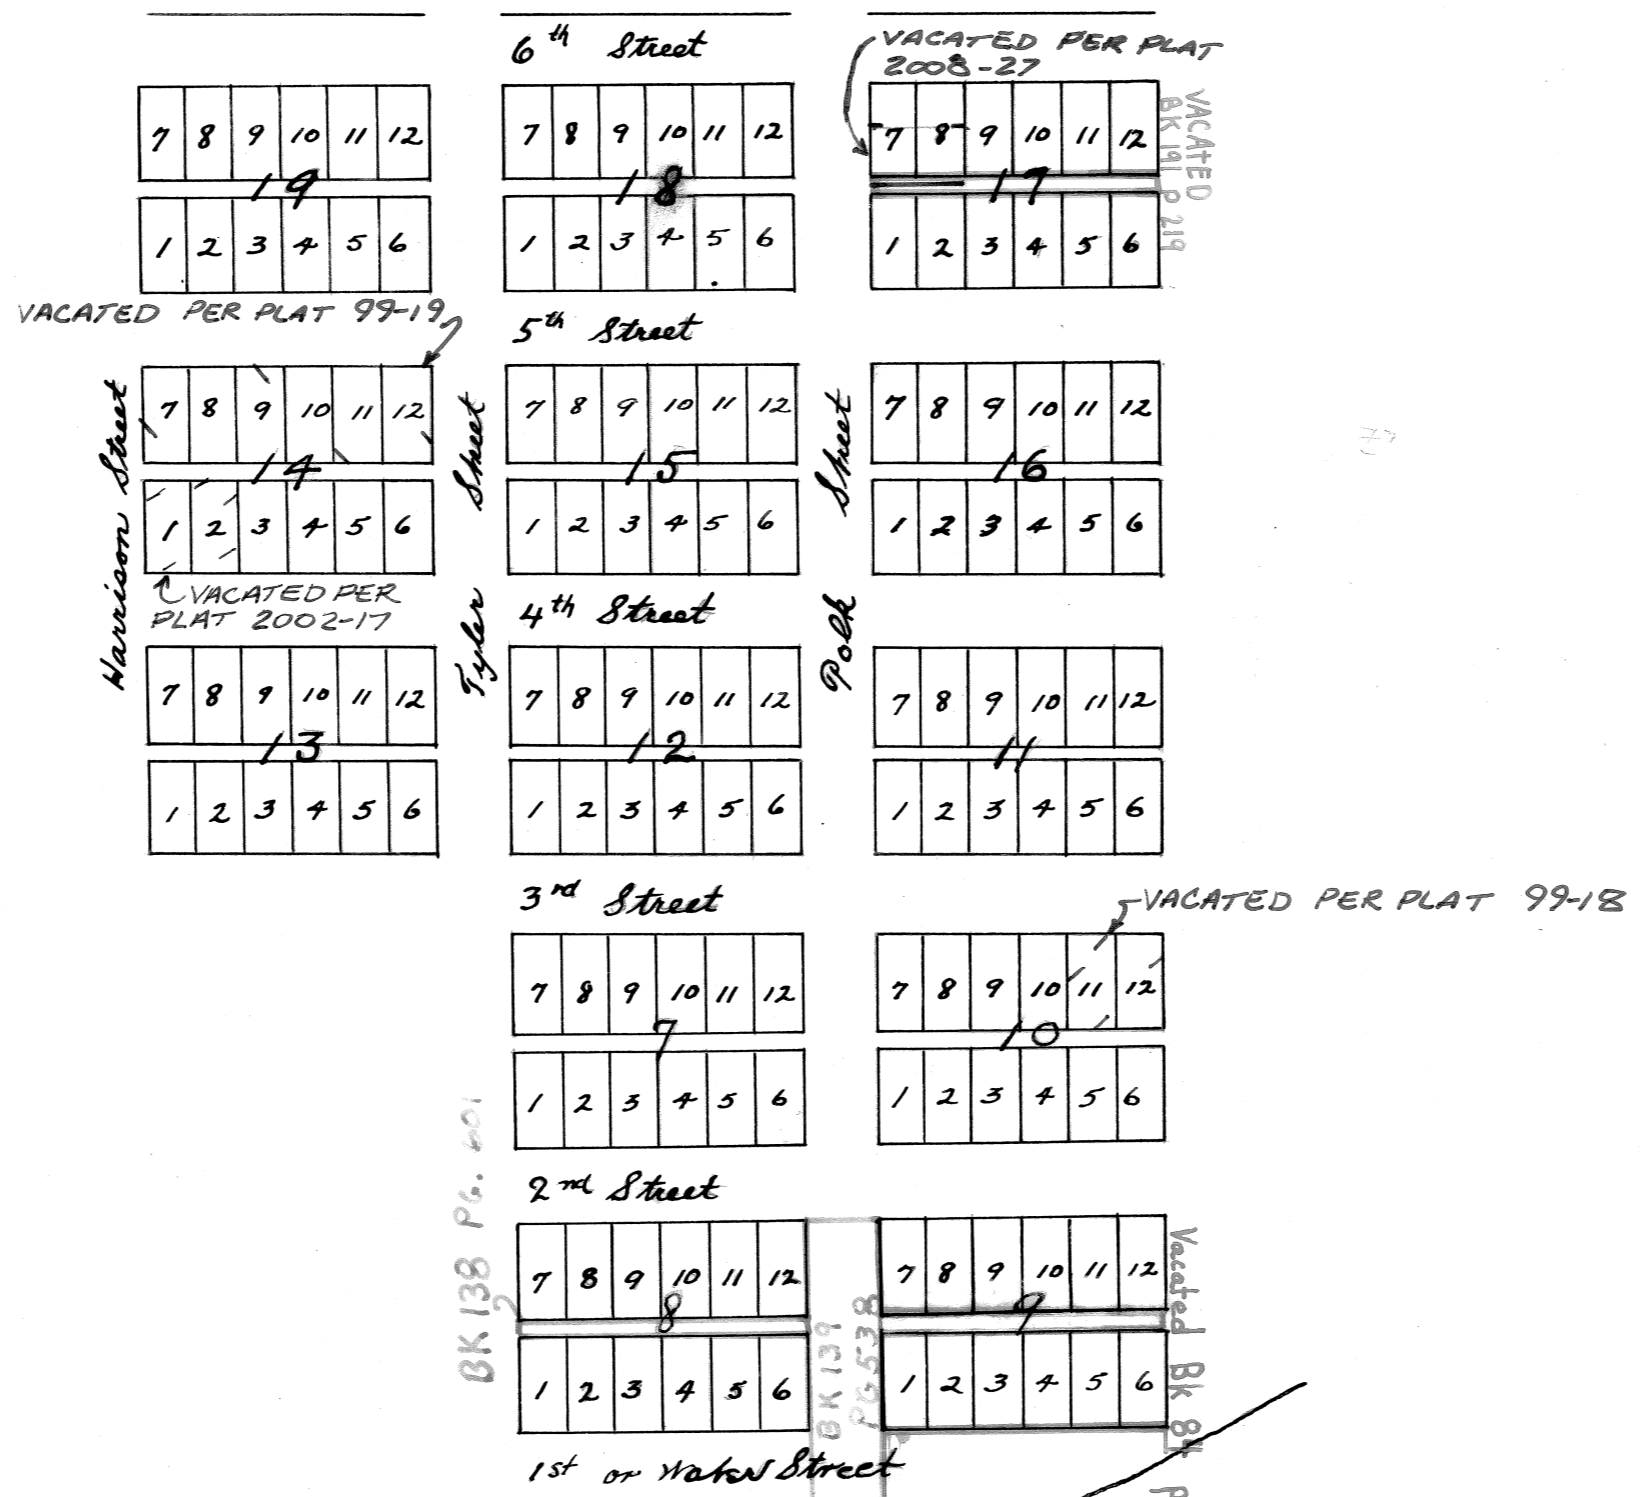

Dixon's 2nd Addition to the town of
Corvallis (formerly Marysville)

All the Streets are 80 feet wide. All the alleys are 14 feet wide.
All the lots are 50 by 100 feet

