


AVERY'S 3<sup>RD</sup> ADDITION  
TO  
CORVALLIS

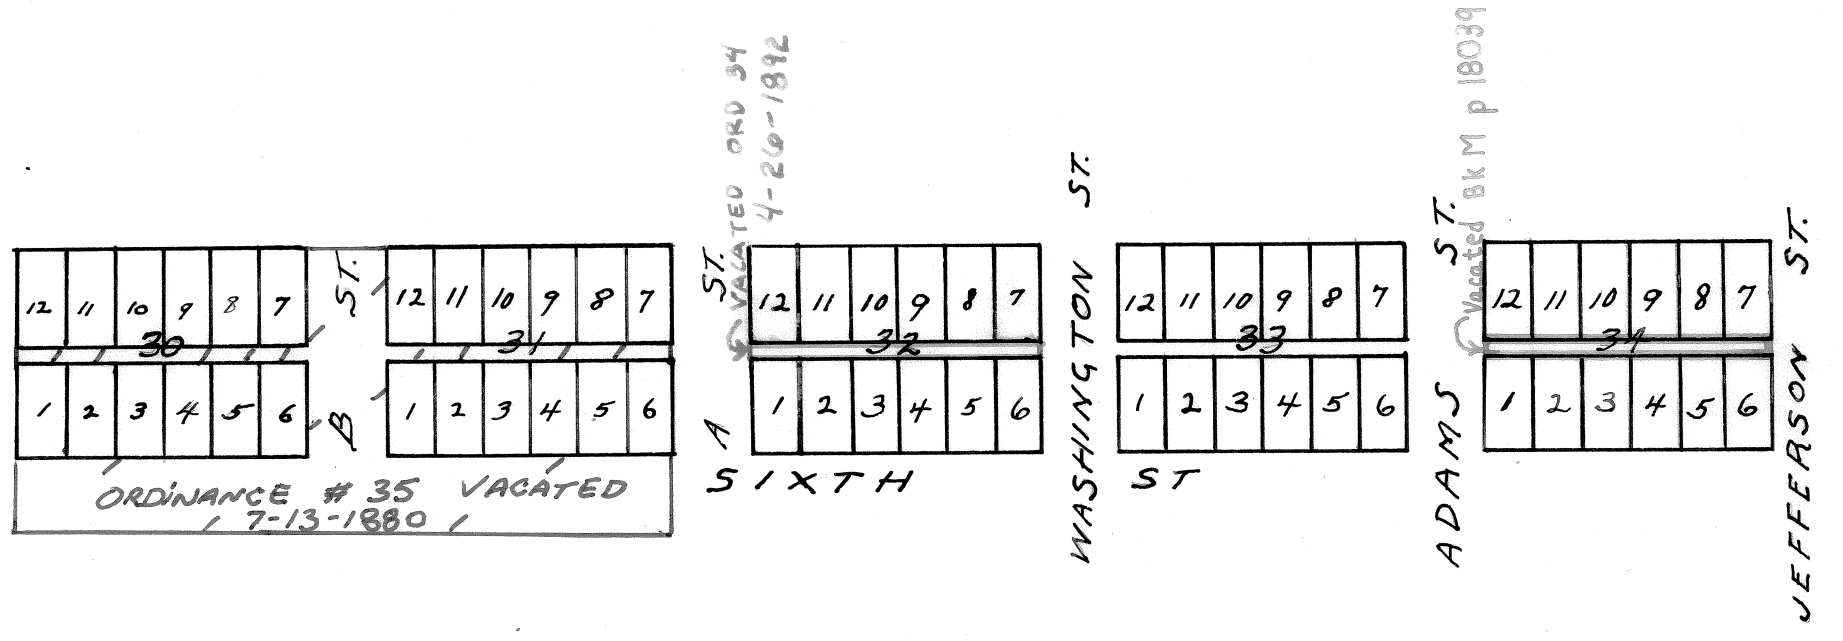


This Plat or extension lies adjoining and

# AVERY'S 3<sup>RD</sup> ADDITION

TO

# CORVALLIS

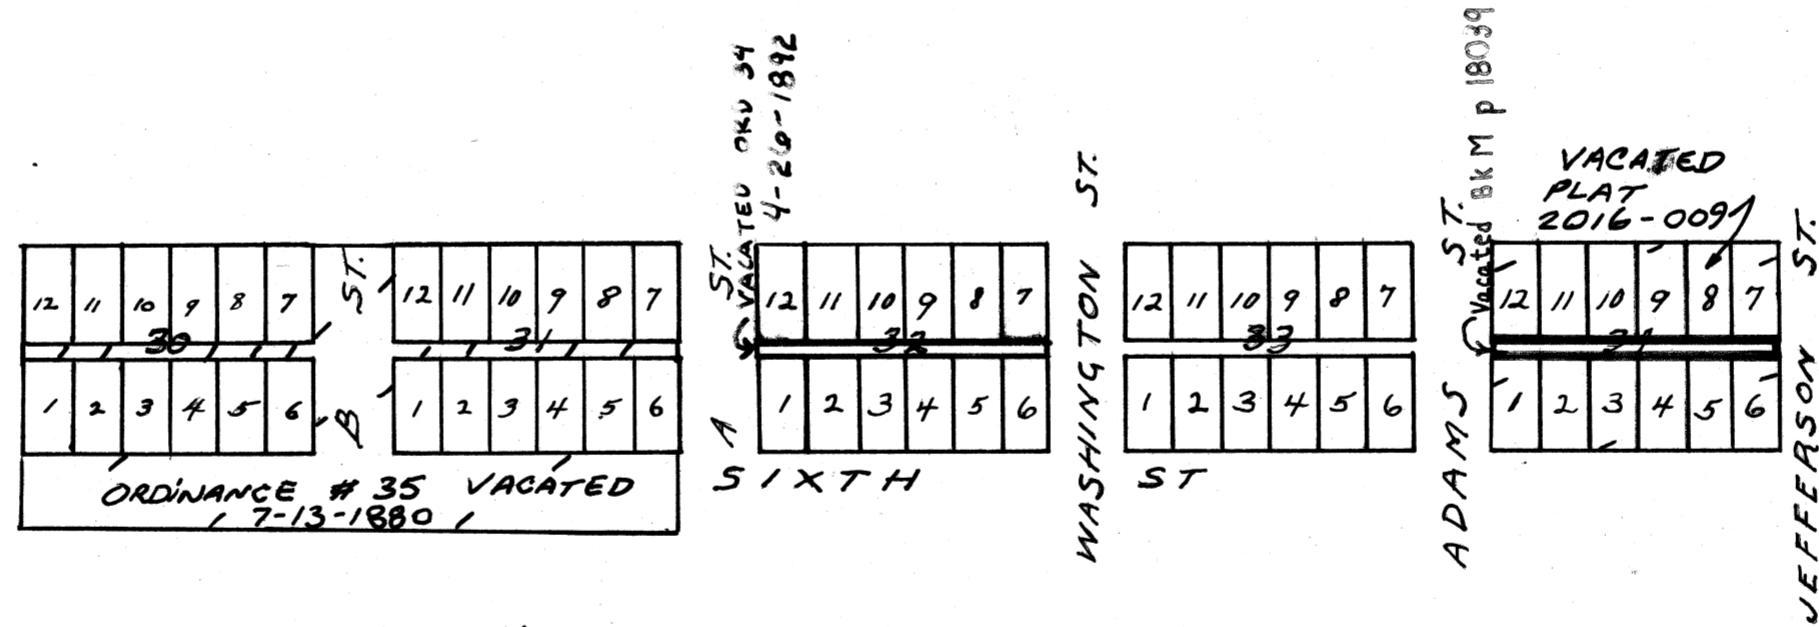


*This Plat or extension lies adjoining and west of former recorded plats - The Blocks, Lots, Streets, and alleys are the same dimensions as the former.*

# AVERY'S 3<sup>RD</sup> ADDITION

TO

# CORVALLIS

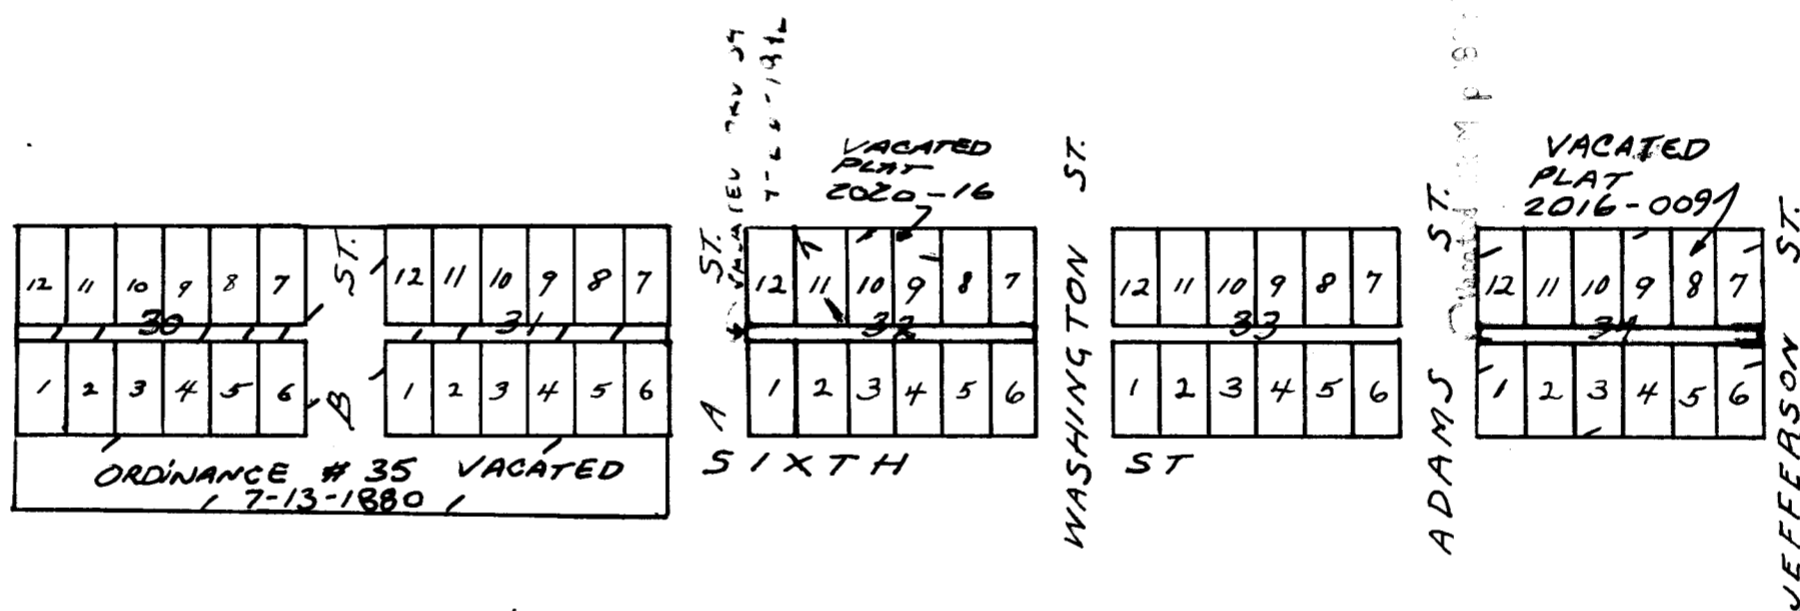

*This Plat or extension lies adjoining and west of former recorded plats - The Blocks, Lots, Streets, and alleys are the same dimensions as the former.*