


REORDER BY NUMBER 075AR
POSITION EDGE OF PRINT ON THIS LINE

PLAT AND DESCRIPTION

OF THE


TOWN OF MONROE

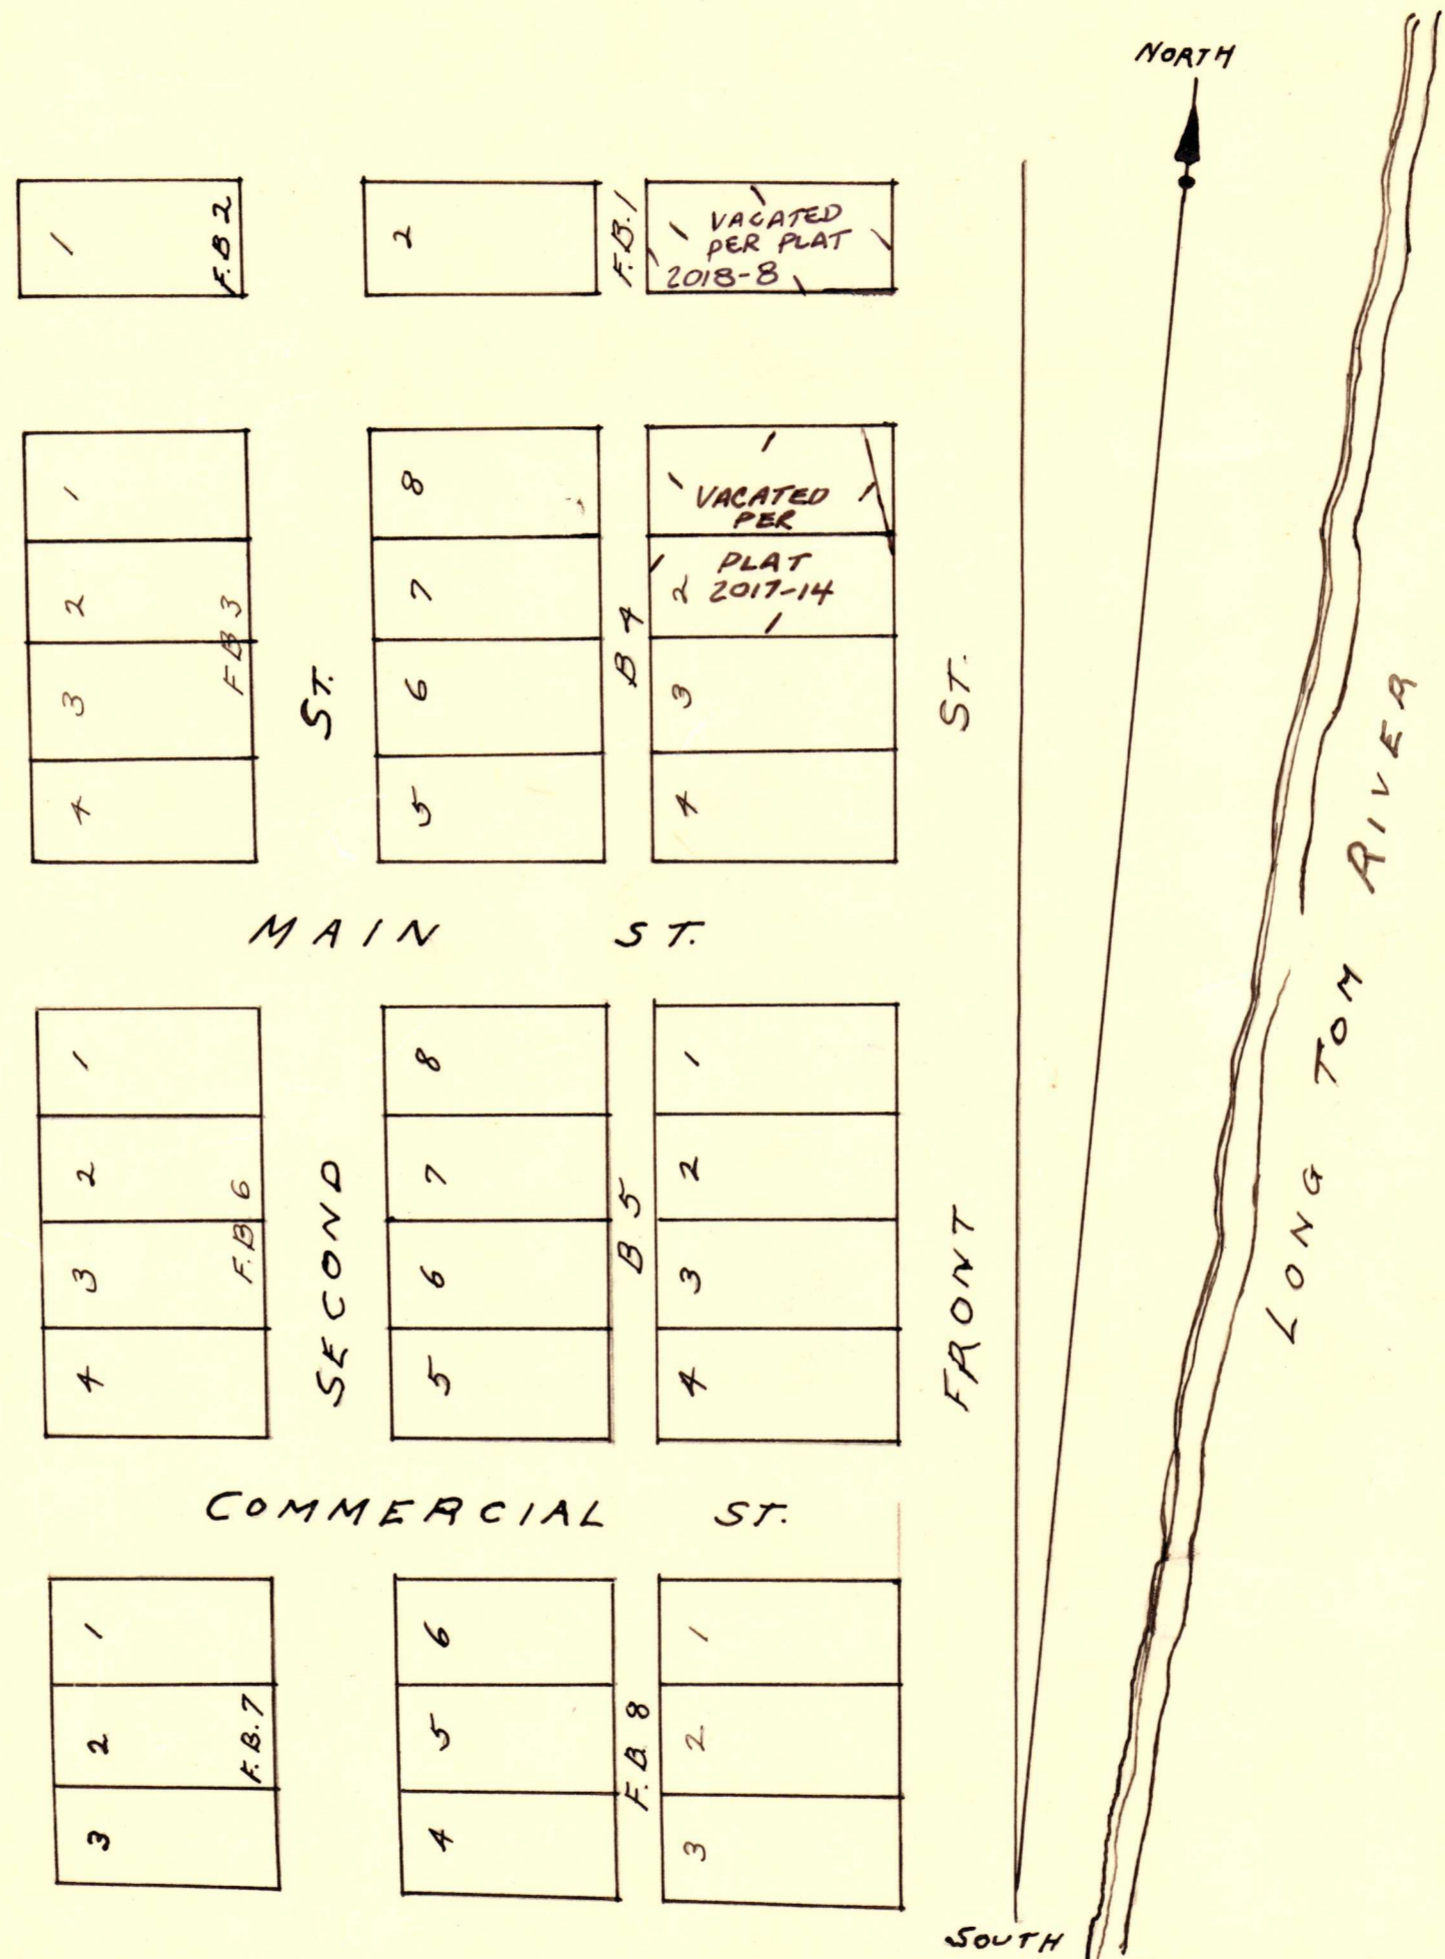

PLAT AND DESCRIPTION

OF THE

TOWN OF MONROE

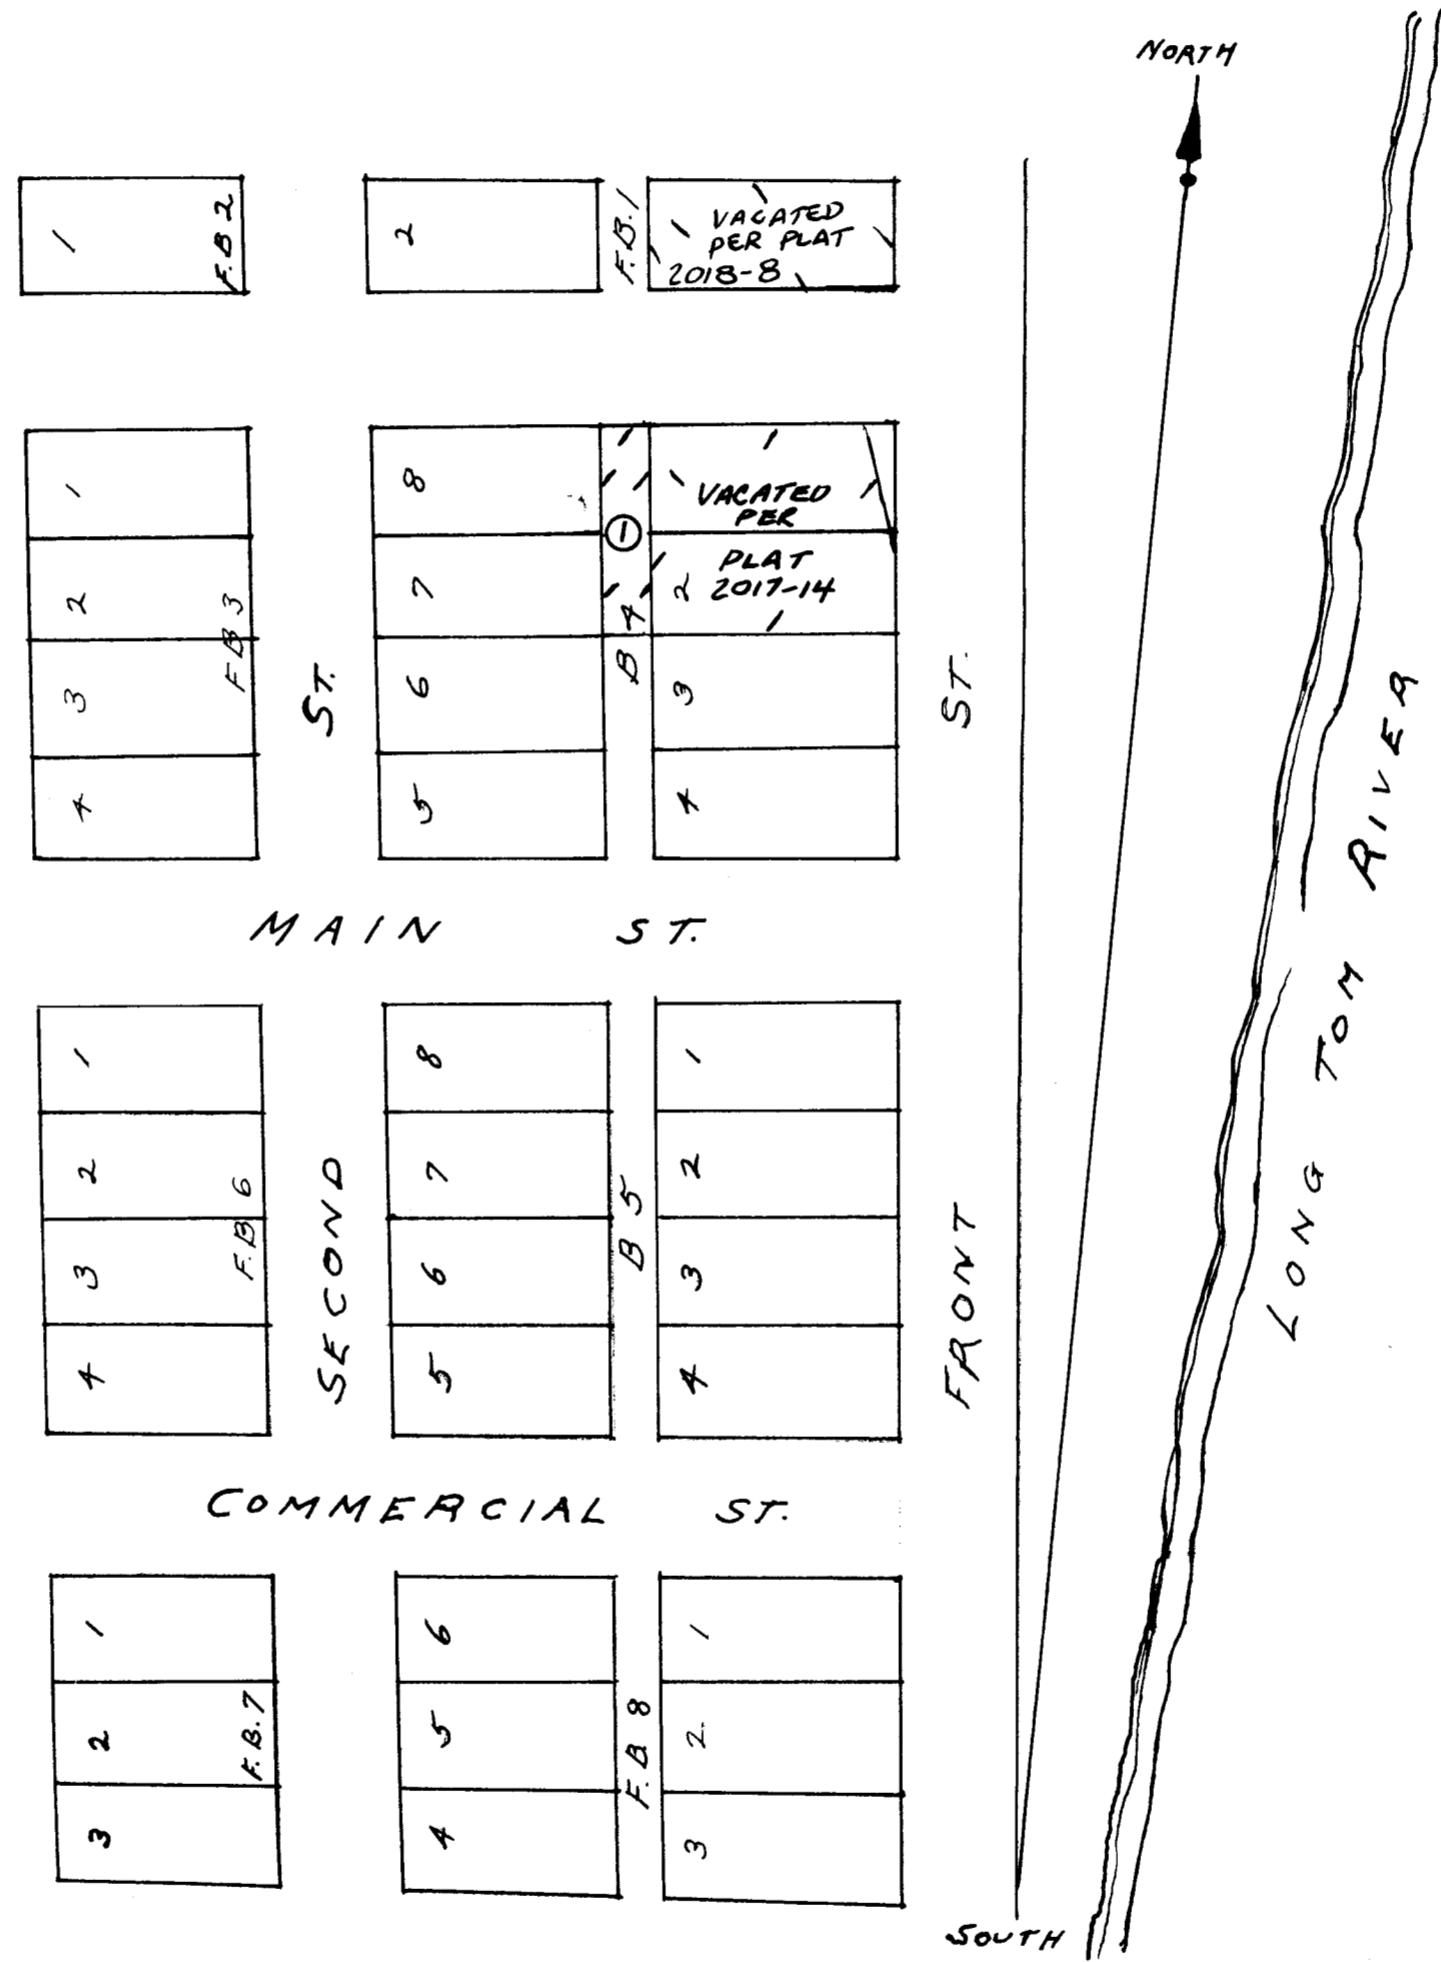

NOTES:
① VACATED PER ORDINANCE 2019-05
DEED DOCUMENT 2019-589584