


Supplemental Plat
 to
 N. B. & P. Avery's Addition to Corvallis
 (Correction)

This plat is filed to correct an error in Block #4 as platted in N. B. Avery's and P. Avery's Addition to the City of Corvallis and filed May 6th 1889 and recorded on page 70 Book 1st 2 of Towns Records of Benton County, Oregon. The only change from the original plat is in the distance across the East End of said Block, which leaves it 83 feet instead of 108 feet.

N. B. Avery
 P. Avery

Supplemental Plat
to
N. B. & P. Averys Addition to Corvallis
Benton County, Oregon
(Correction)

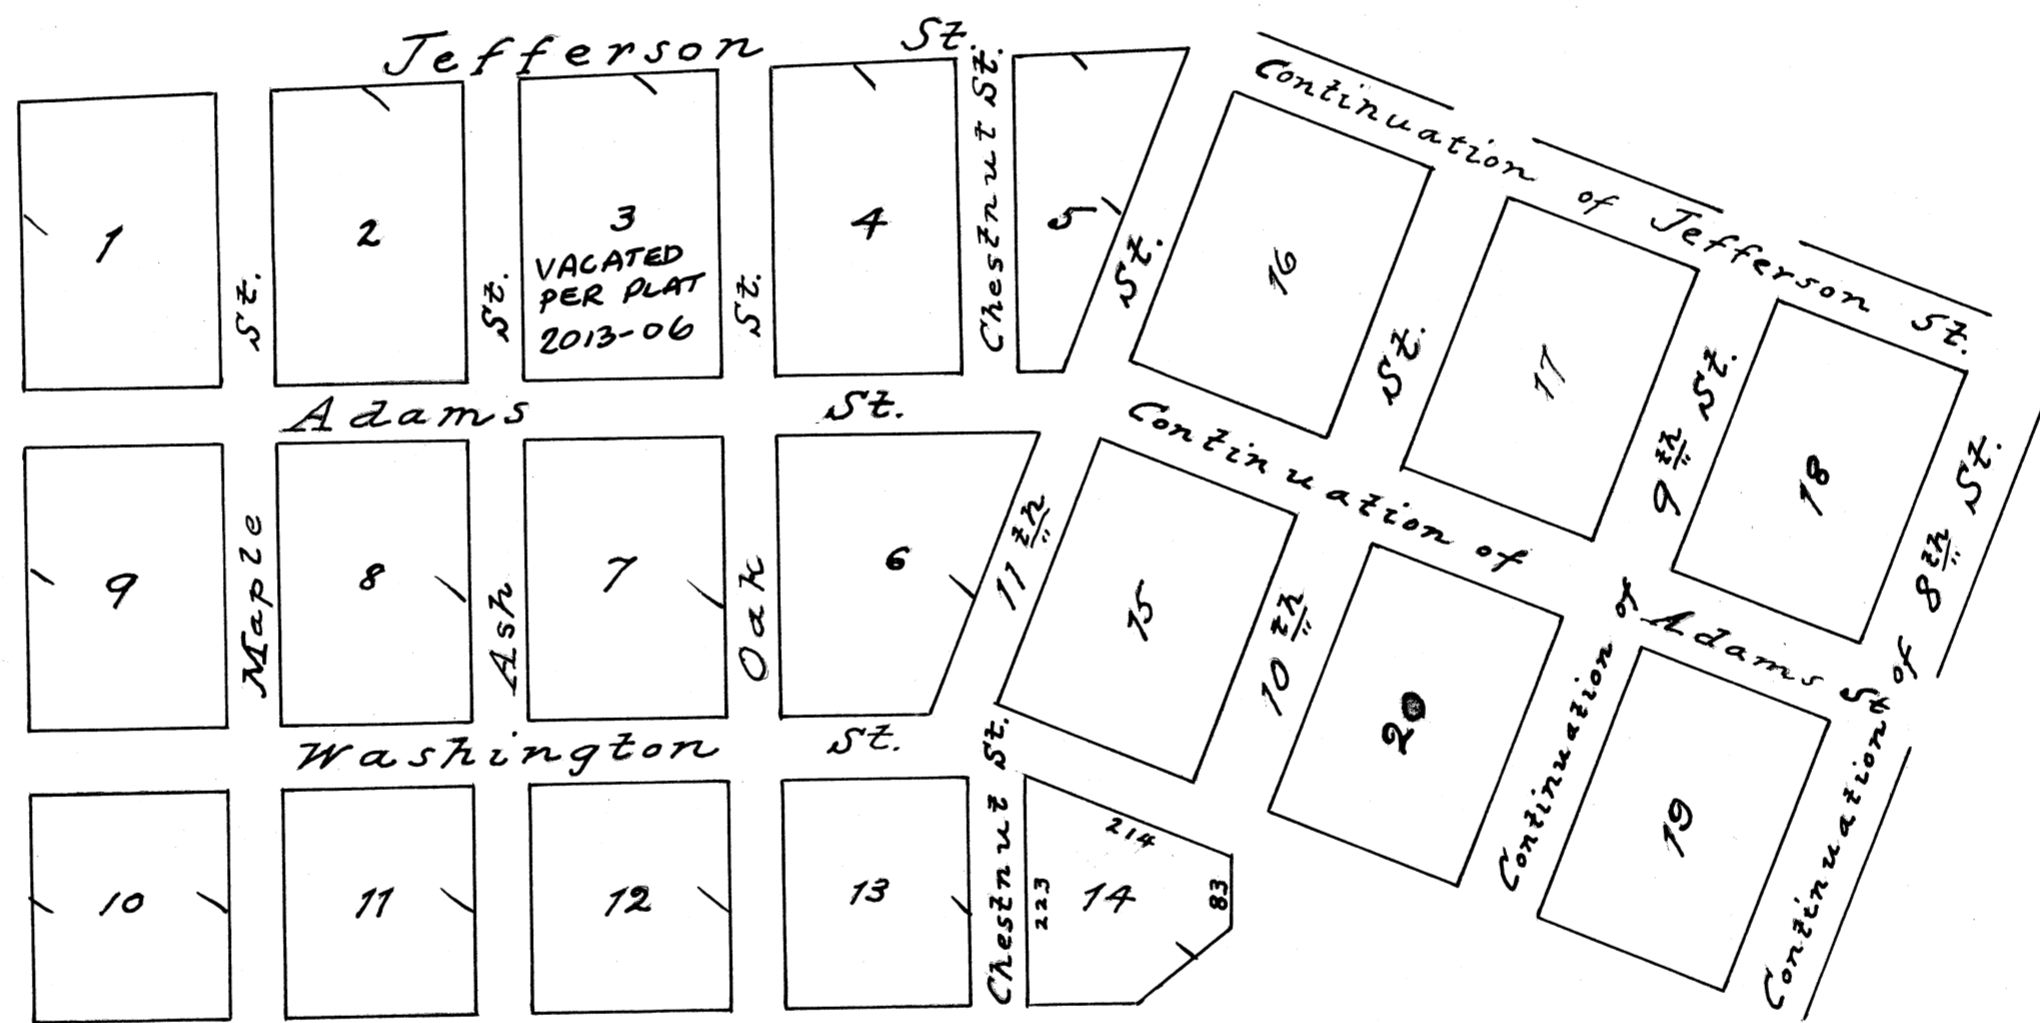

This plat is filed to supply an omission in N. B. & P. Averys' Addition to Corvallis, filed May 6th 1889 and recorded on page 70 Book N^o 2 of Towns Records of Benton County, Oregon. The only change from the original plat is in continuing the numbering of the Blocks from 14 to 20.