

Sketch Map of
C.S. 134
Sec 4 & 5, T105 R5W
FB 83-110-5
No Scale
for Brinkley


Sep. 19
1932

SURVEY IS IN
POLK COUNTY.
1188 BSA 2/10/2017

118

10-5
3, 4, 9, 10

C.S. 134
Scale - 1" = 10 chs

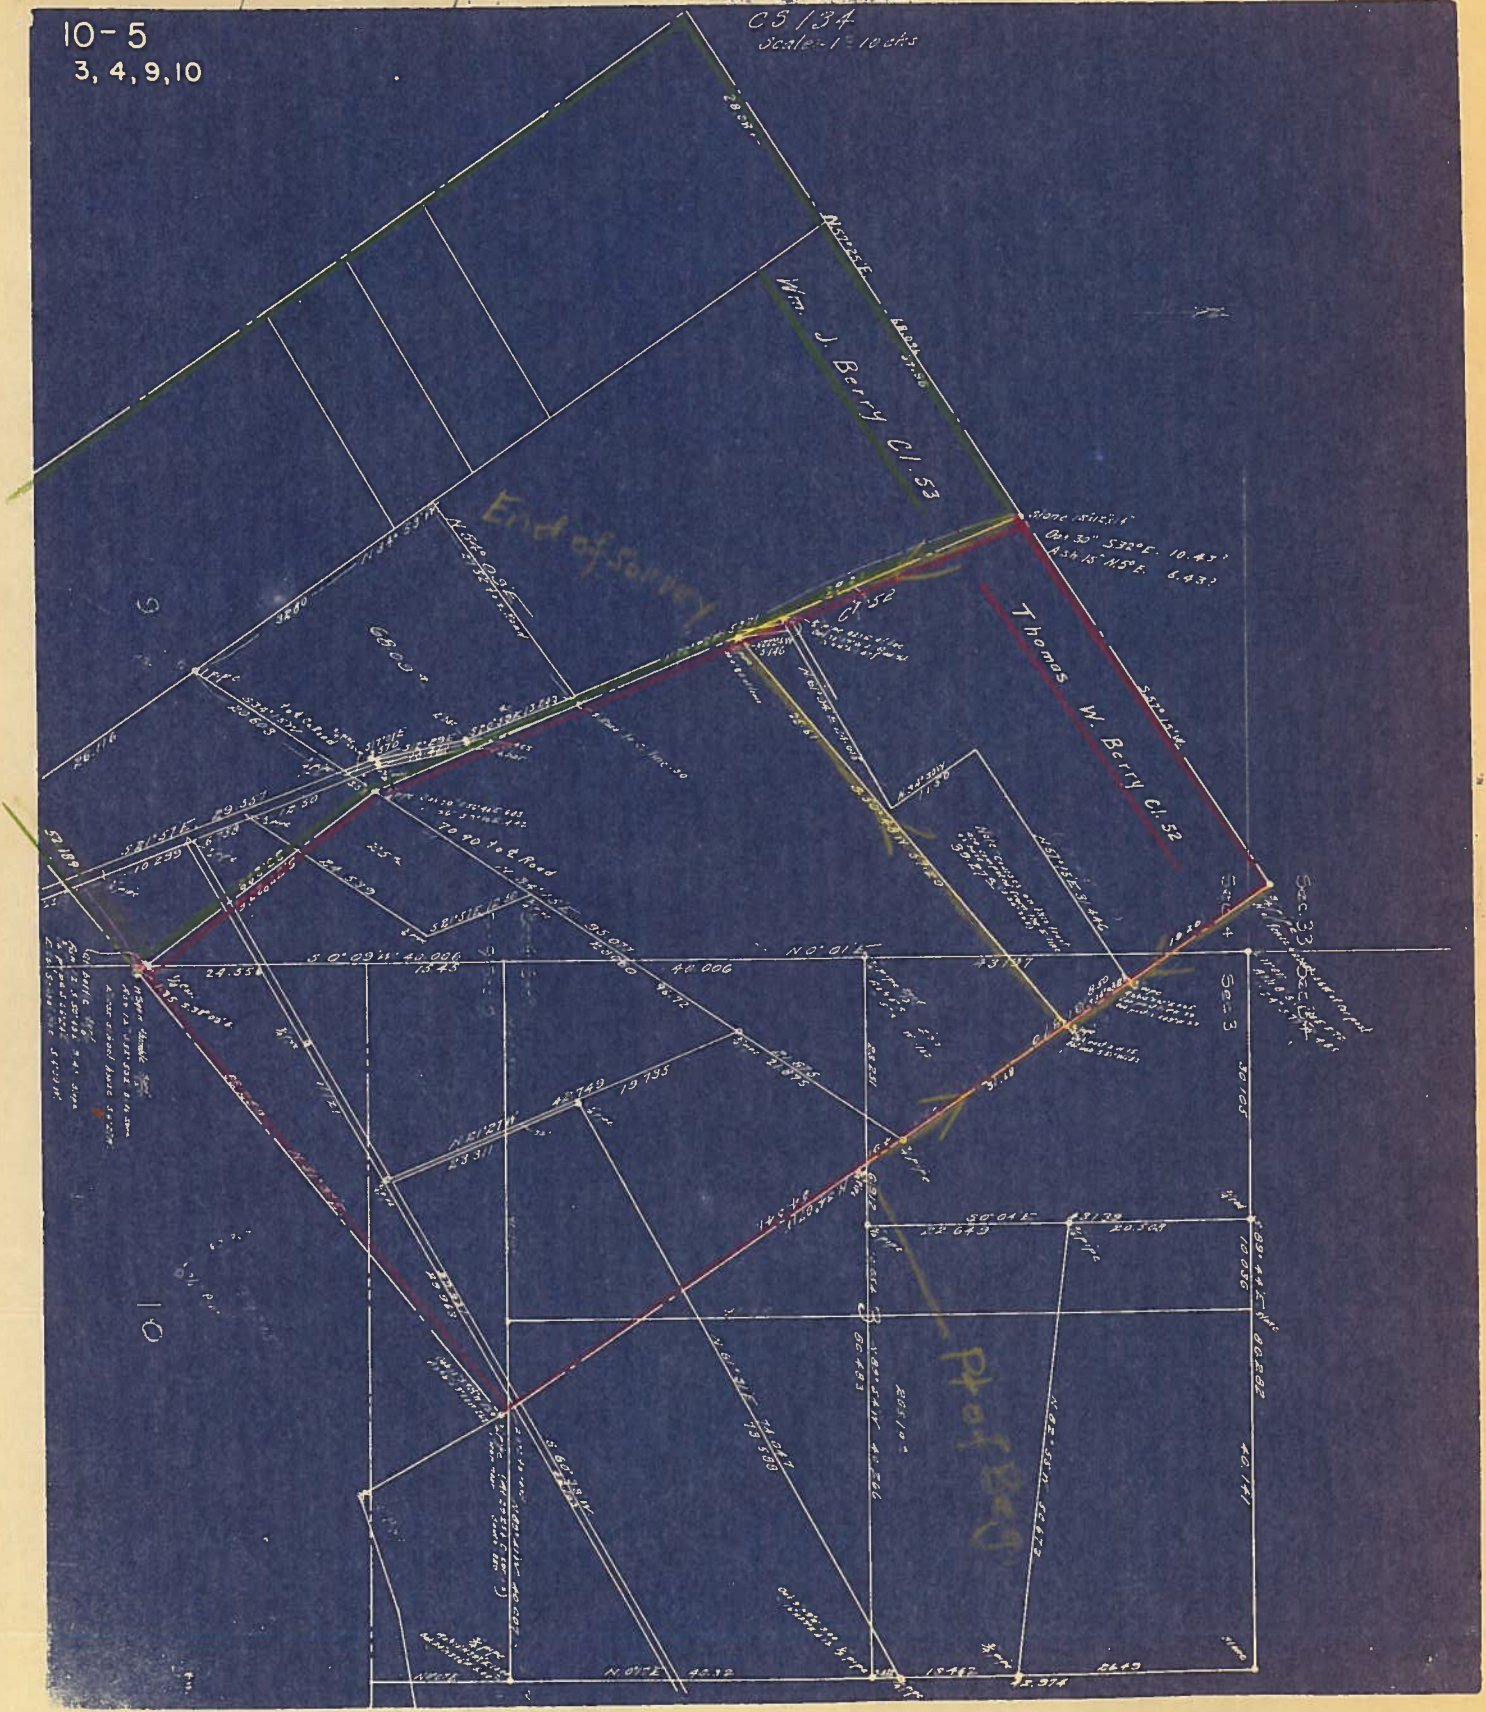

10-5

Book 83

10-5

B

Began at N.W. cor Thos. W. Berryel.

500

5000

4.164

3.460

5.000

3.740

5.860

2854

10572

4.990

156

10707L

Kind E

52205'E

correct 0°19'E

= 522°24'E

0°28' sight on angle of cl.

29.218 - 008

Set .0261

1/2 P.P. - Oct 20th 1874?

Oct 16th Nov 14.7

Set .016W

1011

10707L

Set 3/4" pipe

Note:-

When surveying around here be sure and get permission to cross land from the black eyed lady on the hill.

93

52654

100814

210616

52654

441232

4286035

29.21

26.356

2.854

00543

00543 = 0°19'1

79008

22860

34090

385100

576072

190180

2921

544

17584

14505

1589024

014

135

24.75

25.60

50.35

25.18

2.88

20.44

20.44

50.36

7.35184

5.60

5.15

5.75

2.88