


Survey Vol #1

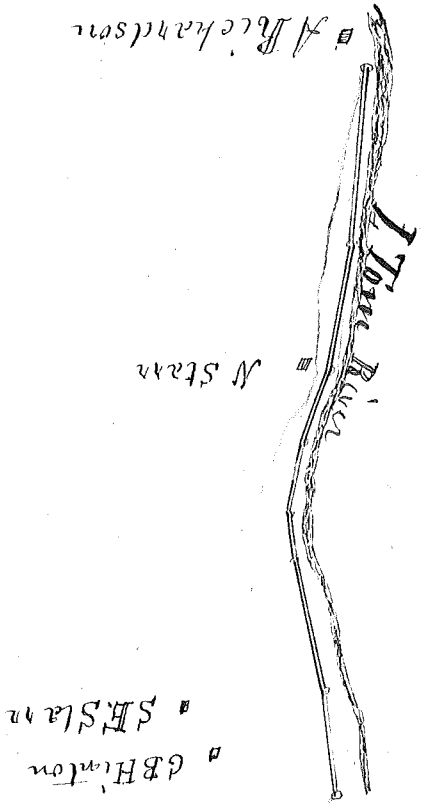

Of an attraction of the Territorial Road leading from Corvallis to Isles in Unipqua Beginning at a point in the center of the road on Aaron Richardson farm from which a white oak tree 30 inches in dia. bears S 76° 30' E 1.11 chs distant.

Courses	Distance	Notes
S 6° W	36.30 chs	Set a post
S 12° 30' W	28.00 "	" " "
S 20° 30' W	15.70 "	Set a mile post - 30 feet to the W. of the center Road
S 11° W	13.50 "	Set a post
S 6° 30' E	10.00 "	" " "
S 11° 30' E	27.00 "	" " "
S 6° 30' E	22.00 "	Set a post the terminus intersecting with the Territorial Road. (distance of the Survey) one mile 70.50 chs in length by 60 feet in width

Oregon Territory
Benton County

I hereby certify that on
the 12th day of July A.D. 1855, I surveyed an
alteration of the Territorial Road leading from
Corvallis to Estis in Ampqua by the direction
of C. B. Hinton and White as witness assisted
by S. F. Starr and A. W. Starr who were duly qualified
as chainman and A. A. Starr marker and caused
same to be properly marked throughout and
that the foregoing plat and notes are correct
of said Survey

L. A. Davis

County Surveyor

Road
Ampqua
of the
which
S 76° 30'

the Road

secting
urvey
th