

C.S. # 1019

See notes in file

F.B. 37-21

37

PASTS

FIELD BOOK

No. 385

W W

1019

BIKS 3 & 4 WELLS & WELTONS ADD.

25.69 161 70'
 2.947 2.713 N 0° 07' W
 102 R. ROAD
 4.964 100' N 0° 55' E
 8.462
 3.840
 6.834 11.167 5
 90°

404 E
 90° R
 " N 0° 55' E
 50' 3/4" PIPE 132 E. 072 E
 89° 10' R
 589.55' E
 589.56' E

10.251
 7.271
 2.690
 2.769

22.981


96° 06' R in ang to cor X
 to hub S. 223 to hubs
 16° 32' R 56° 10' R

655
 2.357
 2.765
 2.330
 25.535
 655

26.490
 from nail in bridge rail to cor in E Roads - N.
 from cor. in E Roads N to ang in road S.

26.490

B. 1. 3-ARNOLD HEIGHTS

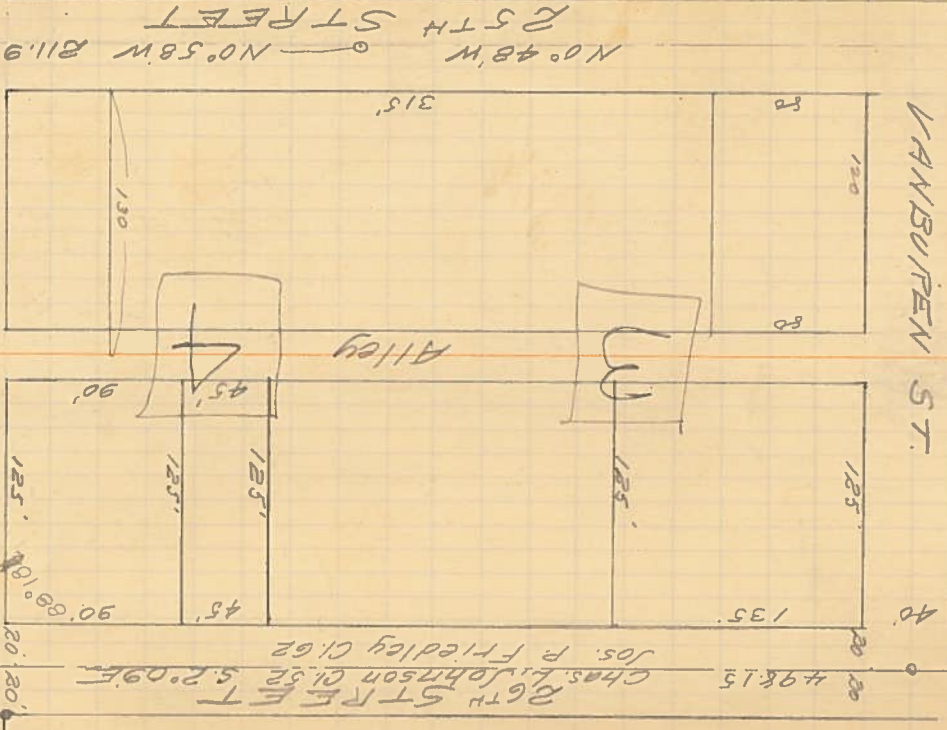

N 0° 48' W
 N 0° 58' W 811.9
 25TH STREET

498.15
 135
 125
 125
 125
 125
 135
 130
 90
 45
 45
 90
 90° 08' 10"

Chas. K. Johnson Cl. 52 S. P. 09 E
 Jos. P. Friedley Cl. 62

5: 89° 32' W
 HARRISON ST.
 918.45

VANBUREN ST.

135
 125
 125
 125
 125
 135
 130
 90
 45
 45
 90
 90° 08' 10"

Chas. K. Johnson Cl. 52 S. P. 09 E
 Jos. P. Friedley Cl. 62

5: 89° 32' W
 HARRISON ST.
 918.45

VANBUREN ST.