

CS 10196

FILING DATE 12-28-2006

FOR:	SAMUEL STARR
NOTES:	FIELD BOOK 76, PAGE 7
SURVEYOR:	W.C. GALLOWAY
DATE STARTED:	OCTOBER 8, 1930
LOCATION:	T14S, R6W, SECTION 12

14-5


Book 76

Book 76

14-5

Samuel Start
N.W. Cor Polly Bellmap Pl.
3/4" pin - 1 1/2" 20'E
S.E. Cor N of W 1026


(79.07)

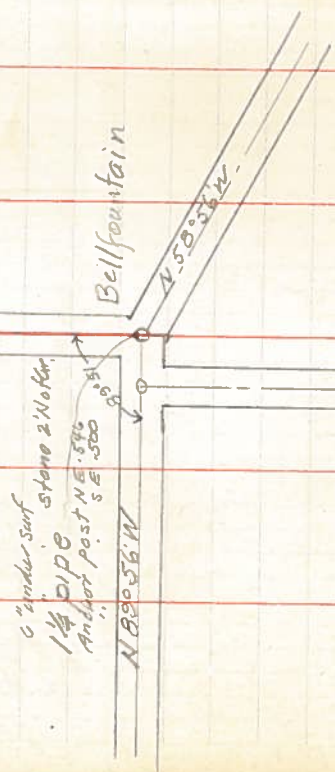

CS 10196

N.W. Cor. Henry Noble stone under 3/4" pipe
Dist 20" S 25° 35' E 1.67 Dist 12" S 5° 24' W 8.13
N.E. Cor John H. Knoss & 1/2" pipe
Dist 18" N 7° 15' E 4.49 Fort Dist 14" S 41° E 8.65
Dist 15" S 50° 30' W 2.48

N.E. Cor P. Bellmap Dist 24" N 85° E 36-Dist 18" S 58° W 1.15-16.3
10" N 6° W .55 6.5
N. Cor N 80° 07' E Dist 19" S 10° 24' W .062
16 16 4 16 16

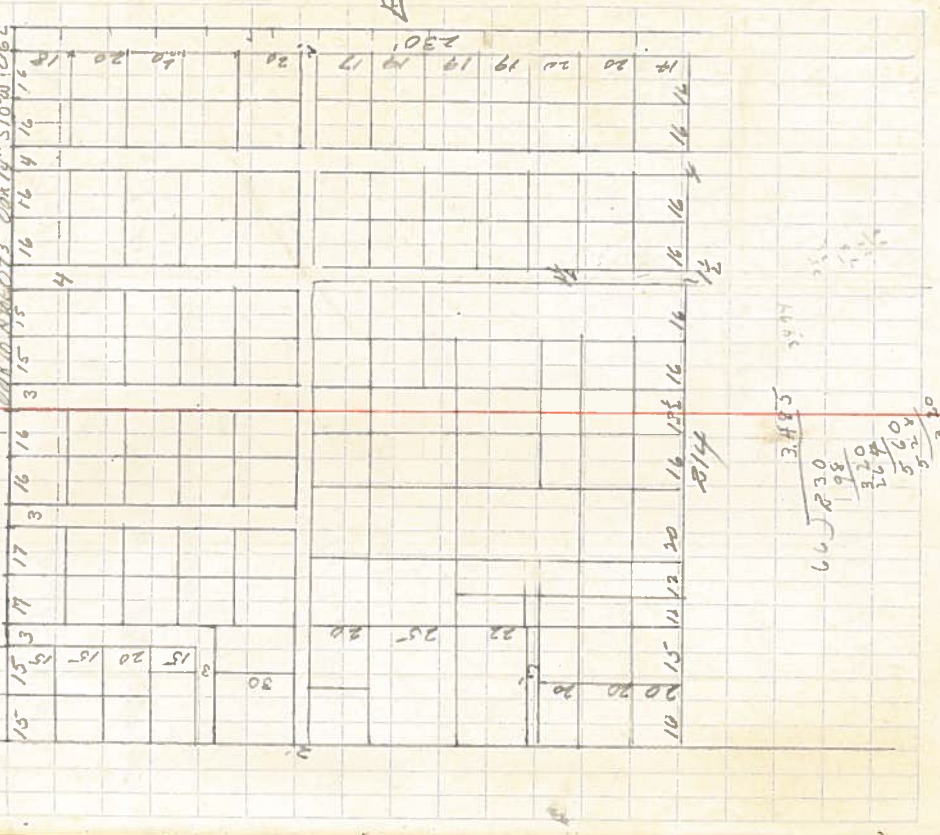

66) 230
198
322
564
3 20