

C.S. # 1064

Hardcopy 13-6 # 16

also see notes in file

F. B. 72-6

Floyd F Kuzman  
CS 334  
Began at A.  
South

F/B #72, PG 6-10

1064

+21010  
3.169 2.955  
+60120  
1.233 1.225  
-7810  
2.233 2.215  
-15720  
3.663 3.533  
-20330  
4.985 4.667  
4.997 4.994

Sid  
South .010 W  
.014 W  
.022 W  
.034 W  
.050 W  
.067 W  
+20 Cr

20.026  
9.589  
Set 49.85  
070 W  
S1°08' E  
come off 10.10  
= 50.053  
40.053

+7540  
4.960 4.937  
+6120  
4.961 4.931  
+100  
4.545 4.476  
4.950 4.950  
1.170 1.170


Correct 0°12' W  
138 W  
137 W

hit .137 E of Cor.  
Set 2" angle Iron

+10  
4.772 4.700  
-1520  
1.999 1.986  
3.675 3.587  
2.540 2.540  
2.120 2.103

89°58' L  
N89°0' E  
correct 50's  
= N89°53' E  
-1.404 RR  
+1.30 RR  
1.565  
1.955

2285

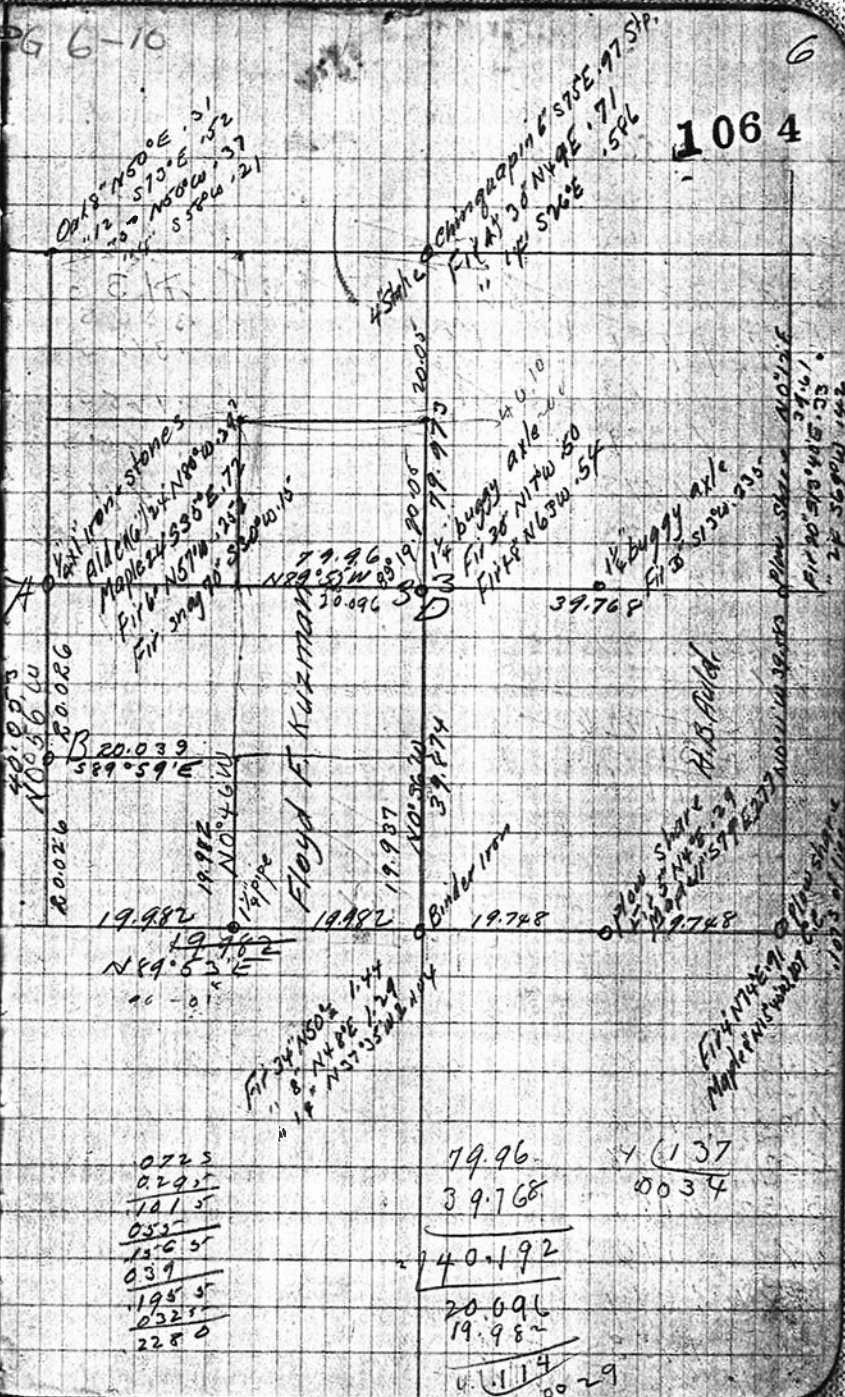

0225  
0295  
1015  
055  
1565  
039  
1955  
0225  
2280

19.96  
39.768  
140.192  
20.096  
19.982  
4.1114  
0029

1137  
0034

14,856 carry

<sup>+20°20'</sup>  
~~2.640~~ 2.473  
<sup>+11°30'</sup>  
~~2.286~~ 2.240  
<sup>+4°40'</sup>  
~~4.967~~ 4.951  
<sup>+4°10'</sup>  
~~4.793~~ 4.643  
<sup>+11°20'</sup>  
~~1.394~~ 1.389  
<sup>+11°20'</sup>  
~~1.473~~ 1.473  
<sup>-6°45'</sup>  
~~2.060~~ 2.030  
<sup>-12°15'</sup>  
~~2.572~~ 2.513  
<sup>-15°10'</sup>  
~~3.467~~ 3.376  
~~39,826~~  
~~19,913~~  
~~39,826~~  
~~19,913~~  
~~39,963~~  
~~19,981~~

19,569  
~~19,483~~  
~~31,163~~  
~~1,413~~

sid. 266S  
~~2418E~~  
~~300S~~  
~~376S~~  
~~448SV~~  
~~468SV~~  
~~491SV~~  
~~522SV~~  
~~573S~~  
~~624S~~

~~228~~  
~~038~~  
~~266~~  
~~0545~~  
~~5005~~  
~~076~~  
~~3745~~  
~~0715~~  
~~4480~~  
~~0203~~  
~~4688~~  
~~0227~~  
~~4910~~  
~~0314~~  
~~5224~~  
~~0385~~  
~~5609~~  
~~012~~  
~~5729~~  
~~051~~  
~~624~~

<sup>3076</sup>  
~~1845~~  
<sup>27008</sup>  
~~13504~~  
<sup>27008</sup>  
~~3376~~

9828  
~~0245~~  
~~01214~~  
~~3982~~  
~~01540~~  
~~0°53'~~

Began at D  
 West on true  
 line - nearly

<sup>-110</sup>  
~~2.433~~ 2.388  
<sup>-190</sup>  
~~1.567~~ 1.482  
<sup>-6°</sup>  
~~2.201~~ 2.188  
<sup>-10</sup>  
~~3.130~~ 3.082  
~~470~~ 470  
<sup>-50</sup>  
~~2.290~~ 2.279  
<sup>-540</sup>  
~~1.470~~ 1.453  
~~13,042~~



13.042

$\begin{array}{r} 5.000 \\ 3.330 \\ 3.000 \\ 2.000 \\ 5.000 \\ 2.40 \\ 2.60 \\ .842 \\ 3.485 \end{array}$ 
 $\begin{array}{r} 4.708 \\ 3.222 \\ 3.000 \\ 1.990 \\ 5.000 \\ 2.376 \\ 2.593 \\ .842 \\ 3.418 \end{array}$

$\begin{array}{r} 20.972 \\ 20.096 \\ .876 \end{array}$

$\begin{array}{r} 19.216 \\ .876 \\ 20.092 \end{array}$

$\begin{array}{r} 2 \overline{) 40.192} \\ 20.096 \end{array}$

Back to B

$\begin{array}{r} .067 \\ 4.967 \\ 4.985 \\ 1.952 \\ 4.968 \\ 3.345 \end{array}$ 
 $\begin{array}{r} 4.967 \\ 4.985 \\ 1.946 \\ 4.887 \\ 3.246 \end{array}$

587°52'E

"

"

589°59'E

$\begin{array}{r} -060 \\ 20.098 \end{array}$

20.038

Set 1/4" pipe

$\begin{array}{r} 1.968 \\ 2.009 \\ 1.850 \\ 3.760 \\ 4.880 \\ 2.391 \\ 1.456 \end{array}$ 
 $\begin{array}{r} 2.009 \\ 4.769 \\ 3.760 \\ 4.877 \\ 2.386 \\ 1.444 \end{array}$

51°58'W

54°08'E

52°12'W

50°30'E

"

"

19.215

set  
 $\begin{array}{r} .229W \\ 2.76W \\ .274W \\ .078W \\ .055W \\ .044W \\ .037W \end{array}$

029W

026W

055W

000

027E

043E

1°12'E

3 22'E

20 58'W

0°16'N

"

"

$\begin{array}{r} .069E \\ 0.40W \\ .029E \\ 3.42E \\ .371E \\ .095W \\ .216E \end{array}$

$\begin{array}{r} .276E \\ 0.76W \\ 1.45W \\ .055E \\ 0.42E \\ .097E \\ 0.97W \\ 0.000 \end{array}$

$\begin{array}{r} 0.44W \\ 0.21E \\ 0.21W \\ 0.29W \\ .056W \\ 0.12E \\ .043W \\ 0.15W \\ .058W \\ 0.97E \\ 0.57W \end{array}$

$\begin{array}{r} 069E \\ 342E \\ 411E \\ 145W \\ 266E \\ 042E \\ 308 \\ 021 \end{array}$

$\begin{array}{r} 437 \\ 153 \\ 284 \end{array}$

$\begin{array}{r} .0366 \\ .1830 \end{array}$

should be 589°59'E - 20°07'E

$\begin{array}{r} 195 \\ 366 \\ 561 \\ 170 \\ 71 \end{array}$

$\begin{array}{r} 4.377 \\ 3.606 \\ 79.152 \end{array}$

$\begin{array}{r} 60.09 \\ .042 \\ .232 \\ .274 \\ .196 \\ .098 \\ 1.96W \end{array}$

$\begin{array}{r} 327 \\ 013 \\ .342 \\ .007 \\ 349 \\ 549 \\ 053E \\ 140B \end{array}$

19.245

-16° 10'  
770

739

~~9.984~~  
9.984

50°30'E

.053W of Cor

.034W

Set on NE cor of NW 1/4 of SW 1/4

+8° 20'  
4.950

4.897

N0°30'W

+7°  
1.40

1.390

"

+7° 30'  
3.537

3.448

"

#  
+12°  
R. 590

2.559

S0°19'E

+4°  
1.414

1.410

S1°21'W

-10° 20'  
3.710

3.648

50°30'W

+13°  
3.770

2.689

~~1735~~

Set 1/2 pipe

4.940

4.940

N89°53'E

1.961

1.958

N89°47'E

+11° 40'  
4.225

4.138

East

+5° 20'  
1.168

1.160

"

-8° 20'  
1.828

1.808

S89°43'E

+6° 10'  
4.727

4.085

East

+5° 30'  
1.928

1.908

4.089

19.997

20.7  
20.7  
20.05  
7.35  
2.70

25.6  
25.6  
20.7  
20.7  
25.6  
25.6  
20.7  
20.7  
Δ Fir 30" S16°E .38

.540 s of hub should be 564



# Survey for School lot

Began at pt.  $R. 223$  N of  
 plow share on S line  
 of sec 33 19.748 W of S.E. cor.  
 Sight on hub across Road  
 N

$106^{\circ} 23' R$   
 $574^{\circ} 13' E$

$-5.040$   
 $4.990$   $4.966$

$5.000$   $5.000$

$4.630$   $4.612$   $14.678$

$19^{\circ} 39' L$

$-4.0$   
 $R. 550$   $R. 543$

$734' R$

N.W. cor School lot

N.E. cor School lot

$2.021$   
 $2.321$   
 $2.519$   
 $2.717$   
 $2.915$   
 $3.113$   
 $3.311$   
 $3.509$   
 $3.707$   
 $3.905$

$106.23$   
 $N 0^{\circ} 30' W$   
 $105.47$   
 $574.13 E$

$R. 543$   
 $3932$   
 $5086$   
 $7629$   
 $228.27$   
 $7629$   
 $9999076$

$R. 543$   $1.00000$   
 $3.932$   $96.89$   
 $23710$   
 $22887$   
 $8230$   
 $7629$   
 $6010$

$36''$  Fir CS.R N70°E 1.830

CS.R Oak 11" N32W .845

$36''$  Fir CS.R NW .92 from cor

