

C.S. 945A
Block 4, Wilkins' Add.

W. C. GALLOWAY
COUNTY SURVEYOR & ENGINEER
OF BENTON COUNTY

CORVALLIS, OREGON

May 5, 1948

Survey for David C. Fendall



by W. C. Galloway C.S.

Benton County
Surveyor's Office

C.S. FILE NO. 10783

FILING DATE 9-30-16

FILE SIZE 8 1/2 x 11

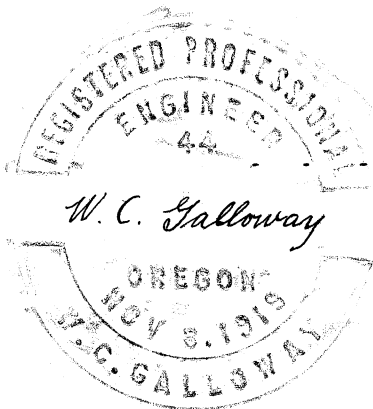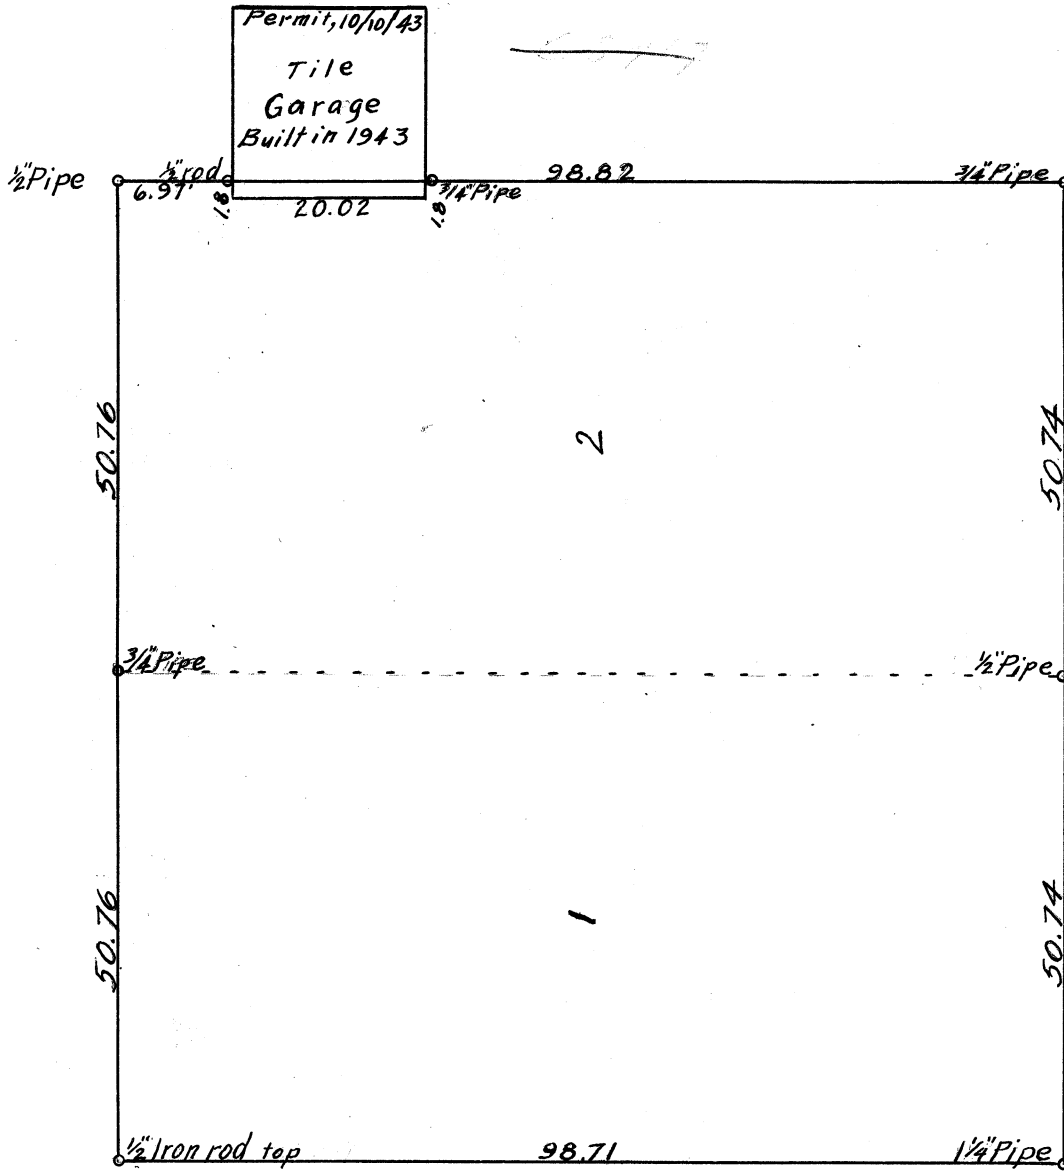

Jackson Street