

LEGEND

-Found Monument as noted.
-Set Monument: 1/2" x 24" rebar with yellow cap "N.STAR"
- +Computed position, nothing found or set.

Data of, or computed from, the following:


()..CS 9296 []..CS 8827
 < >..CS 6802 { }..CS 6667

RECORD OF SURVEY
 FOR
WEYERHAEUSER CO.
 IN THE
 NE 1/4 OF SECTION 8
 T 14 S, R 7 W, W.M.
 BENTON COUNTY, OREGON

Benton County
Surveyor's Office

C.S. FILE NO 10788
 FILING DATE 10-12-16
 FILE SIZE 11x17

OCTOBER 10, 2016

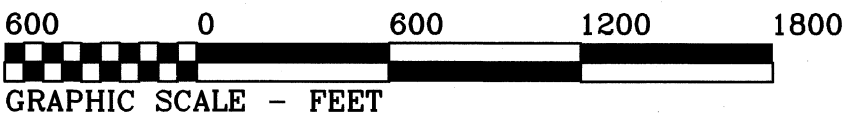

REGISTERED
**PROFESSIONAL
 LAND SURVEYOR**

Robert Alan Cook

OREGON
 JULY 26, 1988
 ROBERT ALAN COOK
 2336

RENEWS: 12/31/2017

5/8" Rod up 8" with steel post
 and 2 alder BT's.

1976 BLM brass cap, I set steel
 post. New 1/2" rod for RM lies
 N 44°56'06"W 312.84 ft.
 18" D. Fir N 3°E 15.7 ft.
 15" D. Fir S 62°E 6.3 ft.
 20" Stump N 45°W 40.5 lks.

1976 BLM brass cap with fiber
 glass post riser in pipe.
 24" D. Fir N 62°W 32.9 ft.
 18" D. Fir S 53°E 10.3 ft.
 16" Maple N 70°E 25.8 ft.

BASIS OF BEARINGS

(N 88°56'56"E) 2651.42'
 (N 88°56'56"E) 2651.70'

NORTHSTAR SURVEYING, INC.
 720 N.W. 4th Street
 Corvallis, Oregon 97330
 Phone: 541-757-9050
 email: bcook@northstarsurveying.com

NARRATIVE

The purpose of this survey was to show the marked and posted line in the NE 1/4 of this Section 8, to record the RM set at the 1/4 corner, and to point out that the East 1/4 corner of this Section is very likely out of position by an unreasonable amount. I tied into the three monuments as shown. I oriented to CS 9296. The tie to the West 1/16 corner allowed me to calculate the positions of the South and East 1/4 corners per CS 8827. I calculated the SE Section corner by holding the record angle and distance from CS 6802. I understand that all of this calculating from various surveys is weak but since I know that the N-S centerline of the section is straight and that the East line of the Section is straight, it makes sense that the E-W distances should be close. CS 8827 records that the distance from the Center 1/4 calc. to the East 1/4 is 2682.28 feet. The north line I measure to be 2651.70 feet and CS 6802 records the South line to be 2659.66 feet. The bearings are close, and the surveyor who recorded CS 8827 was very good. In conclusion, it is likely that the monument at the East 1/4 corner per CS 6667 is about 26 feet onto the BLM.

<S 00°36'W> <5337.24>
 [S 01°29'32"W] [5339.48]
 S 00°26'46"E 5339.48'

