

C.S. # 1327

Wilkin's Addition
Block II


F.B. 85-25

FB#85

25

Harrison St.

1327

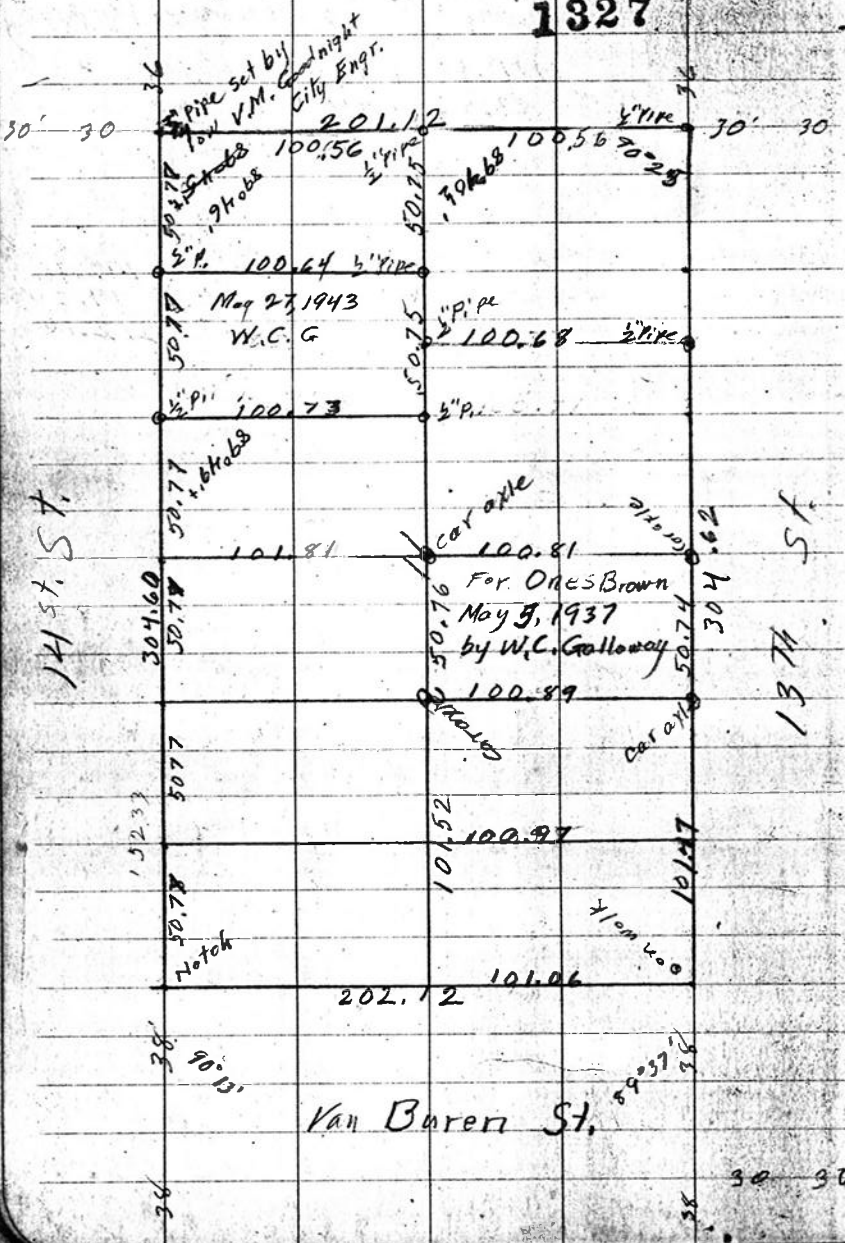

100.615
 101.06
201.67
 100.835
 101.04
128
 27

647
617
 13034

566
 559
 580
 548

26

Onis Brown
 May 5 1937

5
579.79
 575

90° 15' 89.36
 89° 45' 90.15
 90° 15' 90.13
 89° 37' 89.37
360° 00'

.332
 .016
317 .00324
 291
 .0037

6 | 304.67
 50.77
 3 | 304.6
 101.53

201.12
 383
2 | 201.453
 100.9265
 .016
 100.710

2021.2
 2011.2
1.0000
 9138
 8620
6092
 252.80

50.75
40.75
 91.50
76.13
 15.37

1.00328 = 11"
 6 | 304.67
 50.77
 101.54
150.77
 152.31

50.75
25.38
 76.13

4 | 304.67
 76.16