


C.S. # 1354

Hoffman's Addition

Block 2

F.B. 85-35

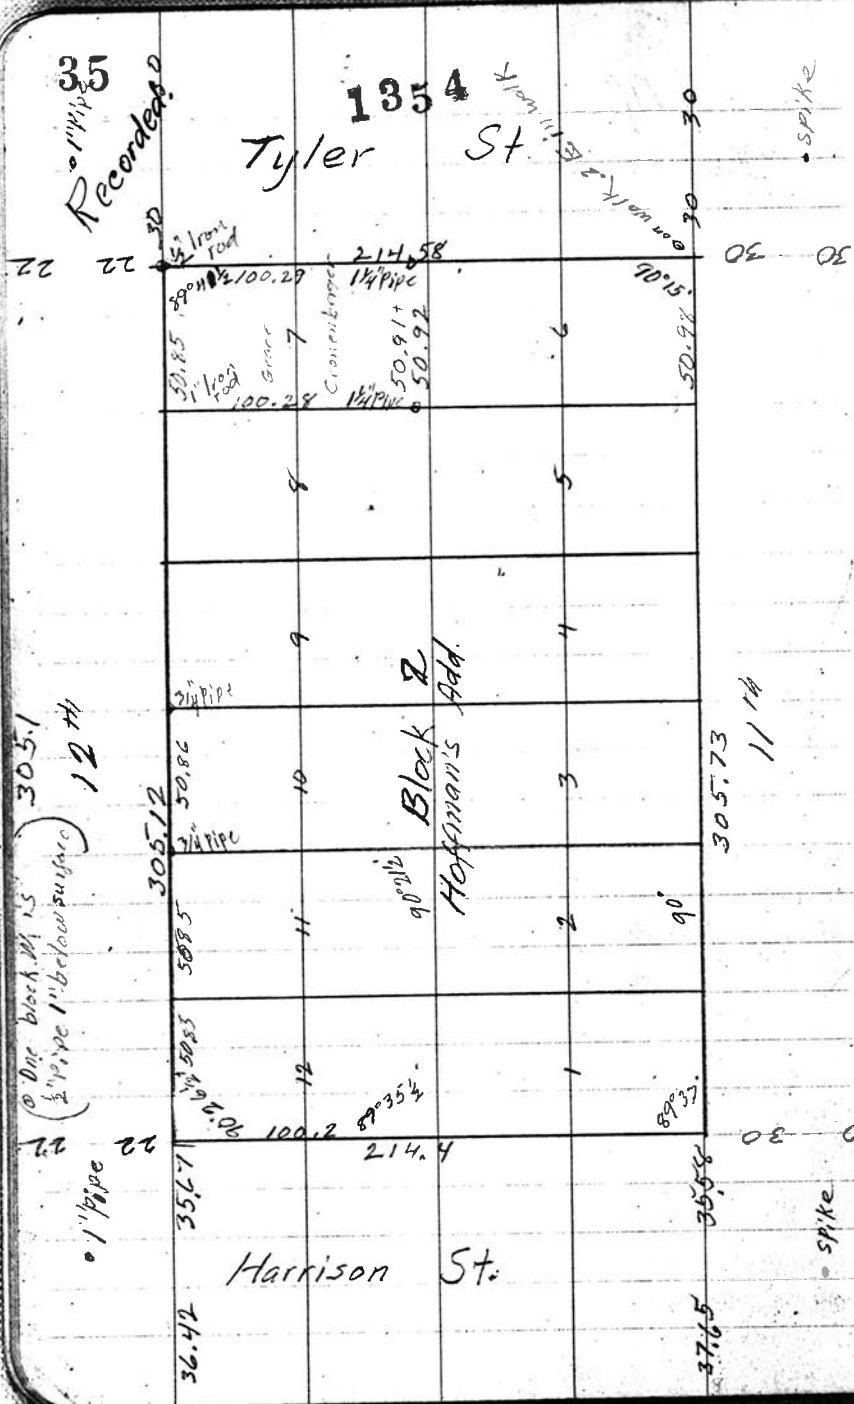

Oct. 21, 1937
 W.C. Galloway
 Rudolph Stewart
 For Grace Cronenberger

90° 26 1/2'
 90° 24 1/2"
 89° 35 1/2'

89° 37'
 90° 26 1/2'
 70° 15'
 89° 42 1/2'
 360° 00'

6 | 305.73
 50.98

6 | 305.12
 50.85
 10.170
 + 5.53
 2 | 305.12
 152.56

505.73
 305.12
 2 | 610.85
 3 | 305.42
 107.81