

C.S. # 1360


Johnson's Addition

Block 5

F.B. 85-39

39


N^o
1360

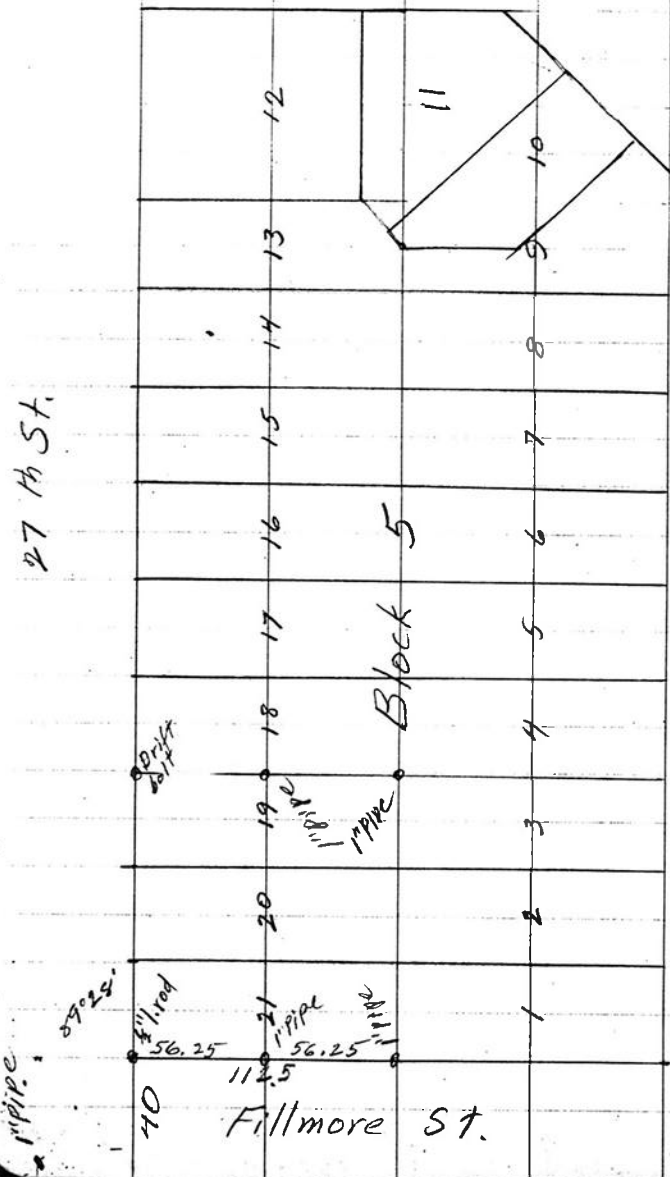


40

For Clinton Borden
By W. C. Galloway

Dec. 7, 1937

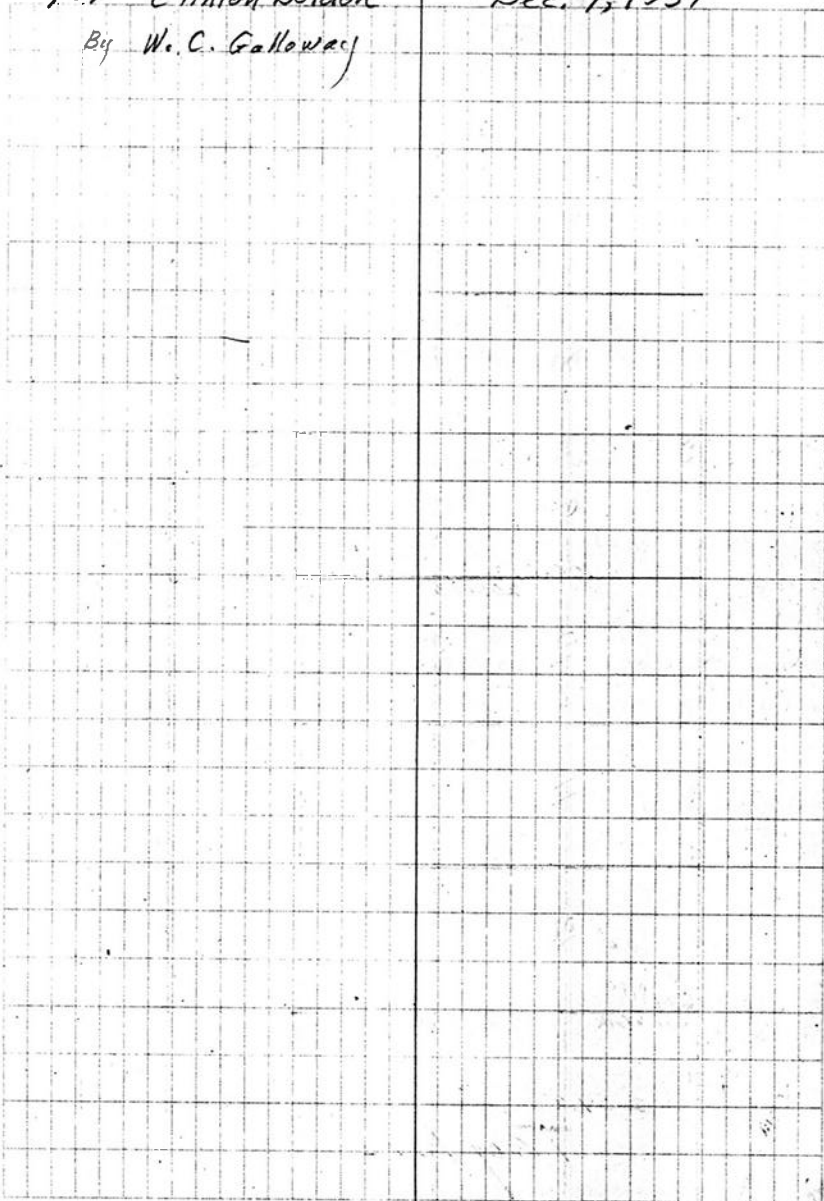

1360

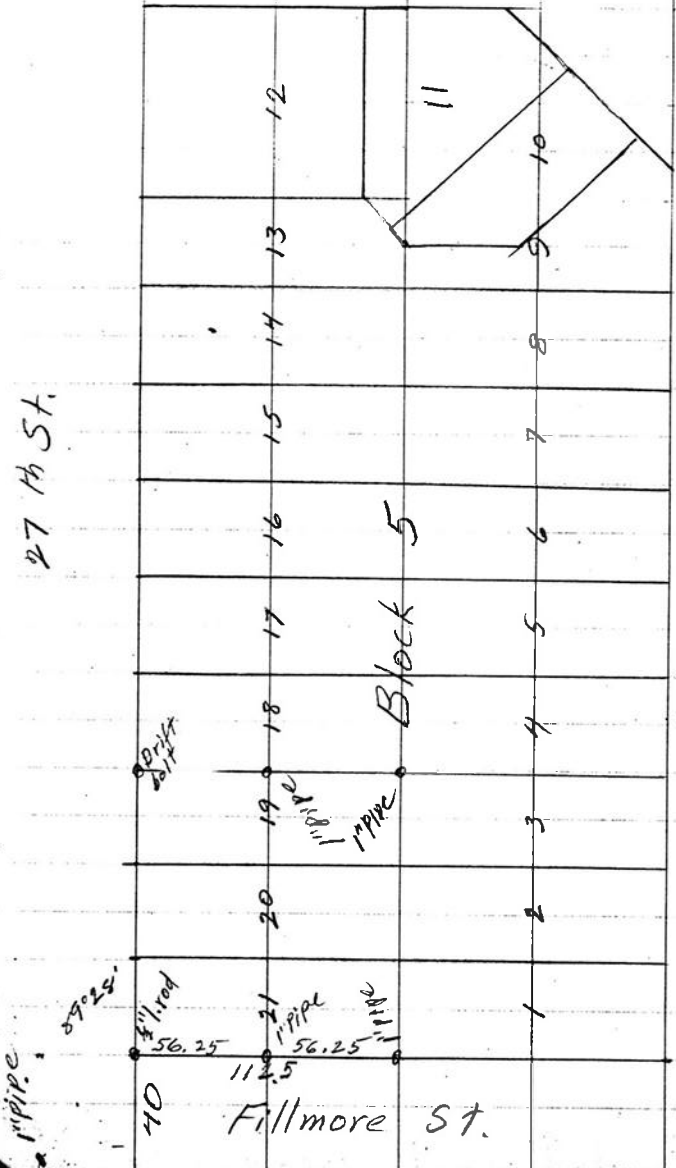

1" pipe

59°25'

4" rod

56.25

112.5

1" pipe

56.25

2" rod

0.25 ft

2" rod

1" pipe

Block 5

27th St.

26th St.

Fillmore St.

For Clinton Borden
By W. C. Galloway

Dec. 7, 1937