

C.S. # 1472

See notes in file

F.B. 58-59

Beginning .040 S 26° 41' E. of 1" pipe the  
 S.W. cor. of which is 16.432 S. 63° 19' W. of  
 1" pipe 7.351 S. 35° 03' E. of a N. corner of  
 Morgan R. Savage D.L.C. 55 T10-5  
 B.S. parallel to property line

Thence S. 63° 19' W.  
 correction N. 3'  
 (S. 63° 22' W. 54.387)

1	L.R. 37 1/2'	+6° 21'	6.144	066 N. .005
2	L.R. 18 3/4'	+3° 12'	8.000	048 N.
3			.715	.046 S.
4		+2°	4.346	.043 S.
5		+6° 20'	7.987	.037 S.
6		+7° 40'	6.831	
			.396	
			+ .142	+ .141

and S. 34° 26' E. .013 S. 112'

Set a 3/4" pipe to Ch. line.  
 Fir 11" S. 52° 55' E. .673  
 stump 24" S. 33° 23' W. .617  
 S.L. 7° 45' =  
 S. 55° 34' W.  
 correction 1 1/2' N.

7		+8° 50'	2.108	S. 011'
8		+5° 55'	1.6965	S. 011 3/8" P.
9		+3° 25'	5.991	S. 008'

For Emile Jensen


Ervin Christensen  
 Kenneth Apling  
 Henry "

Newberg  
 May 11, 1940

79386	99494	
6.144	3575	
397544	497470	99844
397544	696458	798752
94386	497470	
596316	298492	9939
6.10627584	355691050	16.432
.01086	00546	6.106
	.87	3.557
	3892	8.703
	9368	4.343
	.047502	39.141
		7.938
		6.770
		.396
		54.245
		.142
		54.387

3/4" Pipe		
3/8" Pipe		
3/8" Pipe		
3/8" Pipe		
Offsets		
.040 S.		
.066 N.		
.026 N.		
.048 N.		
.074 N.		
.031 S.		
.043 N.		
94.709		
40.897		

Spike		
+.25 3/8" pipe		
3/4" Pipe		

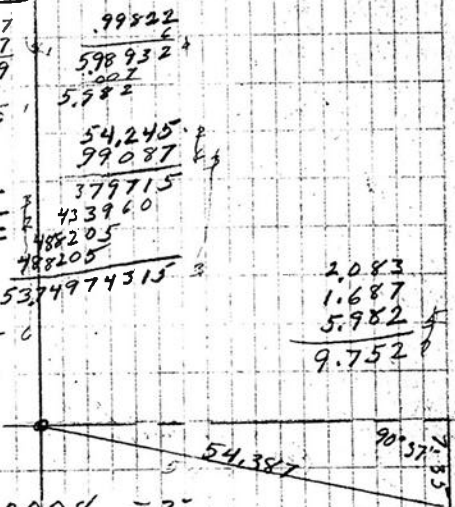



863  
 17 at STRIKING W. of  
 A. 3/4" pipe + 3.20' 3581  
 N.O. 11' W. thru E. sec. 8  
 correction 07' W.  
 C.N.O. 18' W. 80.566

138 .0034  
 99219  
 7617  
 694533  
 99219  
 7617  
 595314  
 694533  
 755751123

10.225  
 3.575  
 13.800

25 -9°20' 1.527  
 26 -9°27' 6.244  
 27 +2°35' 2.744  
 28 -0° 2.919  
 29 -7°10' 7.617  
 30 -9°30' 2.524  
 31 -13°10' 4.700  
 32 -5°34' 3.932  
 33 -7° 2.247  
 34 +1°40' 1.771  
 35 -3°12' 3.314  
 +2.57

79556  
 3932  
 199112  
 298668  
 896004  
 298668  
 391454192  
 4330  
 3509  
 1021  
 99219  
 26855  
 496095  
 793752  
 595314  
 195438  
 266403015

8.53  
 1.507  
 6.159  
 2.741  
 2.919  
 7.558  
 2.489  
 24.226  
 4.576  
 3.915  
 2.230  
 1.770  
 36.717  
 3.309  
 40.026  
 1.021  
 5.760  
 2.664  
 49.471

offsets  
 0034 W.  
 .1562 W.  
 80.566  
 .1596 W.  
 80.566  
 790340  
 7250991  
 652460  
 100198.57  
 600198.57

© see Stone

sets 3/4" pipe

and W. .077

36 1.021  
 37 -2°48' 5.7665  
 38 -7°10' 2.685

39		-5°50'	3.375	
40		-7°55'	1.760	
41		-0°	1.961	
42		-3°10'	4.497	
43		-2°40'	3.252	
	L.L. 12°40z			191 W. C. line
	Ripe should be			75 1/4" farther E.
44		-5°05'	5.787	
45		0°	3.464	
46		-3°35'	3.983	
5	L.L. 2°53 1/2'	-7°57'	3.1265	Feet
8	Car Spring			156 W.

	71482		99047		97563
	3375		176		87
	497410		594282		5682841
	696974		673329		780504
	298846		99047		8487981
	285846		17432272		21942
	335781750		990391		153594
	99607		31265		175536
	5.182		495195		1908954
	697249		591234		64.271
	796556		19807		848
	697249		94037		65.119
	495035		2711		15.450
	576425709		8096454335		80.569
	15480		5045		
	12384				15459
	191				1986
	126				12360
	156193209				19805
	126				1545
	.030				1545
	.126				2205910
					.257
					280.566
					40.283
					10.026
					2.257
					64.271
					5.764
					3.464
					3.975
					3.092
					61.022
					3.249
					4.498
					1.961
					3.357
					1.743
					49.471