

C.S. # 1563

Old Town of Marysville  
Block 14

F.B. 87-39

6  
12  
39


156 3

Block 14

Adams St.

39.7936

Fourth St.

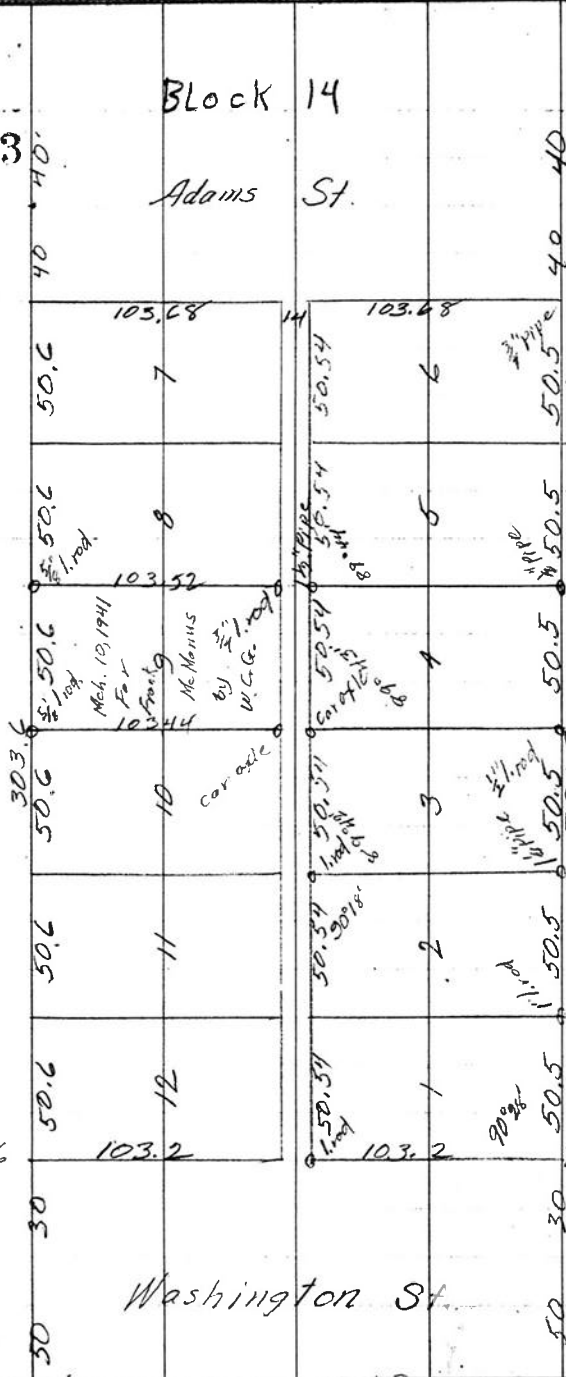

39.62356

Washington St.

40

For Frank Mc Manus

Mc. 10, 1942.

K.M. Patterson

37. 37

Third Street

38.12 37.8

