


C.S. # 1665

Hardcopy 11-7 #4

also see notes in file

F. B. 82-55

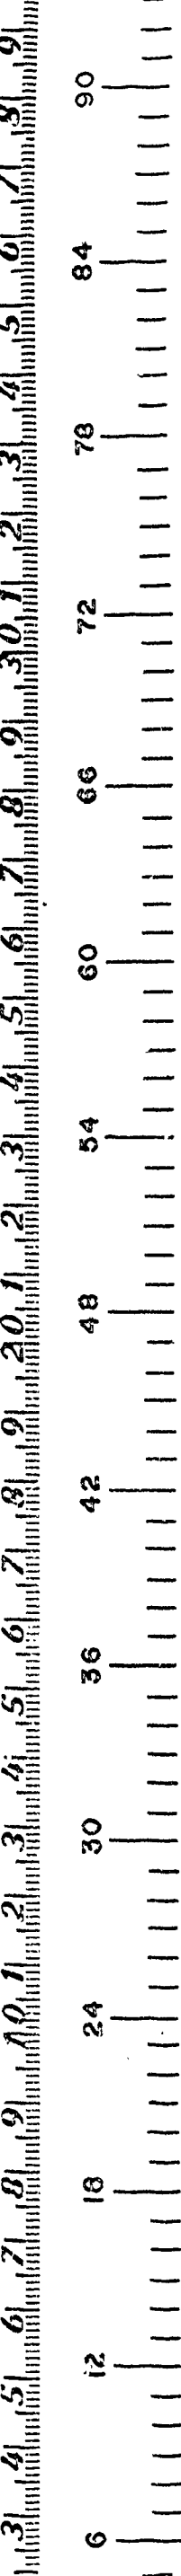

11-7

Book 82

FIELD BOOK

361 A

55

C.S. 207 Continued
Beginning at 3/4" bolt
8/9 B.S. at A 14 page 17
N. 54° 56 1/2' W.

1665

S. 0° 45' E.
correction E 2'

(S. 0° 47' E. 40.089)

1		-6° 20'	4.118
2		+5° 30'	1.591
3	Not in total	-3° 35'	4.425
			-.071
		and E.007	

Set 1/2 bed rail. 14" L iron

4		-1° 55'	7.298
5	LL 42'	+4° 35'	6.119
			+ .974
		and W. .062	at this O

6	LR 2° 17'	-3° 15'	5.776	offset 230 W.
7	LR 46'	-28° 05'	7.343	offset 087 W.
8	LR 25 1/2'	-8° 10'	4.634	offset 034 W.
9	8/9 17/16	LL 4° 08'	0°	offset 303 E.

1/2" pipe, stump 1' x 1.6' S. 80° W. .061

For Victor Plunkett April 10, 1944 56

Sec. 8 T. 11-7
N. 89° 37 1/2' E 180
35° 26' 125.03 1/2
125° 03 1/2' E N. 54° 56 1/2' W.
39.953 9939 9954
4.118 6 1991
79512 9954
9939 89586
9939 49770
39756 9954
4092880 2 15836814 b

E.003		5.677
E.004	(Spikes noted)	7.294
		6.099
	20.044	19.070
	19.070	6.099
	.974	5.762
		6.478
		4.587
		4.192
		4140.089
		10.022

21/sets	.15 E	.230 W.
.075 E	.303 E	.087 W.
.230 W.	.378 E	.034 W.
.155 W.	.351 W.	.351 W.
.087 W.	.027 E	
.034 W.		
.276 W.		
.303 E.		
.027 E		

009 E. 40.089 .00067 = 2 1/3
062 W. .0270000

LR 3° 20'	155
E.172	017
E.263	172 E.
E.300	1004 E.
	.087 E.
	.263 E.
	.003 E.
	.034 E.
	.300 E.
	.003 E.
	.303 E.
	.000

57

Back to A3 - 071

S. 89° 53' 1/2 W. 19.979

10	L.R. 41 3/4	+13°10'	4.2235	offset .050 N.
11		0°	2.504	
12	L.L. 25 3/4	-12°30'	4.900	offset .036 S.
13		+4°18'	3.278	
14		+7°15'	5.183	
15			.161	

Set 1/2 bed rail, 1 1/4" L iron S. 020

N. 0° 46 1/2 W.

16	L.L. 27 1/2	-17°20'	3.860	offset .029 W.
17	L.R. 22 3/4	0°	4.369	offset .029 E.
18	L.R. 04 1/2	-9°10'	1.990	offset .003 E.

Corner

58

97371 4223	01215 4112	5183 992	
292113	2430	10360	
194742	1315	46647	
194742	1215	46647	
389424	4820	5411536	
411197733	.04992080		1007
N. 89° 15' W. 35'	Thence N. 0° 46 1/2 W. 10.038		4.112
9763	99719	19.979	2.504
49	3278	19.815	4.784
87867	41 3/4	.161	3.269
39032	696033		5.142
478397	199438		19.818
4749	299157		.161
43146	326878882		19.979
19136	445495459	98723	
33488	386	19746	
2583304	572754	011	
436944	763672	1963	
60251	286377		
8738			
26214	3.6847174		3.685
028922	029440		4.369
		10.038	1.764
		10.018	
		.020	10.018

N. 194' W.

465

27 1/2

N. 0° 42' W. to corner

Notes

N. 0° 34' W. 40.269 255 @ at 1250

from Sec. Cor. 5/4
3/4 bolt 8/9