

Plat of Survey No. 66 #167 Claim No. 46


MADE FOR Seavey Bros.

Section 11 + 12 Township 12 S Range 5 W

Scale: Chains to the Inch.

Field Notes recorded at page, Vol., Record of Surveys.

Field book 5 Page 27 See special plat

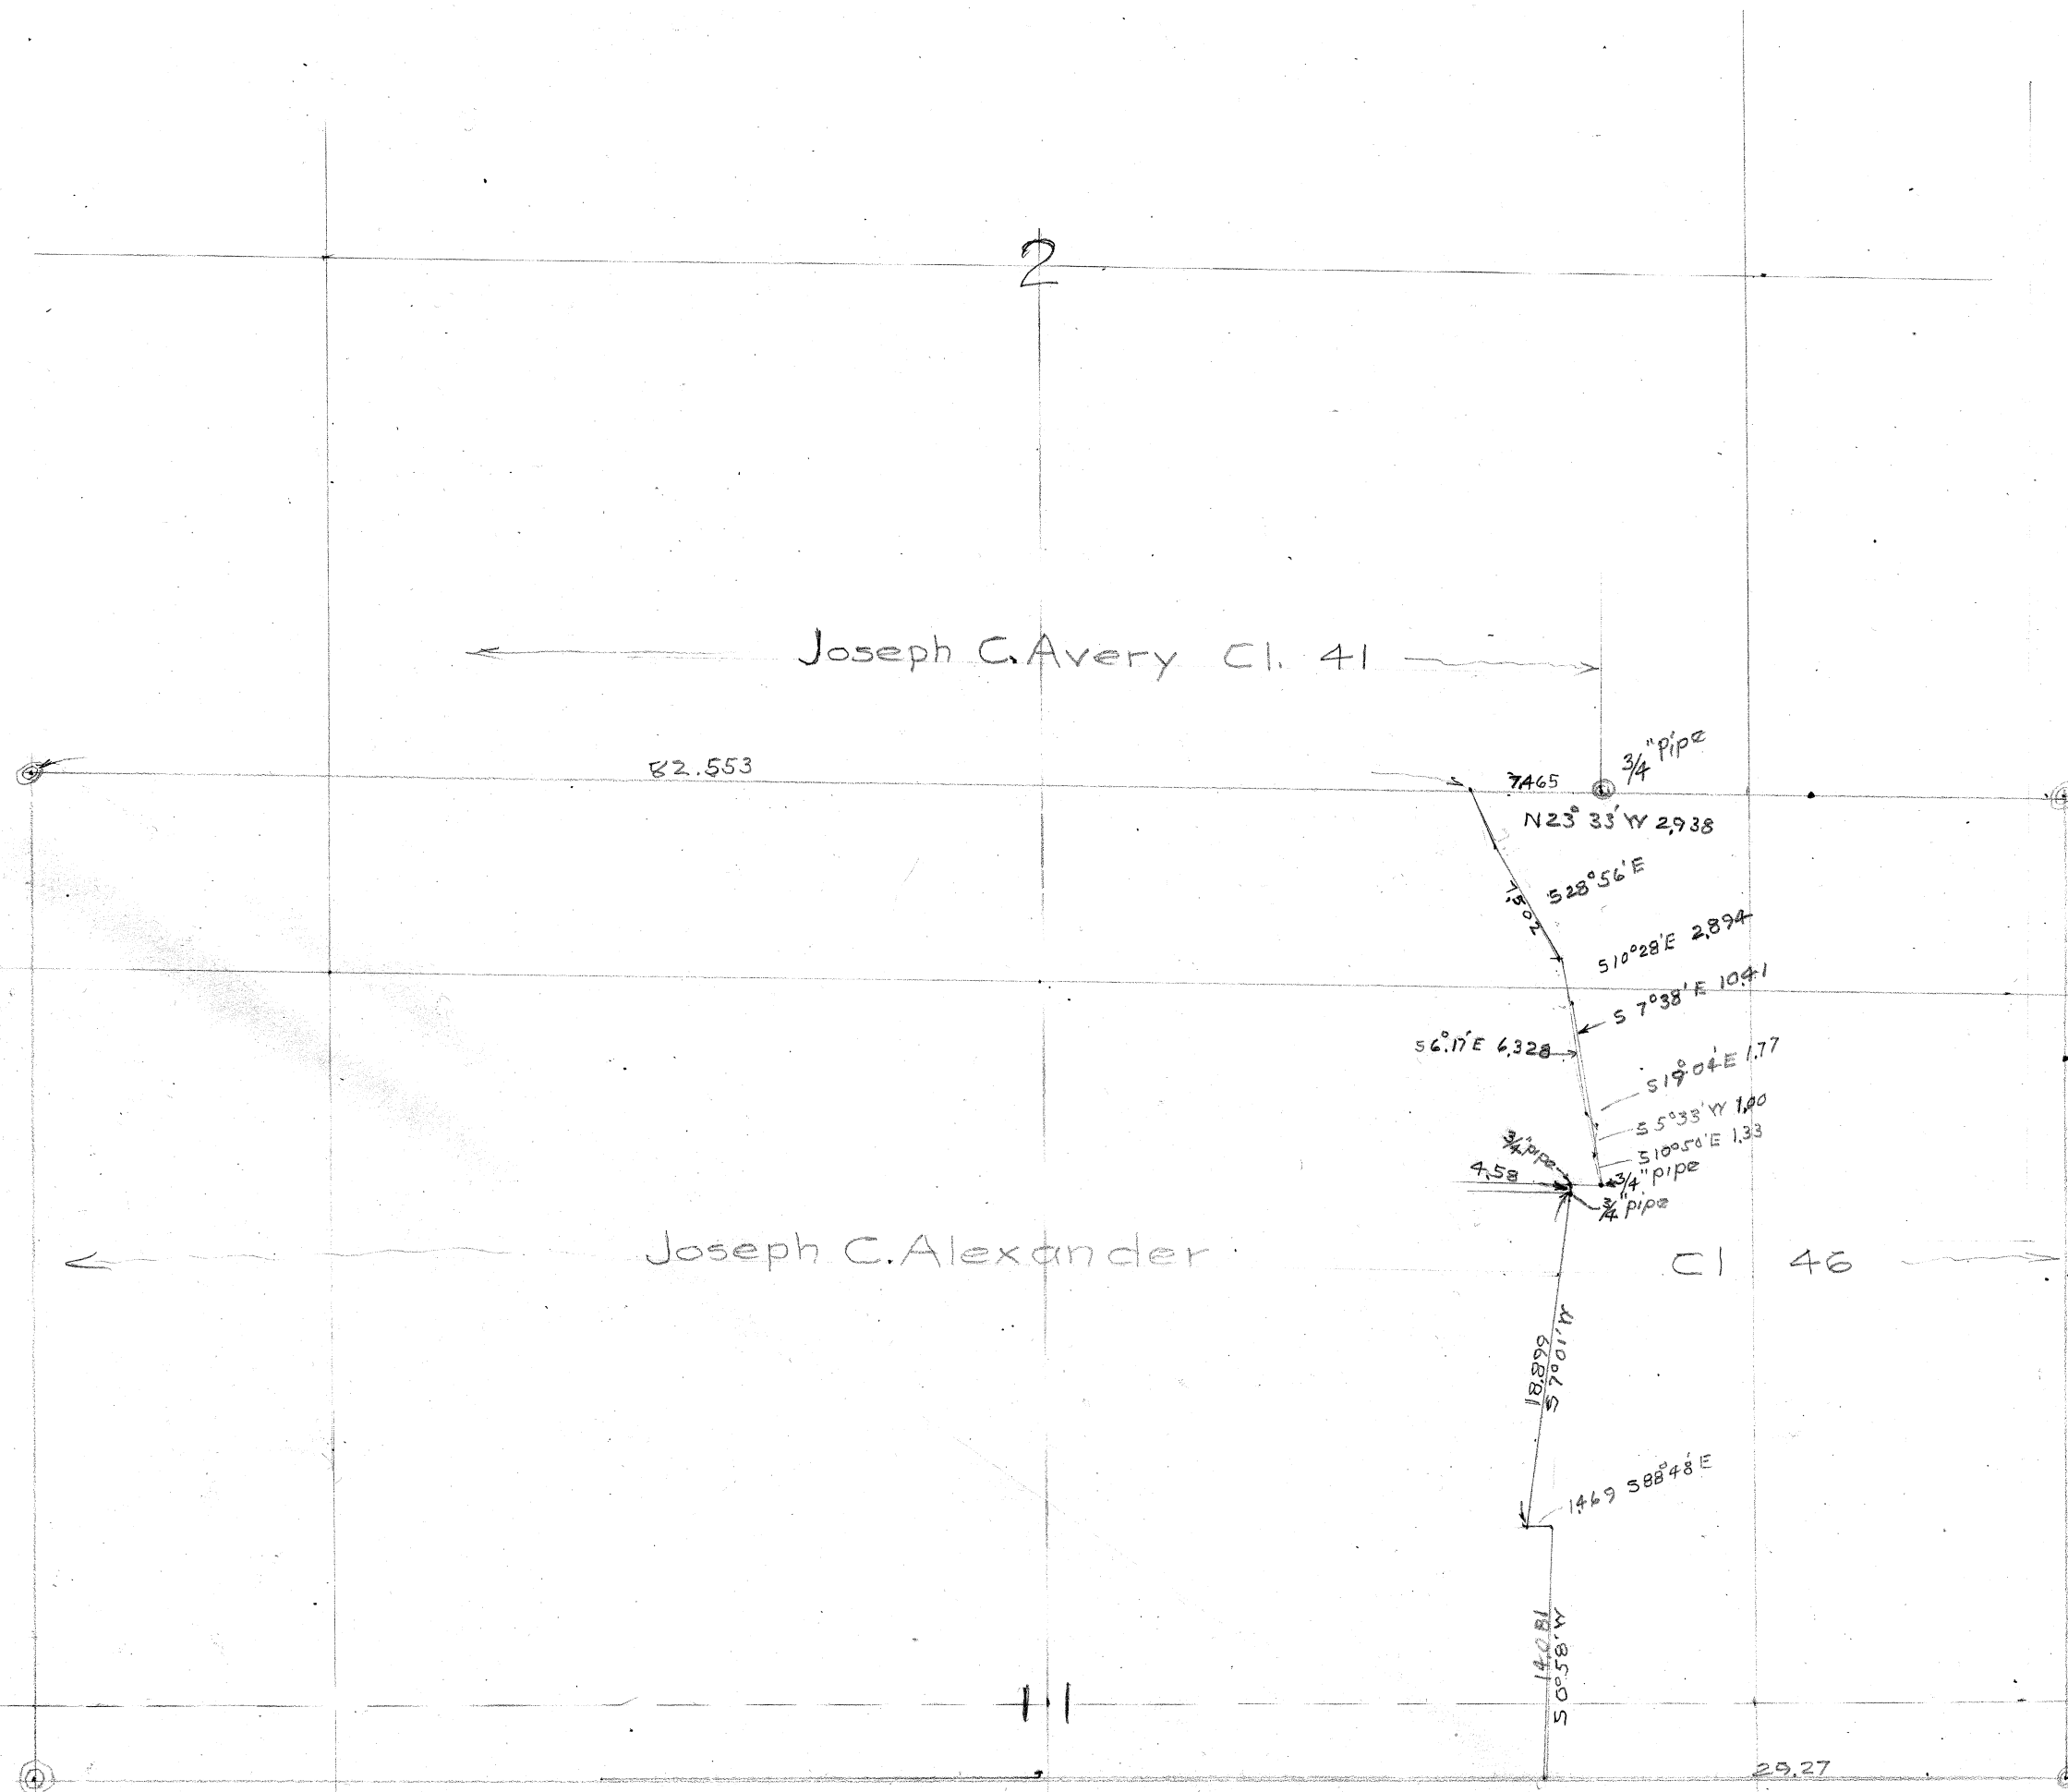

#167

27 Survey No. 66 T. 12 S. R. 5 W.

Beginning at the SE. corner of Alexander D.C. No. 46

E. 0.09 From corner

N. 122 From corner

8.000

3218 12.577

11.107 32

4.381

16.32

-0.005

391

1.908

.402

-2.413 = 99.07

8.000

5.470

+1.90

.290

1.227

-0.020

.930

8.111

11.998

-0.008

.091

4.381
37.422
39.422
38.42
38.4
37.4

1.632
226.88
120.88
113.064
97

43796
1.609
1.908
1.949

10872
4183
105
011463

13442
8062
26990
1214
28257

283
011463
290
253
037
1408

29.270
243
010
223 = 9
00263
03700
291
8840
2442
3920

091 E
025 W
16065
5800
79228
77428
10600

19.257
10.505
19.289
1.262
19.281
19.277
311

19.27
19.281
19.277
311

11.596
19.990
230

19.365
1.001
19.357

11.087
13011
11.087

11.087
13011
11.087

1840
1841
1842
1840
1841
1842
1840
1841
1842
24 Beg. at A 111 and running N. 41° W. 162

23 ← Right 2° 11' 122

22 1200

21 7373

8200 1081

20 709

5760

16000

29 5232

28 1543

11111 550'

6000

6900 1817

27 NW. I.C. Alex. and Cl. 46 lat. 4 Right 8° 45'

30 3831

31 3799

Back to 20 SE. of Alexander

32 North 11145'

← Right 33' 8000

33 (Comp. Right 28') 3917

34 8920

35 4272

36 14131

37 N. 45° W. 6603

Made 90° S. 54° 22' W. 3865'

N. Fix 30° N. 47° 11' W. 3478'

11 20° N. Easy Street. 50 d. 20000'

41111 41747

2 16000 7983

3 7373 12441

4 8000 3317

5 709 573

6 5760 29

7 16000 16160

8 5232

9 1543

10 11111

11 6000

12 6900 1817 1817

13 1817 1817

14 1817 1817

41111

2 16000

3 7373

4 8000

5 709

6 5760

7 16000

8 5232

9 1543

10 11111

11 6000

12 6900

13 1817

14 1817

