


Lot 1 Bk 2 1823


Harris. Addn

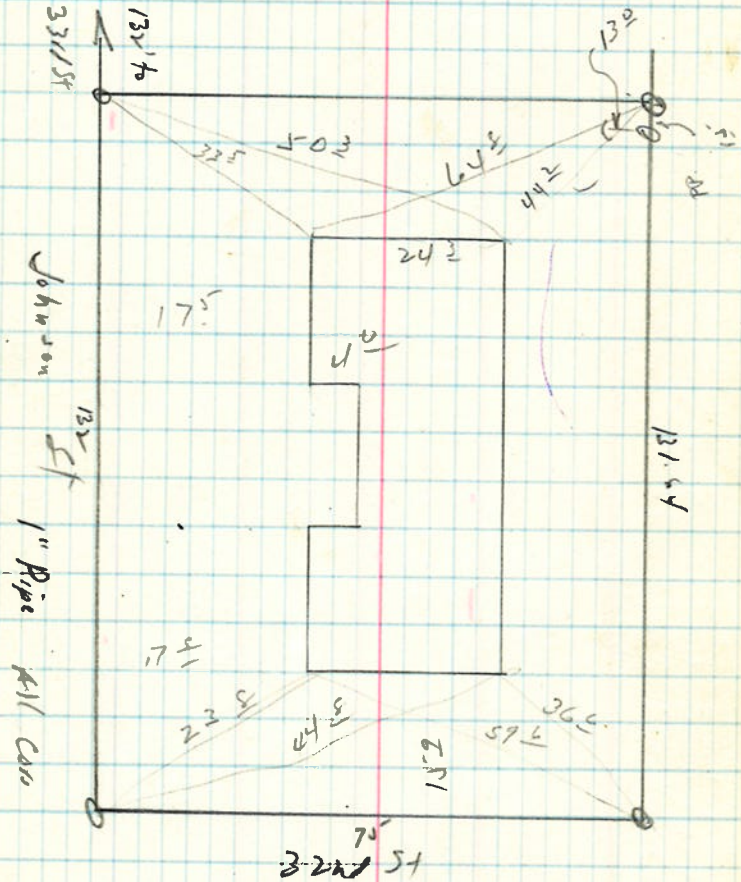


L 4 B 2 Harrison Addn

128 N 32nd

2-7-49

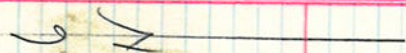

32nd st

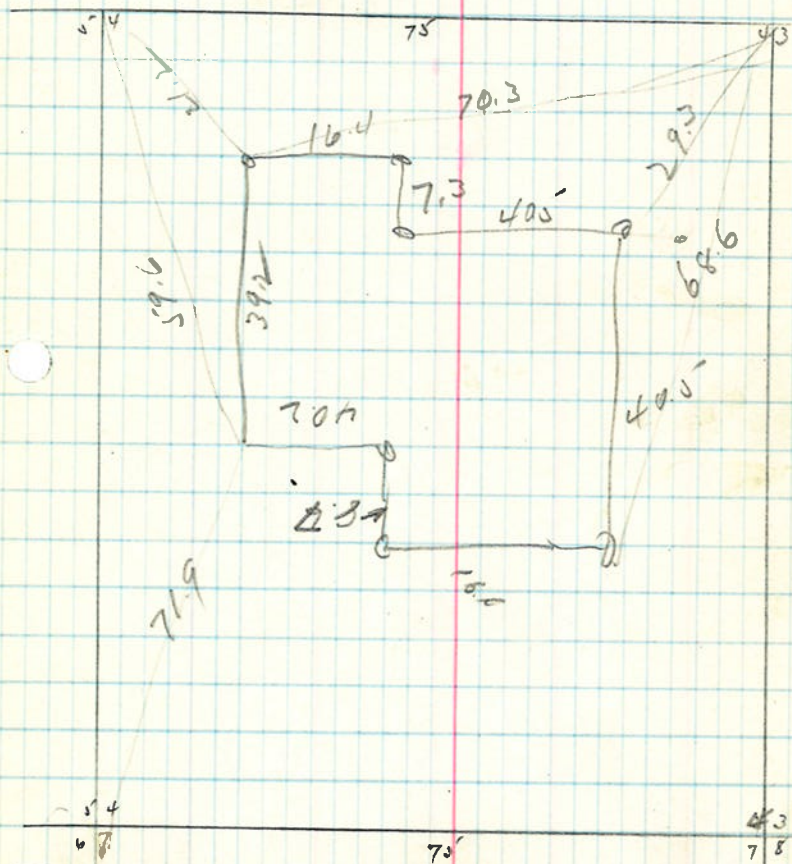

1823

Lot 10 DK 2
Harrison Add.

