


1832

Survey of N.C. Jensen Tract
 Scale: 1" = 100ft-0"
 Dec. 1946
 Twp. 12 So. Range 5 West
 Prior Scott D.L.C. #44

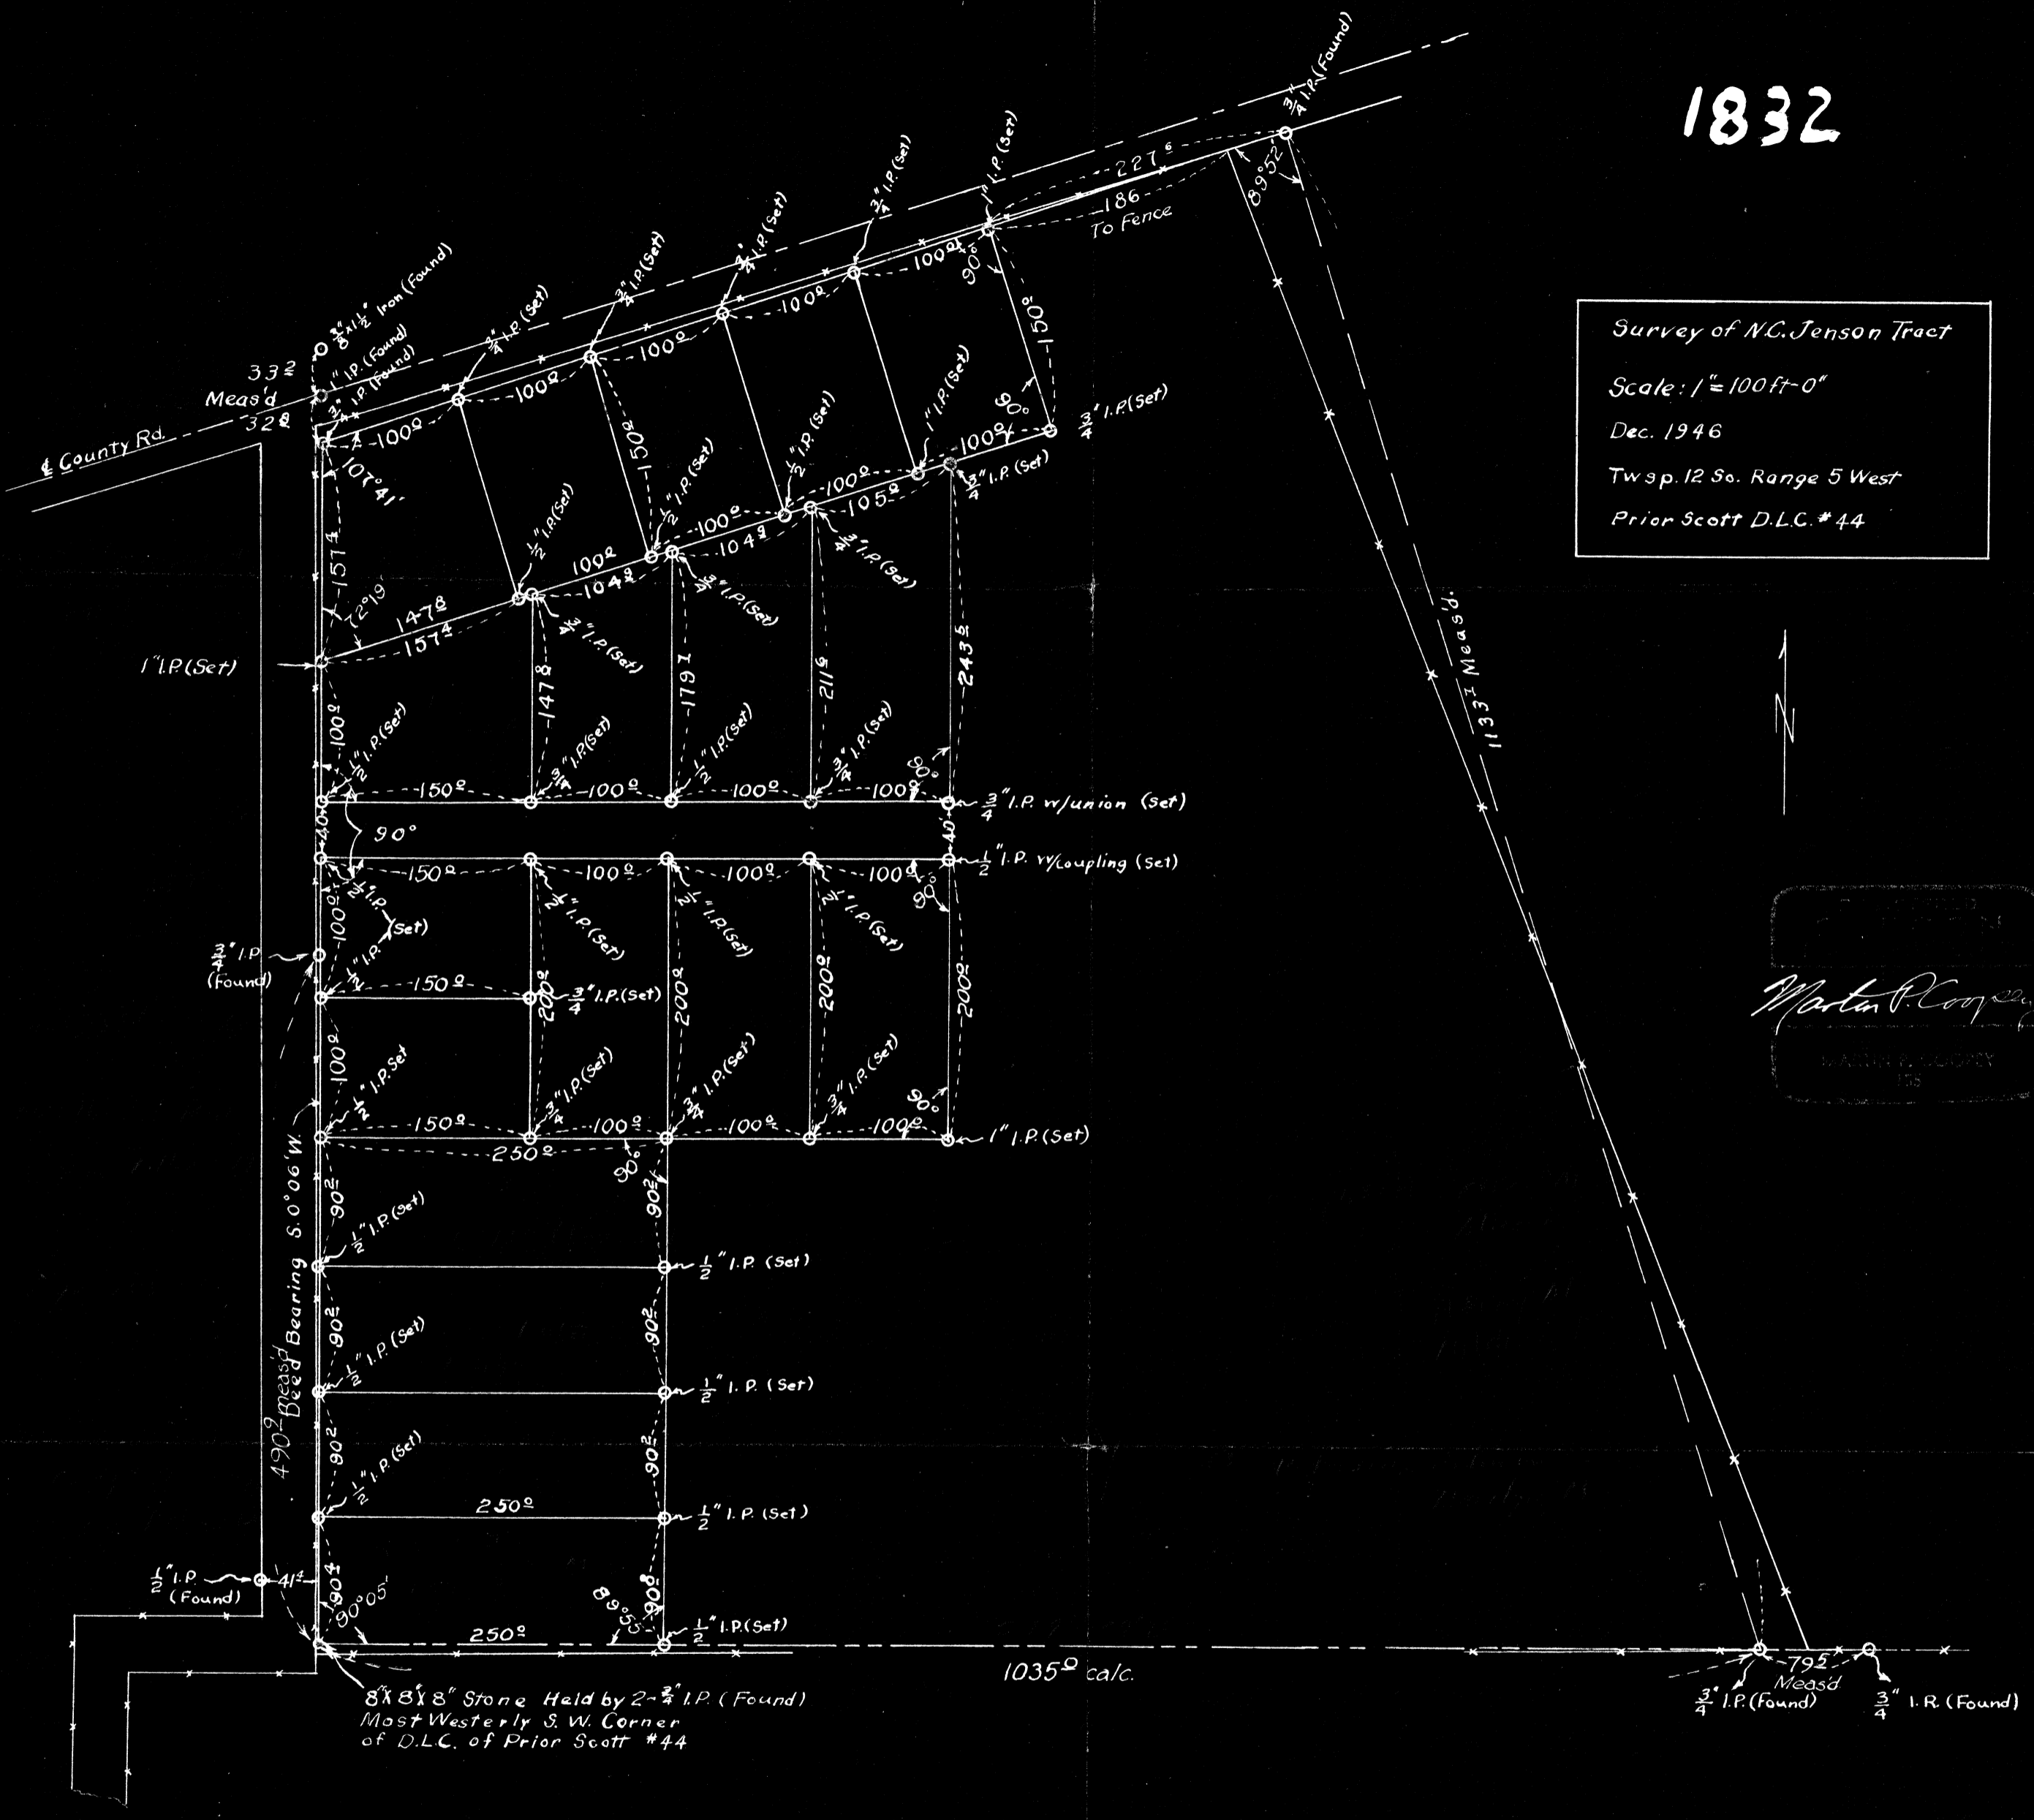

Martin P. Conroy
 Surveyor
 1946