


OTTO H. MEYER
CIVIL ENGINEER
621 North 35th Street
CORVALLIS, OREGON

CS # 277

July 15, 1947

1919

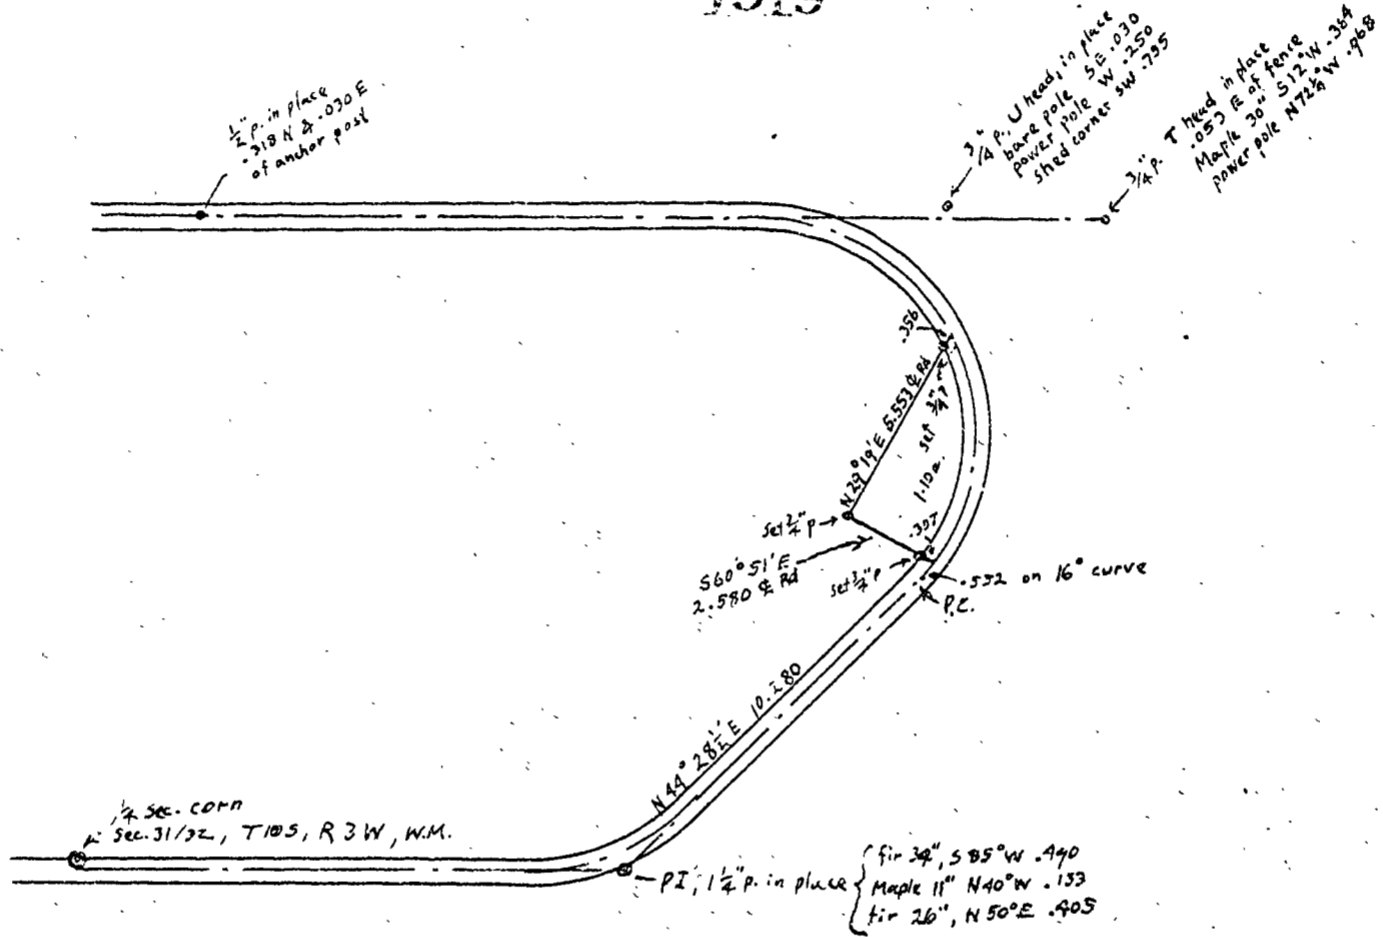

1" = 5 chains




OTTO H. MEYER
 CIVIL ENGINEER
 621 North 35th Street
 CORVALLIS, OREGON

CS # 277

July 15, 1947

1919

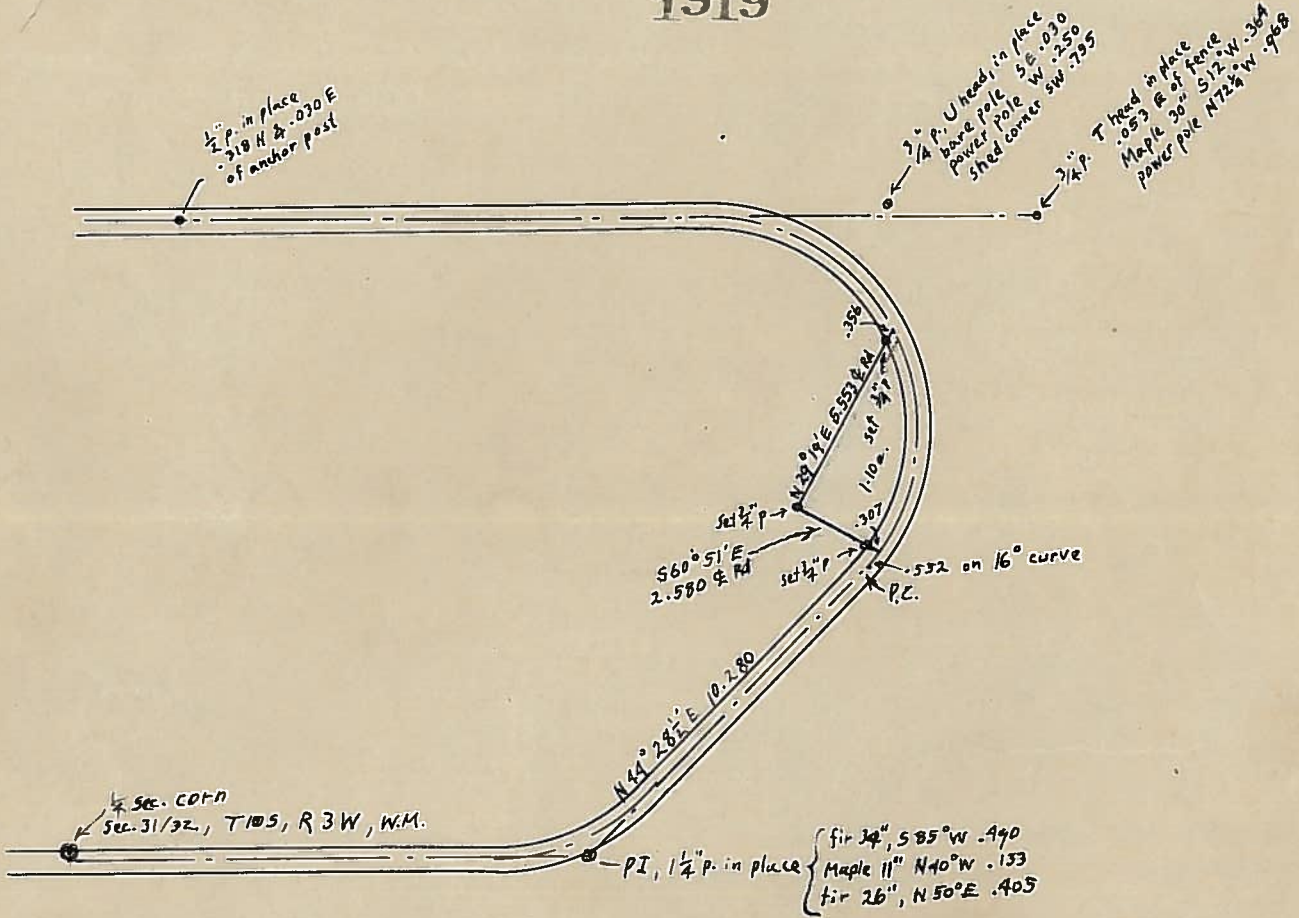

1" = 5 chains

