

C.S. # 1950

Job's Addition

Block 17

F.B. 87-113

Book 87

CITY &

SUBDIVISIONS

DEPARTMENT
OF PUBLIC WORKS

ENGINEERING

FIELD BOOK

No. 21046

113


1950

Block 17, Job's Add.

Shot to 11 St.

260.0

2003

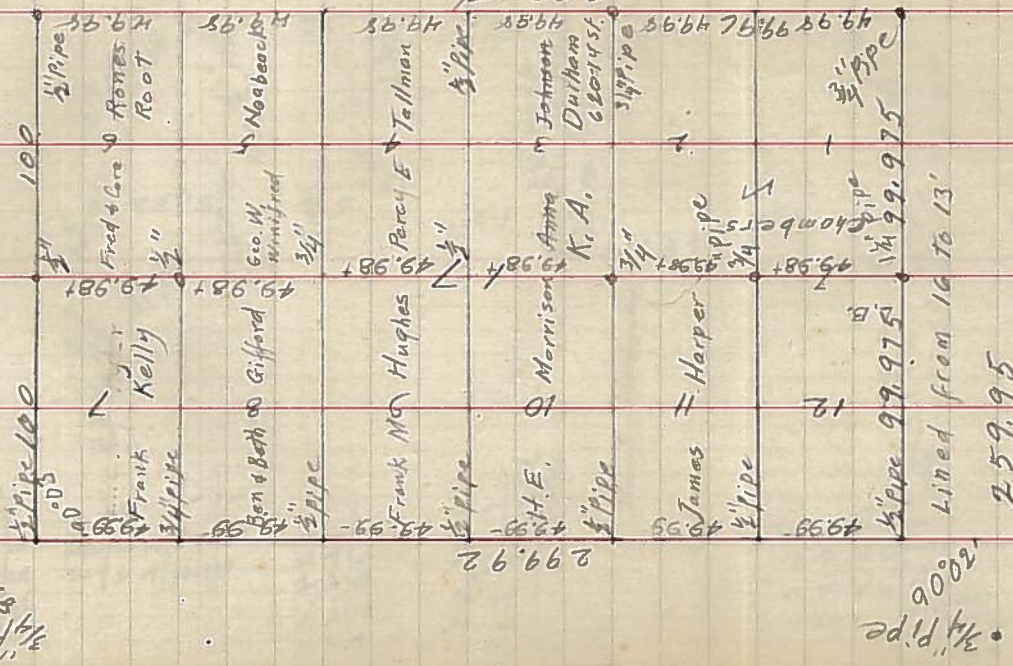

114

For H.E. Morrison 619 N. 15th St.
Surveyed by W.C. Galloway Oct. 14, 1947.
and 18

