

C.S. # 2007

Hardcopy 13-7#2

also see notes in file

Sec 22-13-7

CS # 108

For L. E. Kinsale

3-24-48


2007

LINE DATE _____ PARTY _____

PROJECT _____

LINE NO.	DIST	VA	HORIZ	OFFSET	STATION
28	173.73	+230.33'	159.28		1494.96
27	946	-	946		1332.68
26	296.2	+7002	293.77		1029.45
25	14.94	-	14.94		717.13
24	298.00	+3041	297.38		362.17
23	253.10	-	253.10		1505.50
22	101.88	-1002	101.86		87.73
21	215.75	-16030	206.87		
20	70.04	-15016	67.57		
19	76.43	-	76.43		
18	11.30	-	11.30		

11/20
16/21

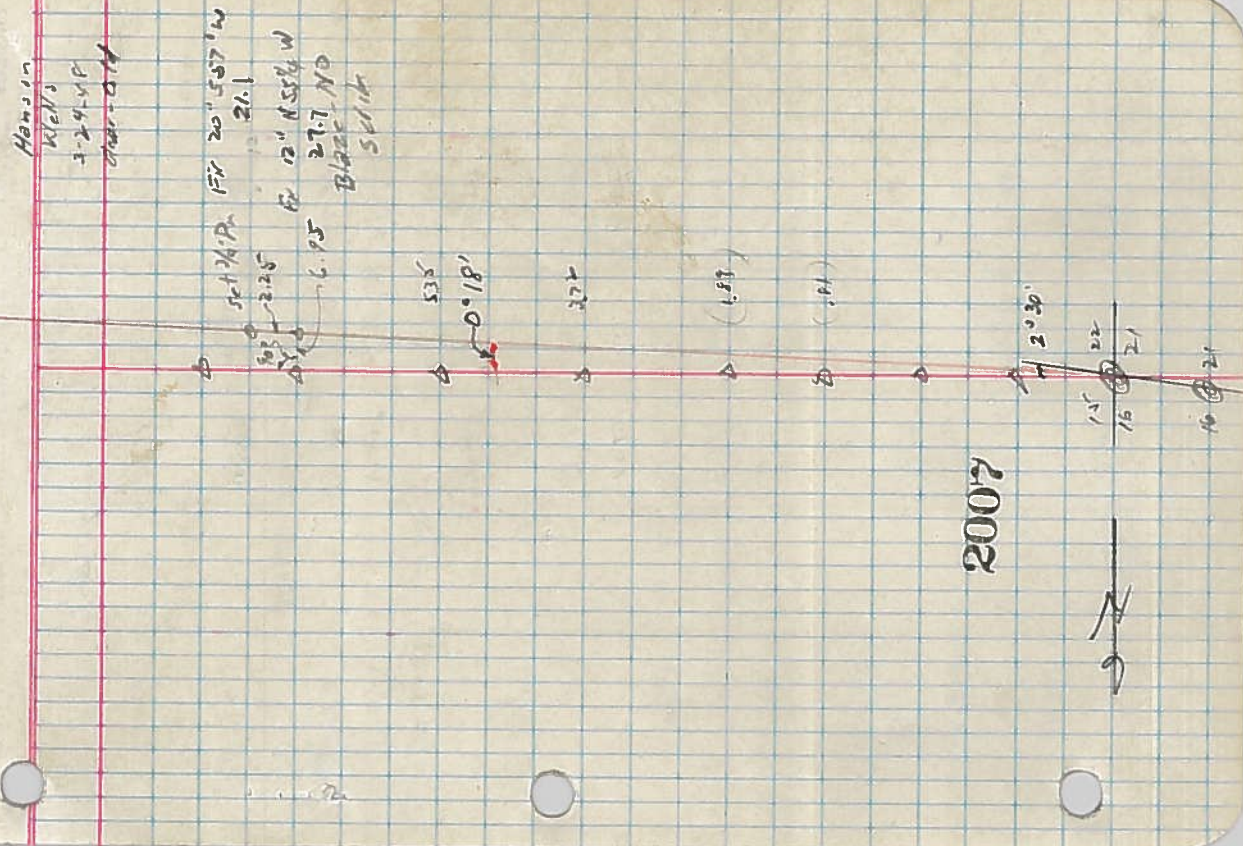


LINE DATE PARTY

PROJECT

Sheet Form 5-72

012	78.50 + 19°25'	74.04	4 + 3.12	73.89
017	263.80 + 37°41'	203.02	RT 1.60	202.97
016	29.36 + 36°33'	23.57	RT 1.68	270.87
015	289.00 + 31°07'	247.42	RT 1.33	
014	135.87 + 25°57'	122.67	RT 1.33	2794.09
013	206.00 + 19°17'	251.05	RT 1.33	2438.46
012	108.90 + 8°55'	107.58	RT 1.33	2221.25
011	166.15 + 9°00'	164.11	RT 1.30	2178.90
010	95.50 + 13°07'	92.95	RT 1.30	1893.78
009	293.30 + 13°59'	284.62		1578.91
008	300.66 + 11°16'	294.87		1492.96
007	111.75 + 16°51'	106.85		

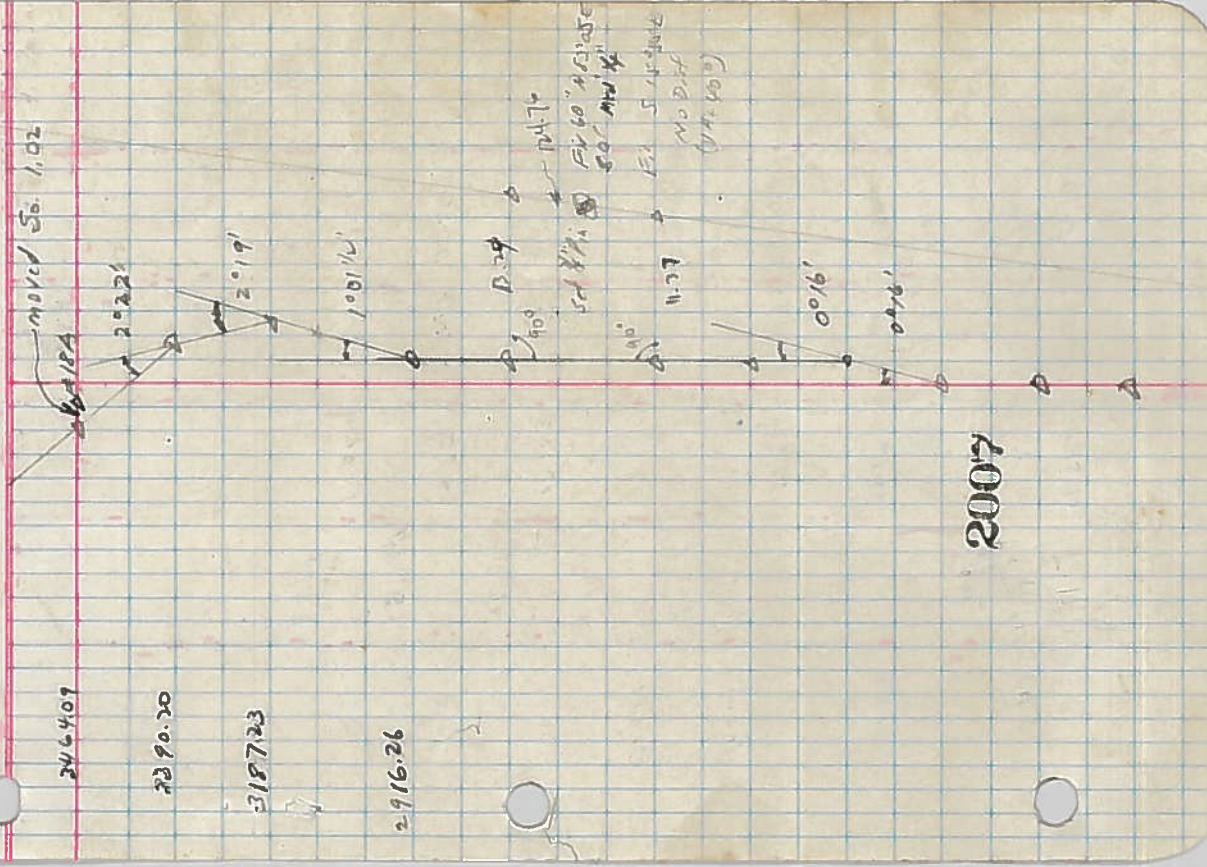


LINE DATE PARTY

PROJECT

STATE JOHN 2-17-73

024	70.20	+1°50'	70.17	RT 27.84	66.80
023	138.20	+14°21'	133.99	RT 6.67	132.54
022	272.20	+21°21"	253.52	LT 3.92	253.10
A 21	148.53	+20°31'	137.00	LT 2.72	139.00
020	169.85	+25°01'	148.49	LT 2.75	377.19
	255.00	+26°05'	228.70		
019	78.31	+27°17'	69.59	LT 2.41	350.47
	300.11	+20°34'	280.88		
018	378.20	+18°23'	358.90	LT 2.43	854.80
	201.45	+19°29'	195.90		
017A				44.2-10	

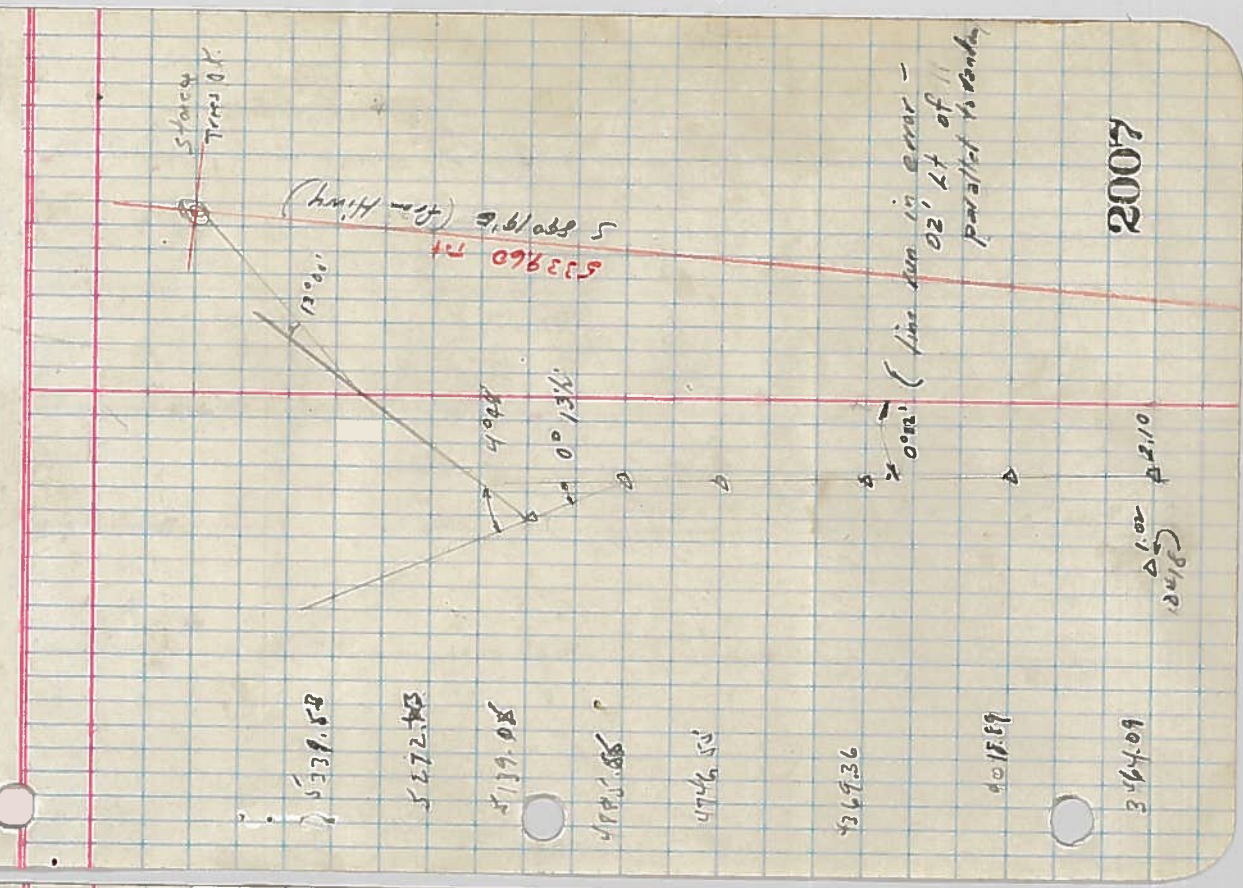

2007

LINE DATE _____ PARTY _____

PROJECT _____

STATE JOB # 272

SPRING C

