


Platted 7-1-48
 CS. 137
 179


OTTO H. MEYER
 CIVIL ENGINEER
 621 North 35th Street
 CORVALLIS, OREGON

May 24, 1948

2022

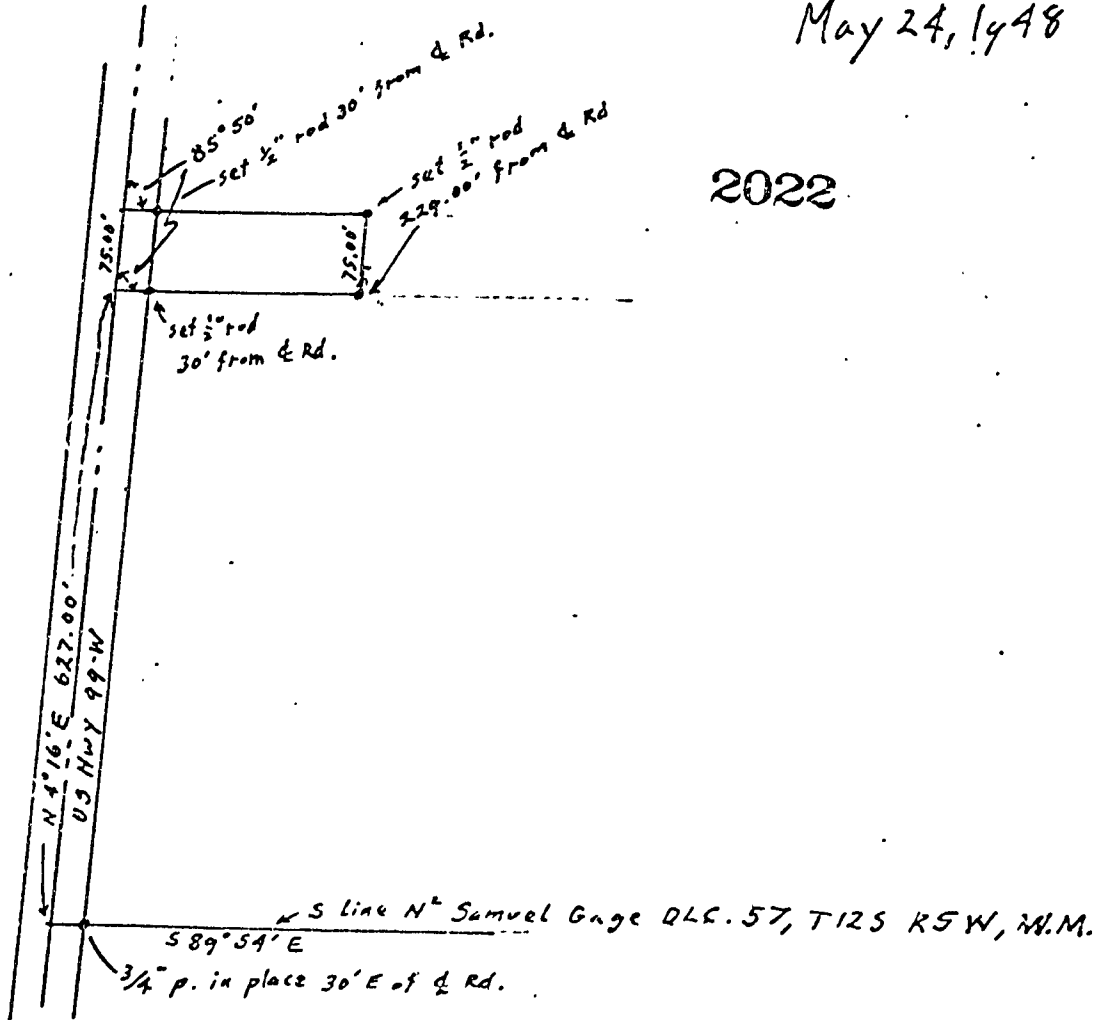

1" = 200'

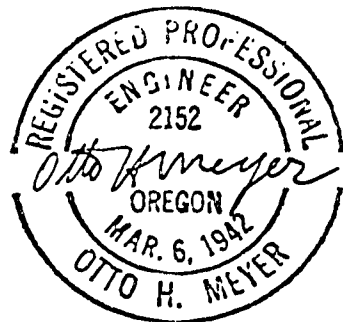

CS = 1.137