

Sec 1-14-8

C.S. # 127

For Bethel Vernon


12-8-48

2070

LINE DATE _____ PARTY _____

PROJECT _____

| Station | Dist | Angle | Dist | Curve | Dist | Dist |
|------------|-------|---------|-------|---------|-------|--------|
| 40 Cor 1 | | | | Rt. 294 | | 20.160 |
| 8 | 1.385 | +16°38' | 1.327 | | ✓ | |
| | | | | Rt. 066 | | |
| 7 | 4.440 | +19°52' | 4.176 | | 4.176 | 18.823 |
| | | | | Rt. 101 | | |
| 6 | 4.540 | +7°25' | 4.502 | | 4.502 | 14.657 |
| | | | | Rt. 235 | | |
| 5 | 6.920 | -6°31' | 6.884 | | 6.882 | 10.155 |
| | | | | Lt. 130 | | |
| 40 Cor (A) | 3.324 | -9°47' | 3.276 | | 3.273 | |
| 40 Cor | | | | Lt. 021 | | 20.328 |
| 4 | 5.965 | -6°50' | 5.923 | | 5.919 | 14.419 |
| | | | | Lt. 245 | | |
| 3 | 3.979 | -4°43' | 3.966 | | 3.937 | 10.482 |
| | | | | Rt. 232 | | |
| 2 | 1.477 | - | 1.477 | | 1.459 | 7.023 |
| | | | | - | | |
| 1 | 2.856 | +10° | 2.813 | | - | |
| | | | | - | | |
| 40 Cor (A) | 6.280 | +8°33' | 6.210 | | - | |

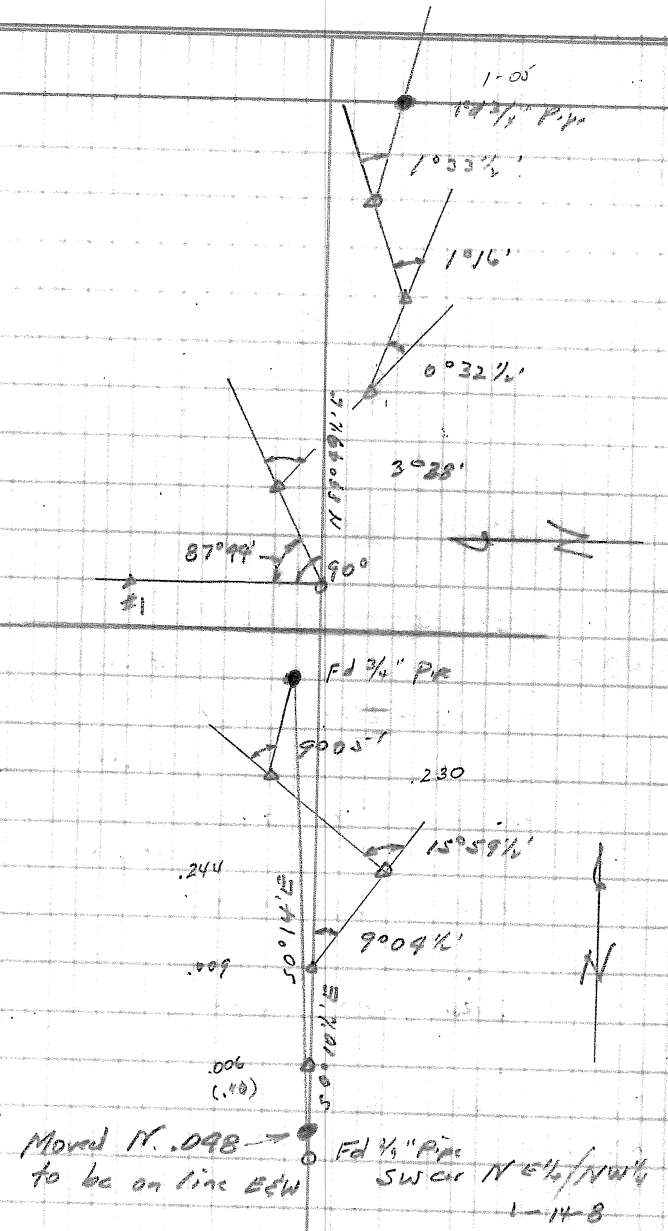

Moved N. 098 →
to be on line E&W
Fd 1/4" P.C.
SW 1/4 NW 1/4
1-14-8

LINE DATE

PARTY

PROJECT

KILBAM FORM 2-172

8000
3.880
-1.20
8.000
3.633
4.367

| | | | | | |
|--------|-------|---------|-------|---------|--------|
| 17 | | | | | |
| 16 | | | | | |
| 15 | 4.445 | -8°03' | 4.401 | | |
| 14 | 3.130 | -6°02' | 3.133 | | |
| 14 | 5.251 | -9°04' | 5.185 | | |
| 1 | | | | | |
| 40 Cor | | | | RT. 124 | 20.170 |
| 13 | 7.303 | -11°12' | 7.164 | RT. 209 | ✓ |
| 12 | 4.120 | -9°10' | 4.067 | RT. 134 | 4.066 |
| 12 | 4.353 | -16°25' | 4.172 | RT. 057 | 4.171 |
| 11 | 3.125 | -2°48' | 3.121 | | ✓ |
| 10 | 1.658 | +6°05' | 1.649 | | |
| 9 | | | | | |

