

C.S. # 2109

Hardcopy 10-7 # 19

also see notes in file

Sec 1-11-7

2109 C. S. # 159

4-28-49

Ms. Wells

For. B. N. Norton


LINE DATE PARTY

PROJECT

REMARK FORM

Sta	Tape	Slope	Hor. Dist	RT 017
4			0.16	
8	4 003	-3°03'	3 994	
7	2 071	-	2 071	
	6 890	-3°07'	6 879	
6	3 552	-3°23'	3 546	
5	1 844	+3°24'	1 841	
4	1 878	+12°22'	1 834	
3	2 935	+20°44'	2 745	0.54
2	5 605	+24°06'	5 083	
1	6 690	-9°22'	6 671	
	4 370	-7°55'	4 328	
	<u>162</u>			

25.976  
38.972  
34.976  
26.048  
22.502  
20.661  
18.827  
16.082  
10.999

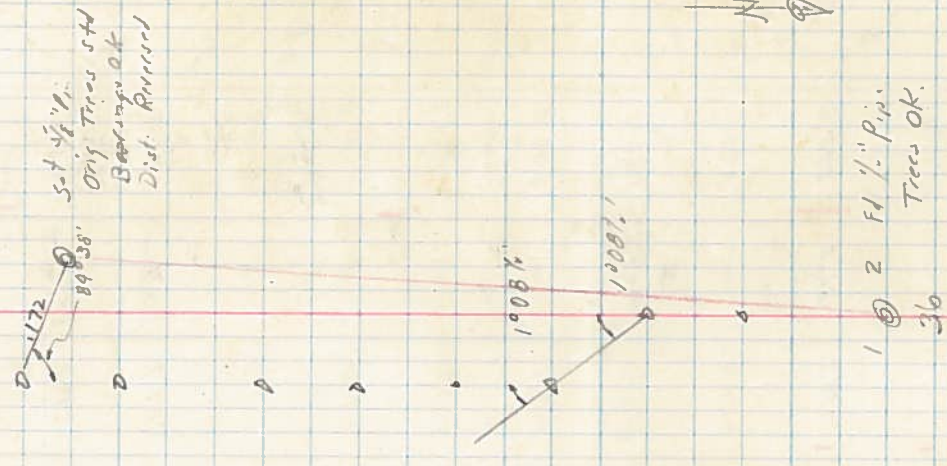


1 2 Fl 1/2" Pipe  
Trees OK.  
36

LINE DATE PARTY

PROJECT

18	2,709	+1128	2655	47739
	2550	-1592	2455	42129
17	1874	-	1874	33128
	7980	-17007	7627	30393
16	2756	-706	2735	28130
15	2265	+2038	2263	23748
14	4516	-14000	4382	20089
13	3738	-11947	3659	17744
12	2354	-	2345	9777
11	7985	+3052	7967	017
10	6225	-	6225	040
9	3555	+2018	3552	✓
8			41019	271

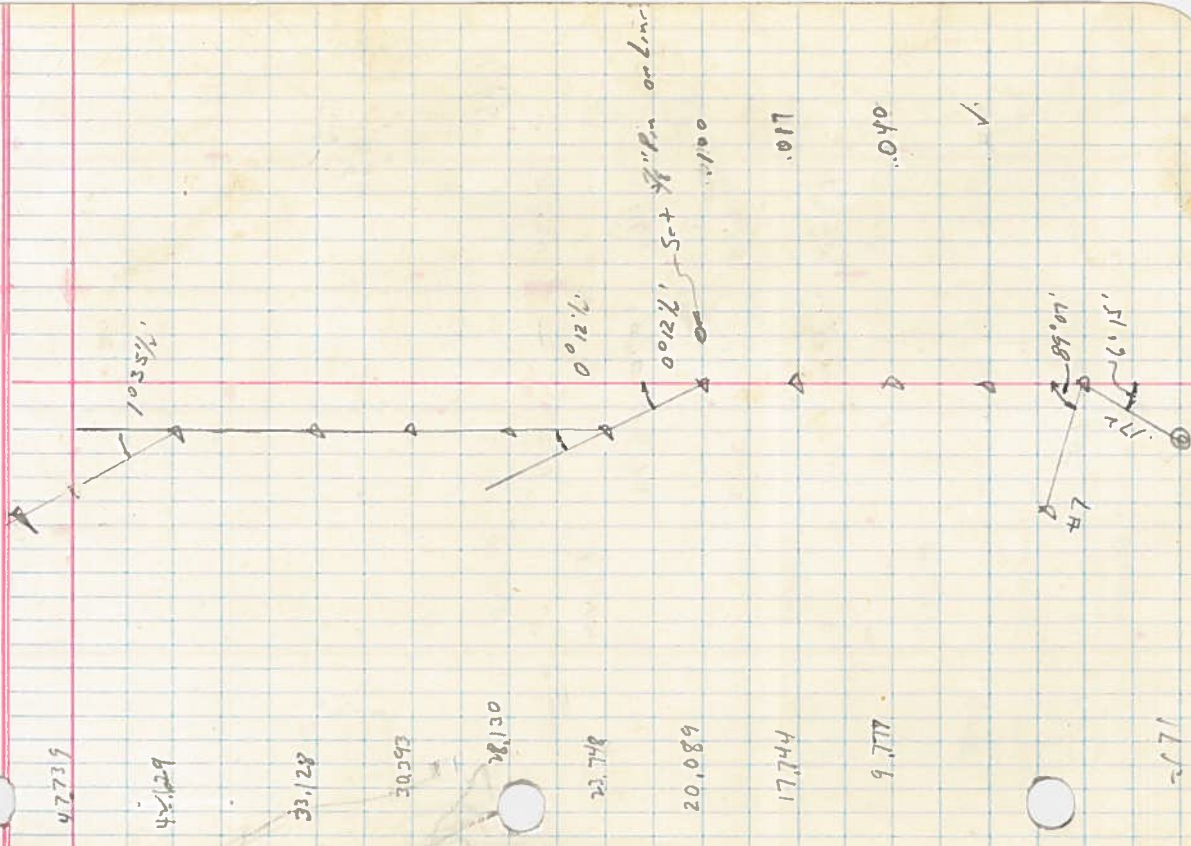

LINE DATE PARTY

PROJECT


MARK FORM 172

1800

16	0.324	—	.324	R1.457
20	7.465	+8°10'	7.399	R10.447
22	3.808	+11°08'	3.726	
21	1.478	+7°39'	1.415	R1.368
20	7.018	+5°50'	6.982	R1.271
	7.570	+6°36'	7.460	.74505
19	5.154	+3°38'	5.144	41.014
18				41.155

(Had been dug out for post hole)  
 8 1/2" Pipe out  
 set from water  
 B-Block for LB' N 75° E  
 .230

80.234  
 79.910  
 72.521  
 68.785  
 60.338  
 52.883  
 47.739

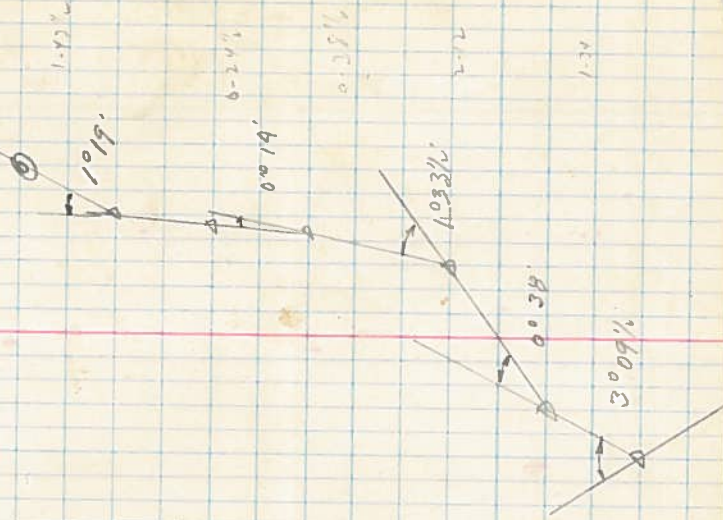

1.34