


2139

Original



2133

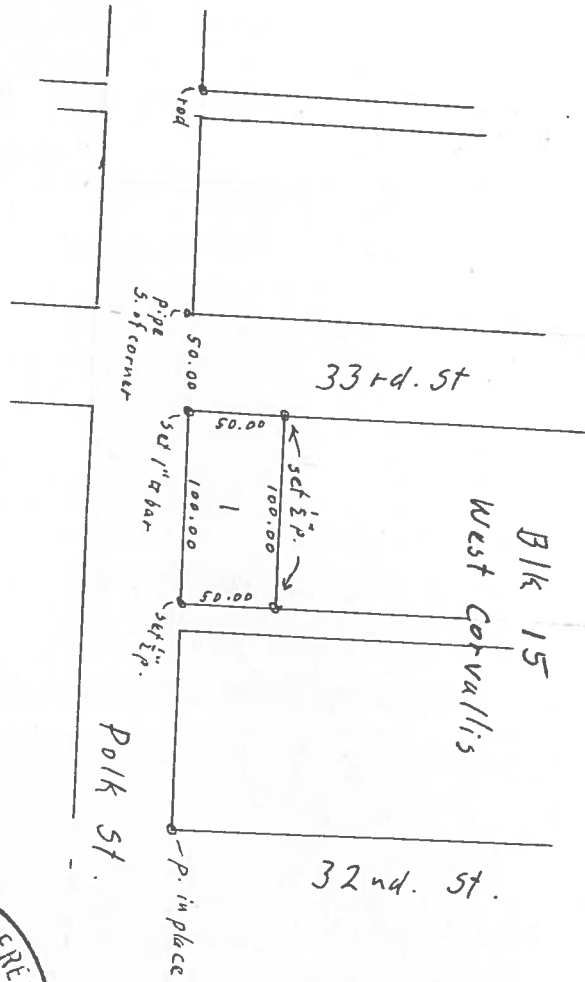