


OTTO H. MEYER
CIVIL ENGINEER
621 North 35th Street
CORVALLIS, OREGON

2143

Oct. 2, 1949

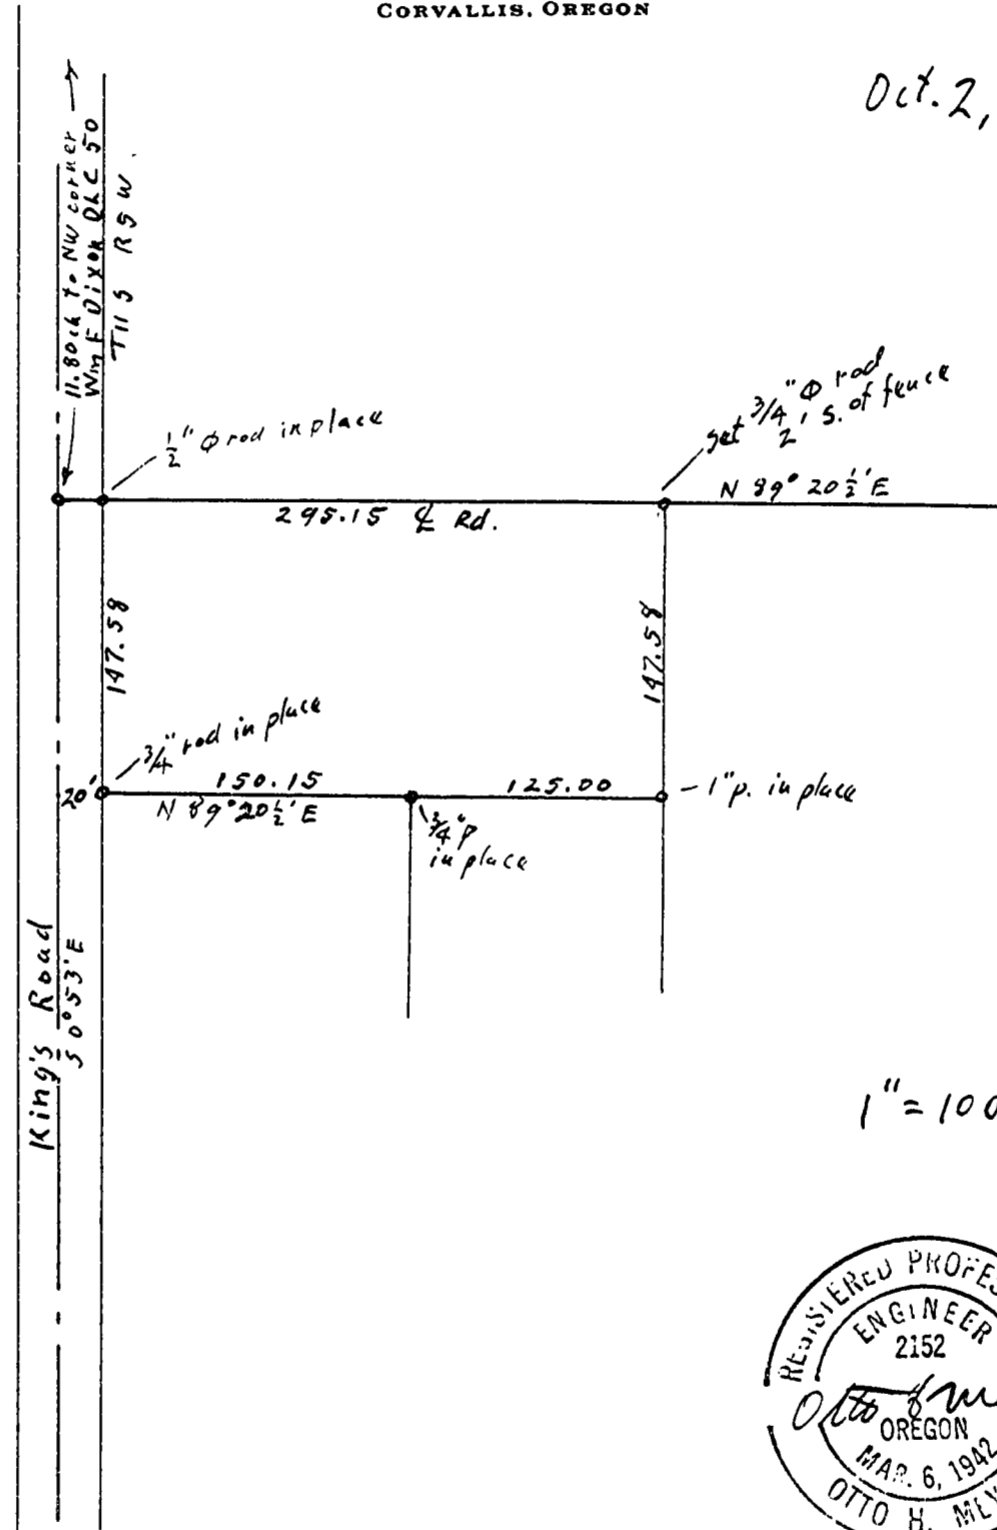

OTTO H. MEYER
CIVIL ENGINEER
621 North 85th Street
CORVALLIS, OREGON

2143

Oct. 2, 1949

