

also see notes in file

Cl. 39-11.5

C.S. # 81

4-18-50

* Wright

For Lynn Flint


2190

LINE DATE _____ PARTY _____

PROJECT

SHANNON STODT

5	1.036	—	1.036
	8.000	-1°41'	7.997
4	3.114	+2°55'	3.110
	5.530	-3°08'	5.522
	8.000	-4°00'	7.980
3	_____		
	5.867	+1°49'	5.864
	10.000	—	1.000
	8.000	-0°30'	7.999
	6.089	+0°26'	6.098
2	2.364	+6°50'	2.347
	8.000	+6°42'	7.945
1	_____		

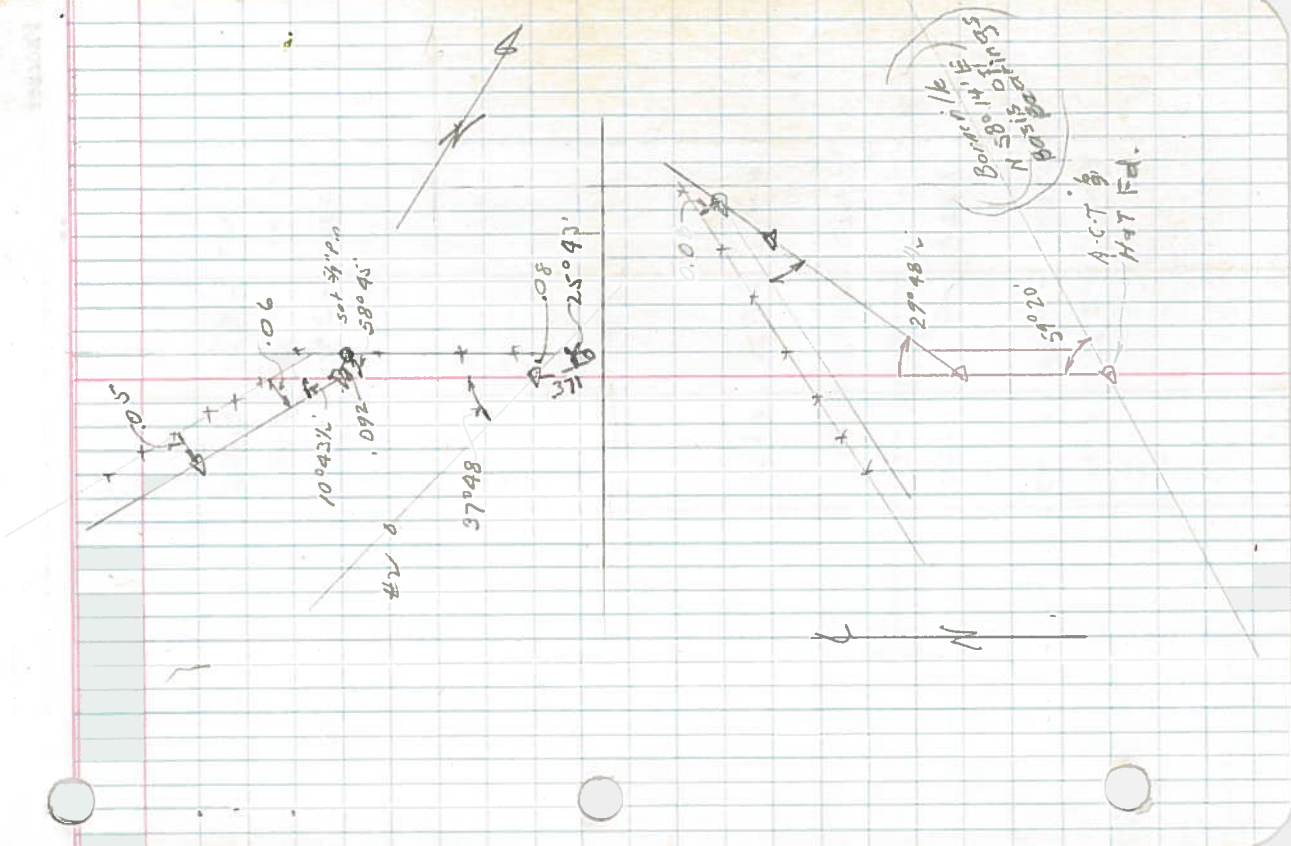

LINE DATE PARTY

PROJECT

KILHAM FORM P-172

100055

9

0.757 -17°29' 0.722
 8000 -3°08' 7.988
 8000 -3°43' 7.983

16-693

8

5.462 -0°32' 5.461

7


7

1.824 - 1.824

6

5.350 -1°48' 5.347
 8000 -3°25' 7.986

5

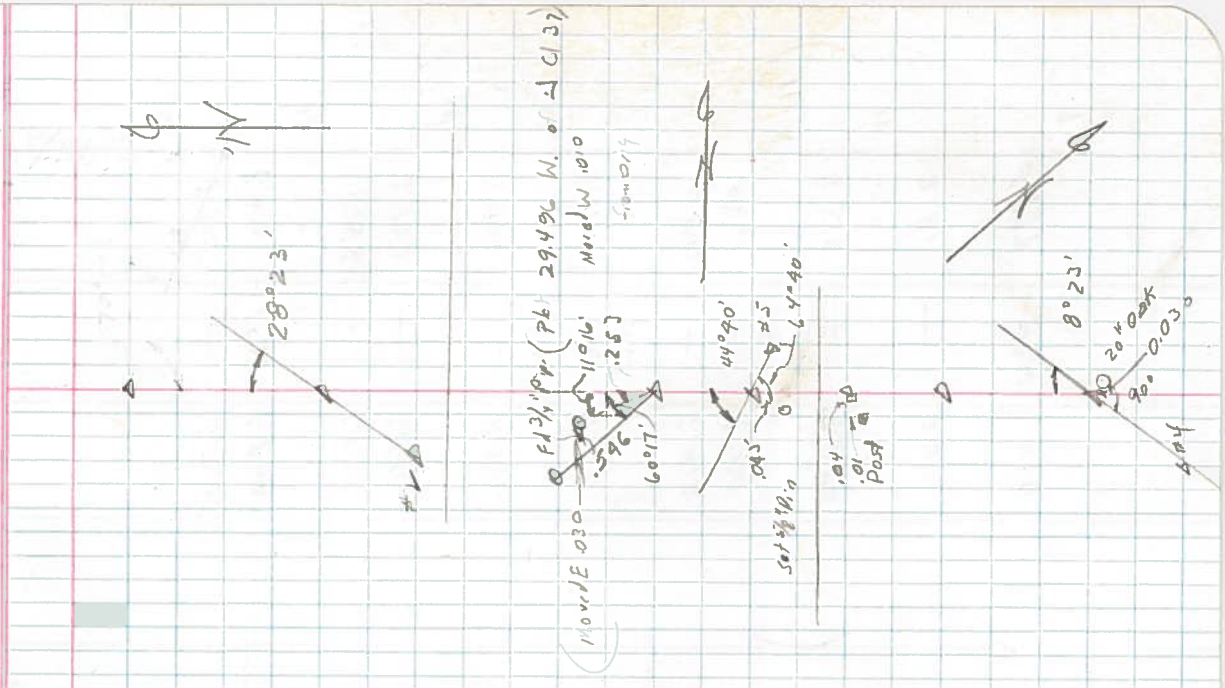


PROJECT _____ LINE DATE _____ PARTY _____

KILHAM FORM P-172

180095

16	6.325	-	6.305
15	6.900	- 1020	6.898
	1.155	-	1.155
	6.900	-	6.900
14	4.846	-	4.846
13	2.910	-	2.910
12	6.412	-	6.412
	8.000	-	8.000
(11-A	3.858	-	3.858
11	2.810	-	2.810
10	5.877	- 30/4	5.868
9			

Note: -
Move caused by
error in computer
New Position OK

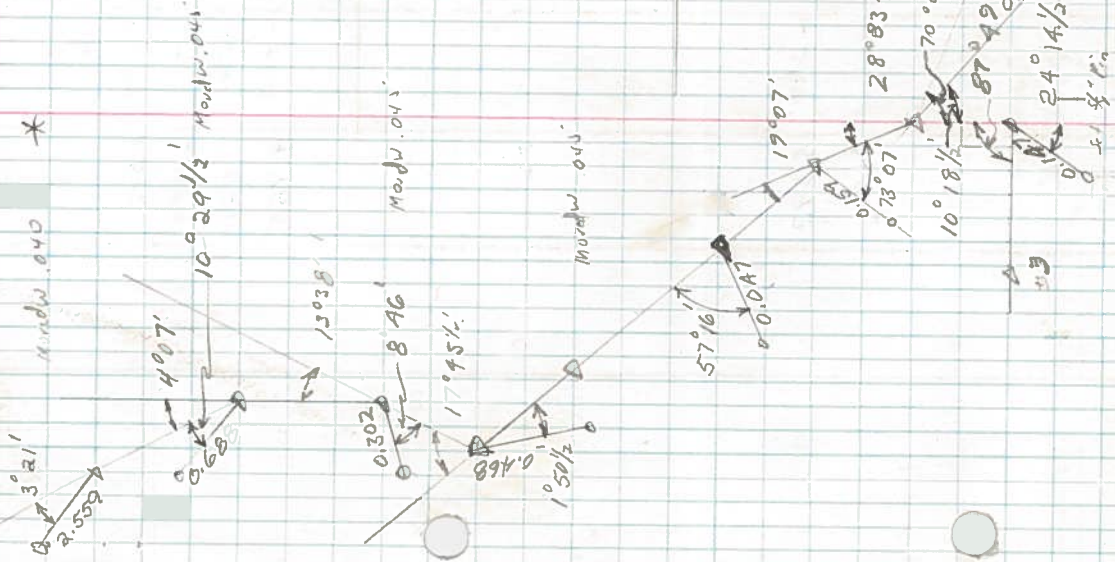

LINE DATE PARTY

PROJECT

KILHAM FORM P-172

180055

F1 Gun bbl, set 5/4' p.m. over.				
6900	13041	6.890		
6934	--	6.934		
6902	-391	6.886		
4797	-903	4.785		

|

3/6" p.p.c

6100 - 500' 6.092

16

