


C.S. # 2196

Philomath Farming Lots

Blk. 3 Lot 11

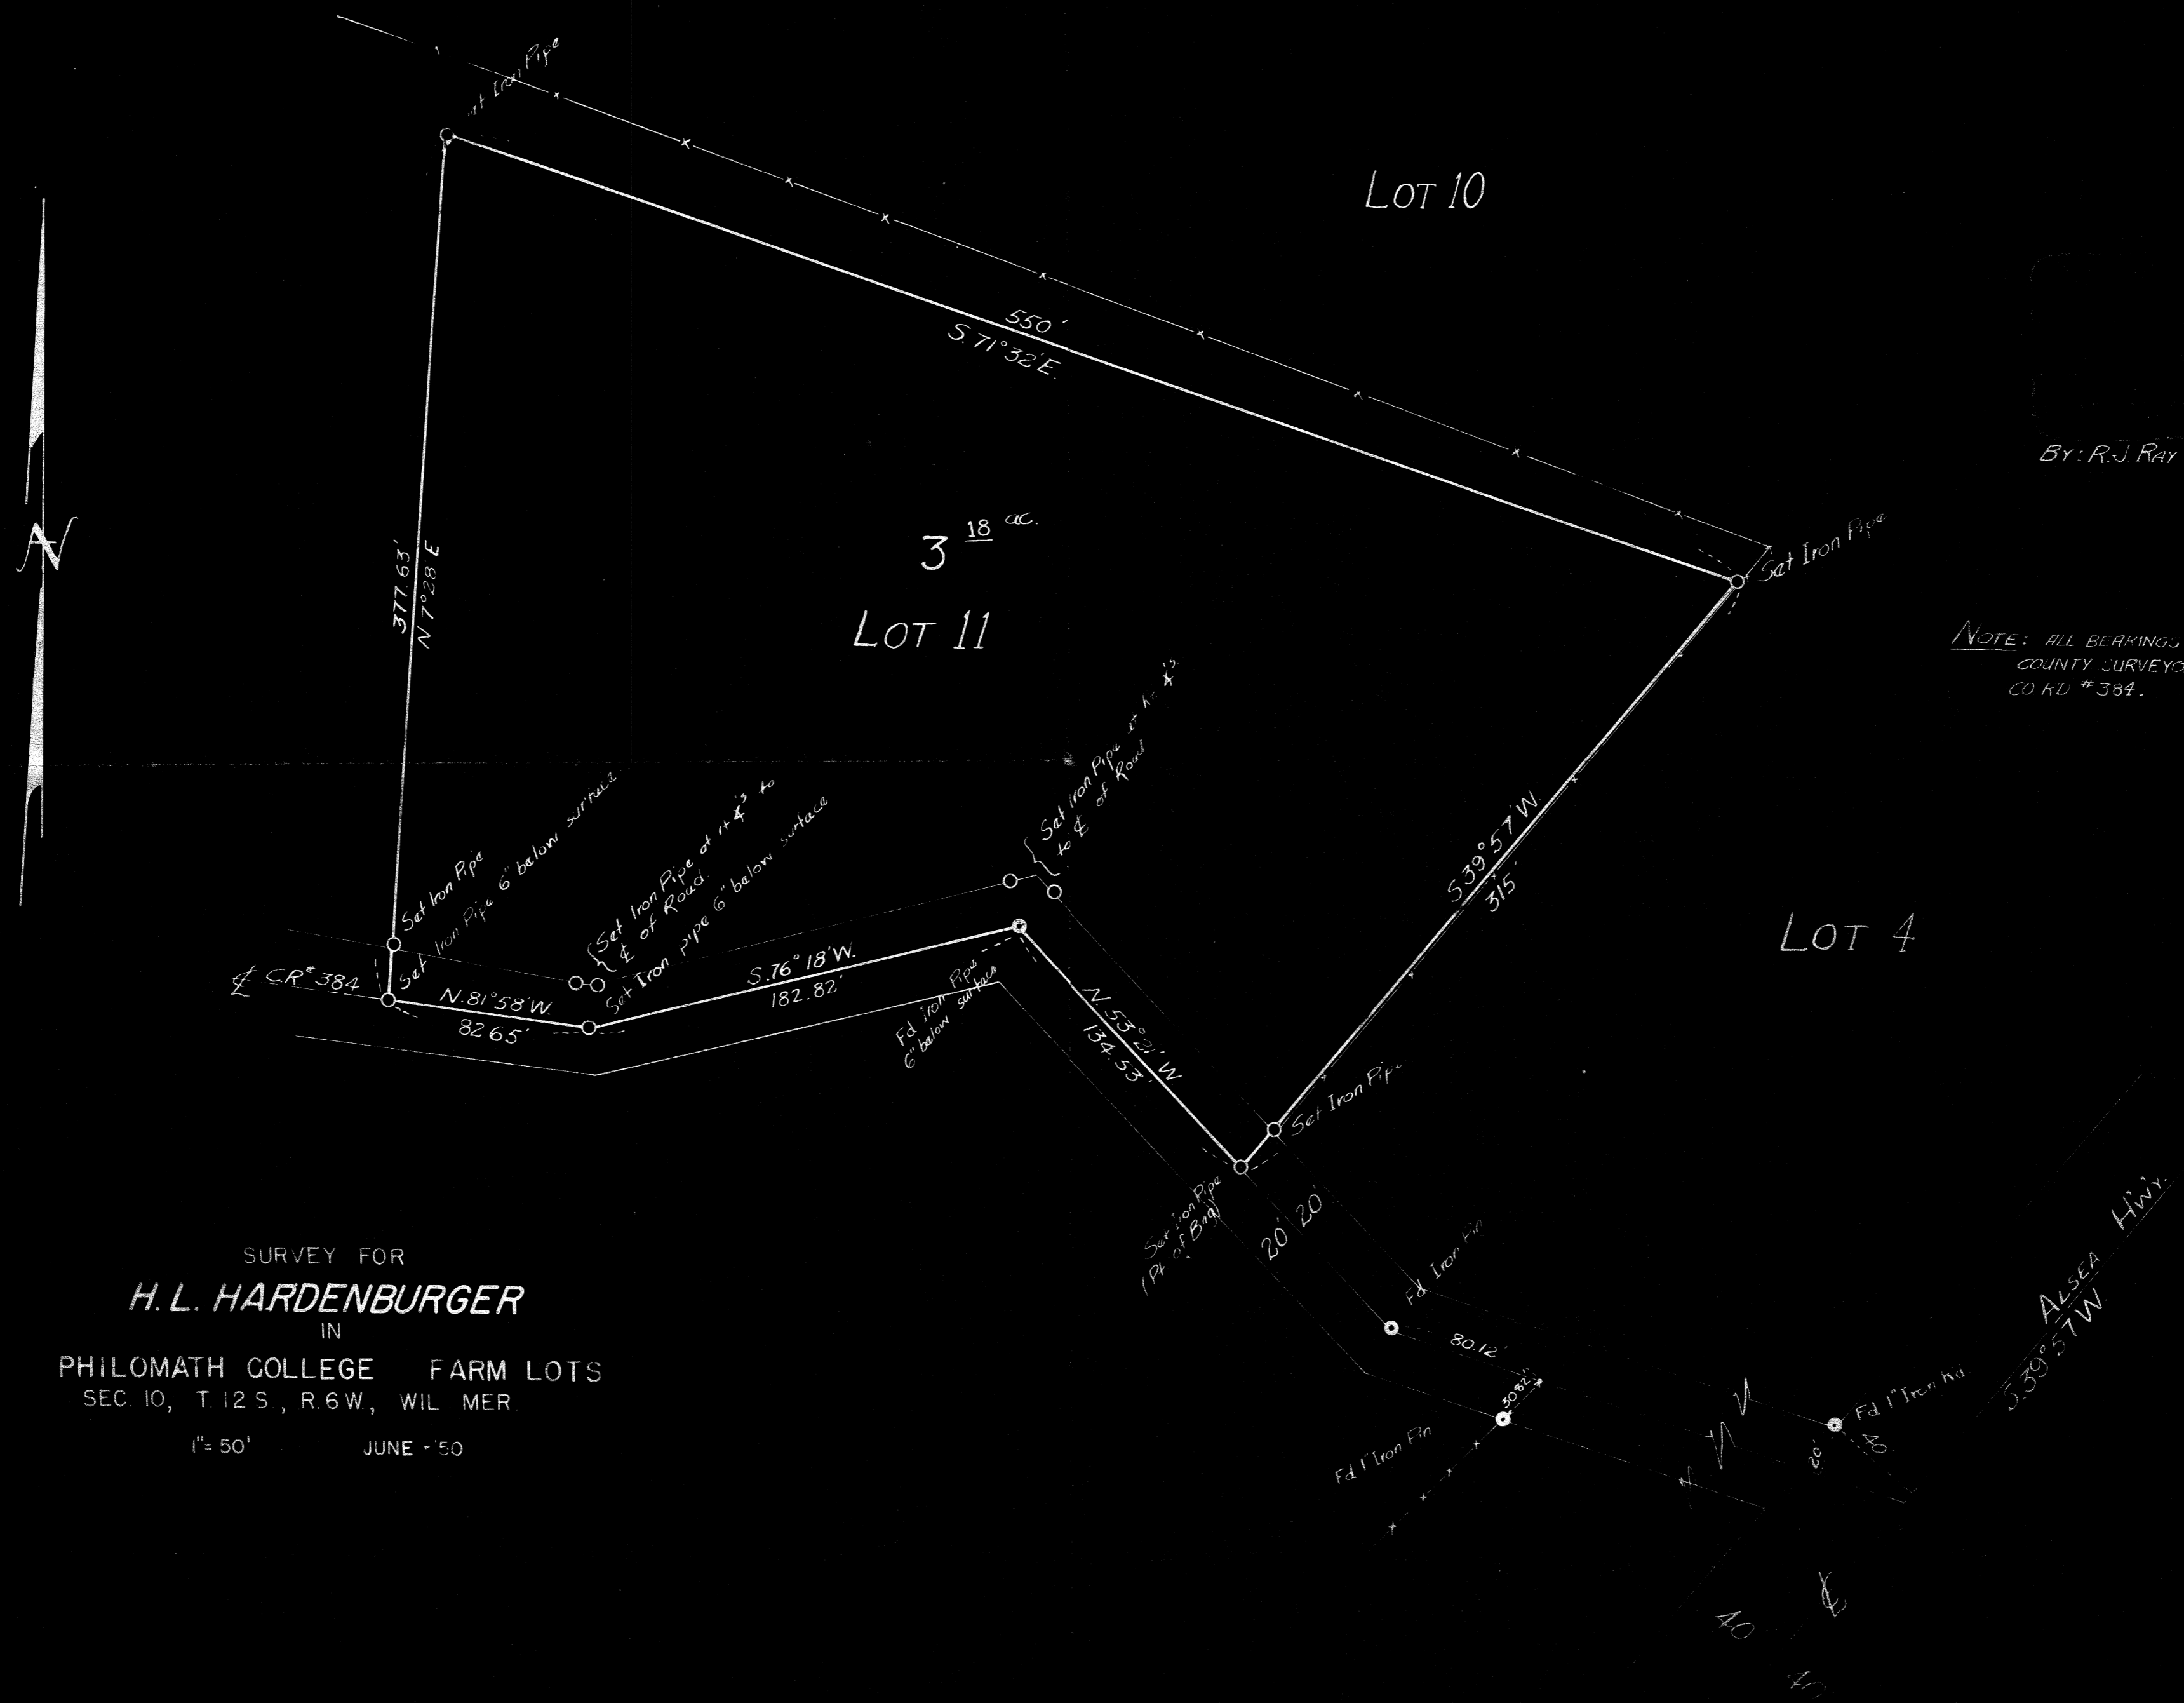

SURVEY FOR
H. L. HARDENBURGER
 IN
 PHILOMATH COLLEGE FARM LOTS
 SEC. 10, T. 12 S., R. 6 W., WIL. MER.
 1" = 50' JUNE - '50

By: R. J. Ray 6/30/50

NOTE: ALL BEARINGS BASED ON COUNTY SURVEYOR'S PLAT OF CO. RD. # 384.