


2204

C.S. No. 2204  
Sec. 26, T10S, R4W, W.M.  
For Floyd Whitaker  
Scale 1"=3chs. June 21, 1950

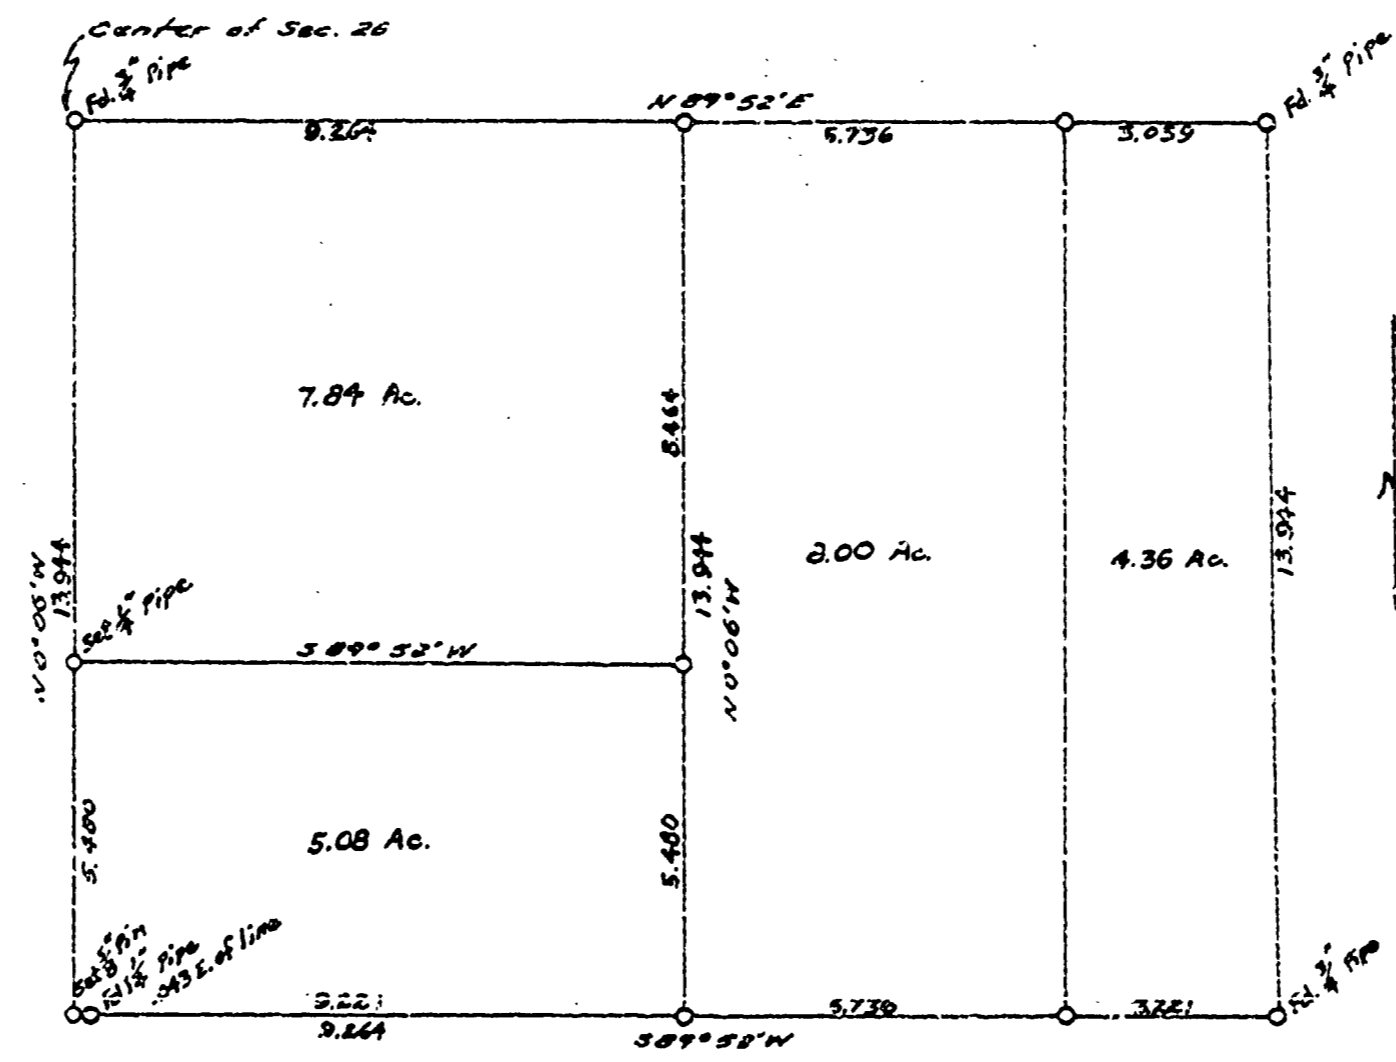

OREGON  
LAND SURVEYOR  
*Curtis E. Hanson*  
CURTIS E. HANSON  
161


2204

COUNTY SURVEY # 2204

C.S. No. 2204  
 Sec. 26, T10S, R4W, W.M.  
 For Floyd Whitaker

Scale 1"=3chs.

June 21, 1950

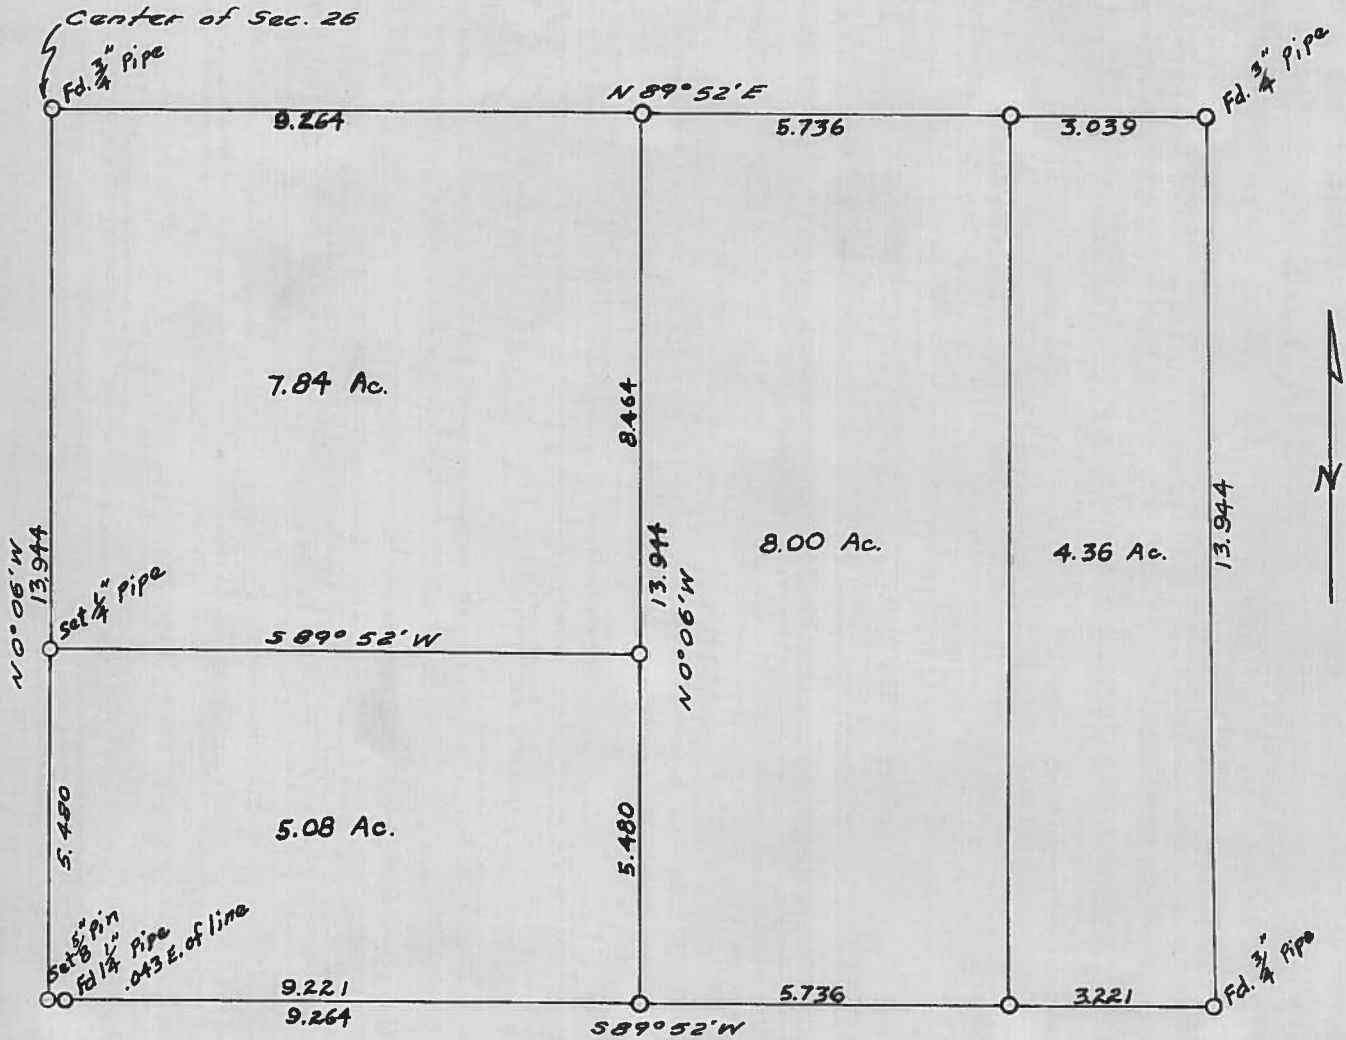

REGISTERED  
 OREGON  
 LAND SURVEYOR

*Curtis C. Hanson*

NOVEMBER 9, 1945  
 CURTIS C. HANSON  
 161

2204  
Sec 26-10-4  
CS 283

For Floyd blizzard

