

PLEASANT VIEW FRUIT FARMS AND ADJACENT AREA

1" = 400'


NW Corner Geo. W. Bethers D.L.C. No. 49
T 12 S, R 5 W, W.M., & N.W. corner
of Plat, pipe in place

N. Line D.L.C. No. 49
N 89° 42' 1/2" E
(N. line of Plat is N 89° 59' E)

NE. corner
D.L.C. 49
3/4" p. in place

SW corner
Prior Scott
D.L.C. stone
in place.

set 3/4" p. 40' W &
14.52' N of SW
corner Prior Scott

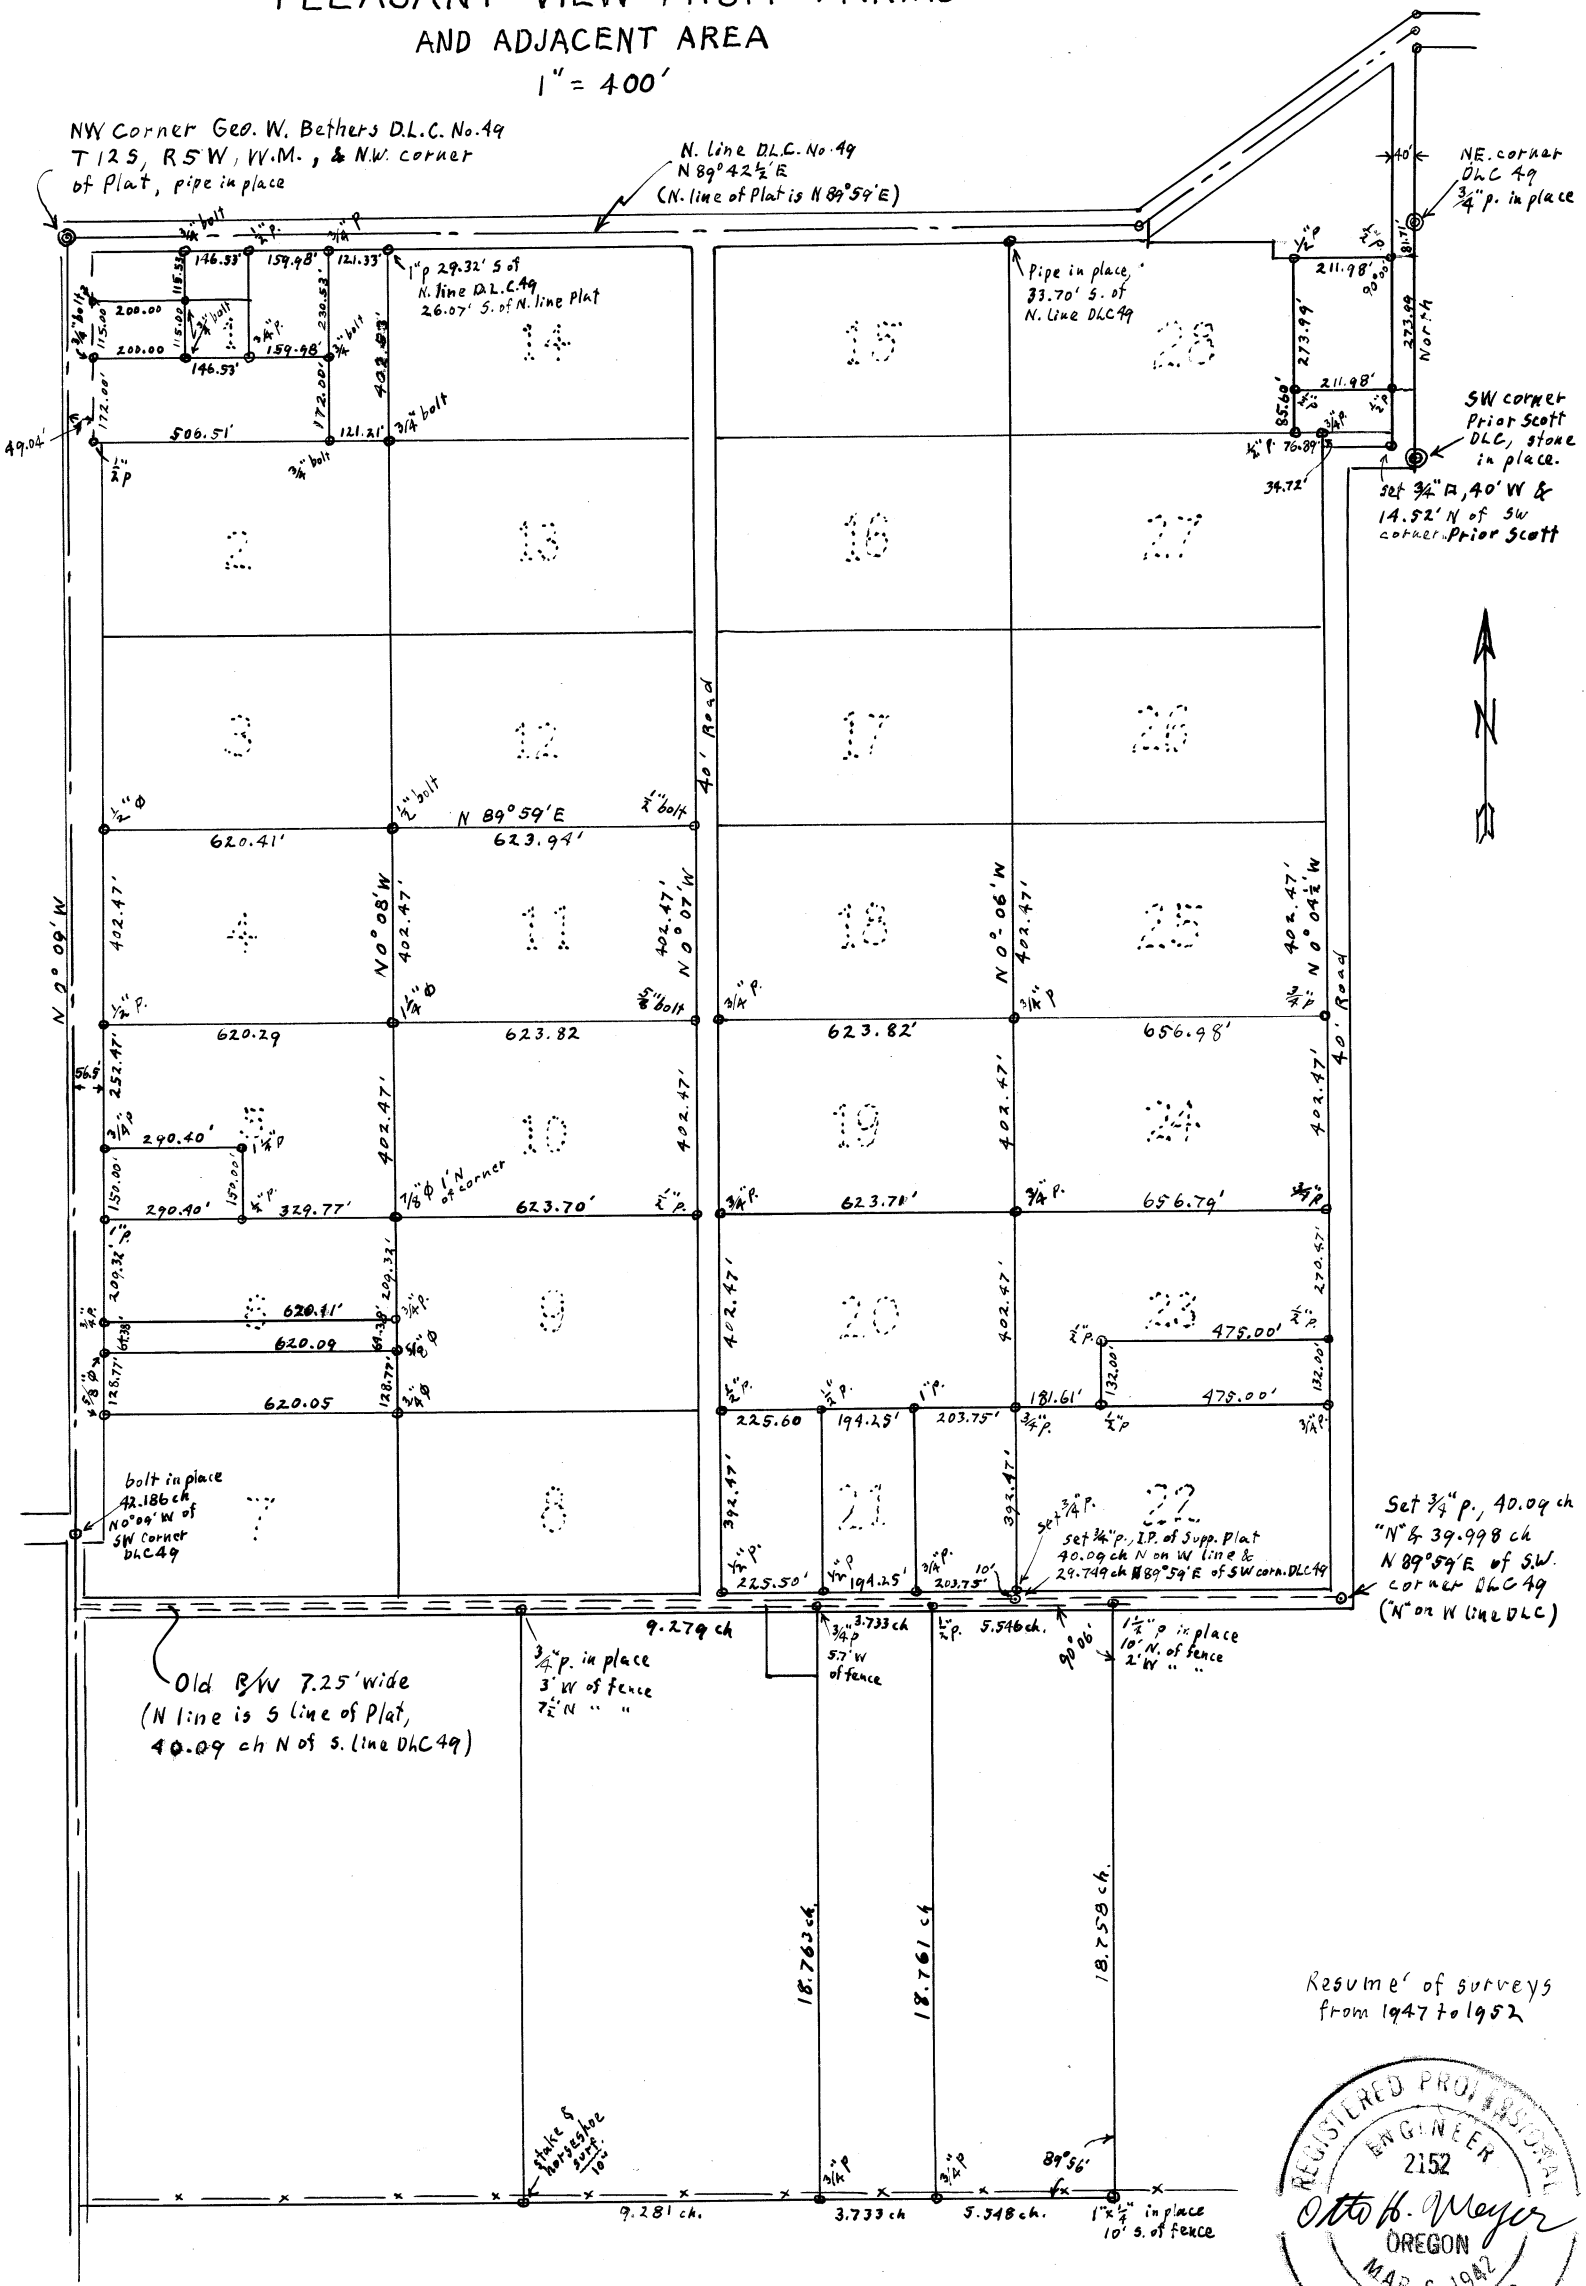

bolt in place
42.186 ch
N 0° 09' W of
SW corner
D.L.C. 49

Old R/W 7.25' wide
(N line is S line of Plat,
40.09 ch N of S. line D.L.C. 49)

Set 3/4" p. 40.09 ch
"N" & 39.998 ch
N 89° 59' E of SW
corner D.L.C. 49
(N or W line D.L.C.)

Resume' of surveys
from 1947 to 1952

REGISTERED PROFESSIONAL
ENGINEER
2152
Otto H. Meyer
OREGON
MAR. 6, 1942
OTTO H. MIYER

July 8, 1952

2403