


DARWIN WOODCOCK

LOTS 10 and 11, BLOCK 8, WEST CORVALLIS

Scale: 1" = 50'


July 25, 1952

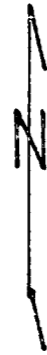

REGISTERED
OREGON
LAND SURVEYOR

Martin L. Beyerlein

NOV. 5 1948
MARTIN L. BEYERLEIN
247

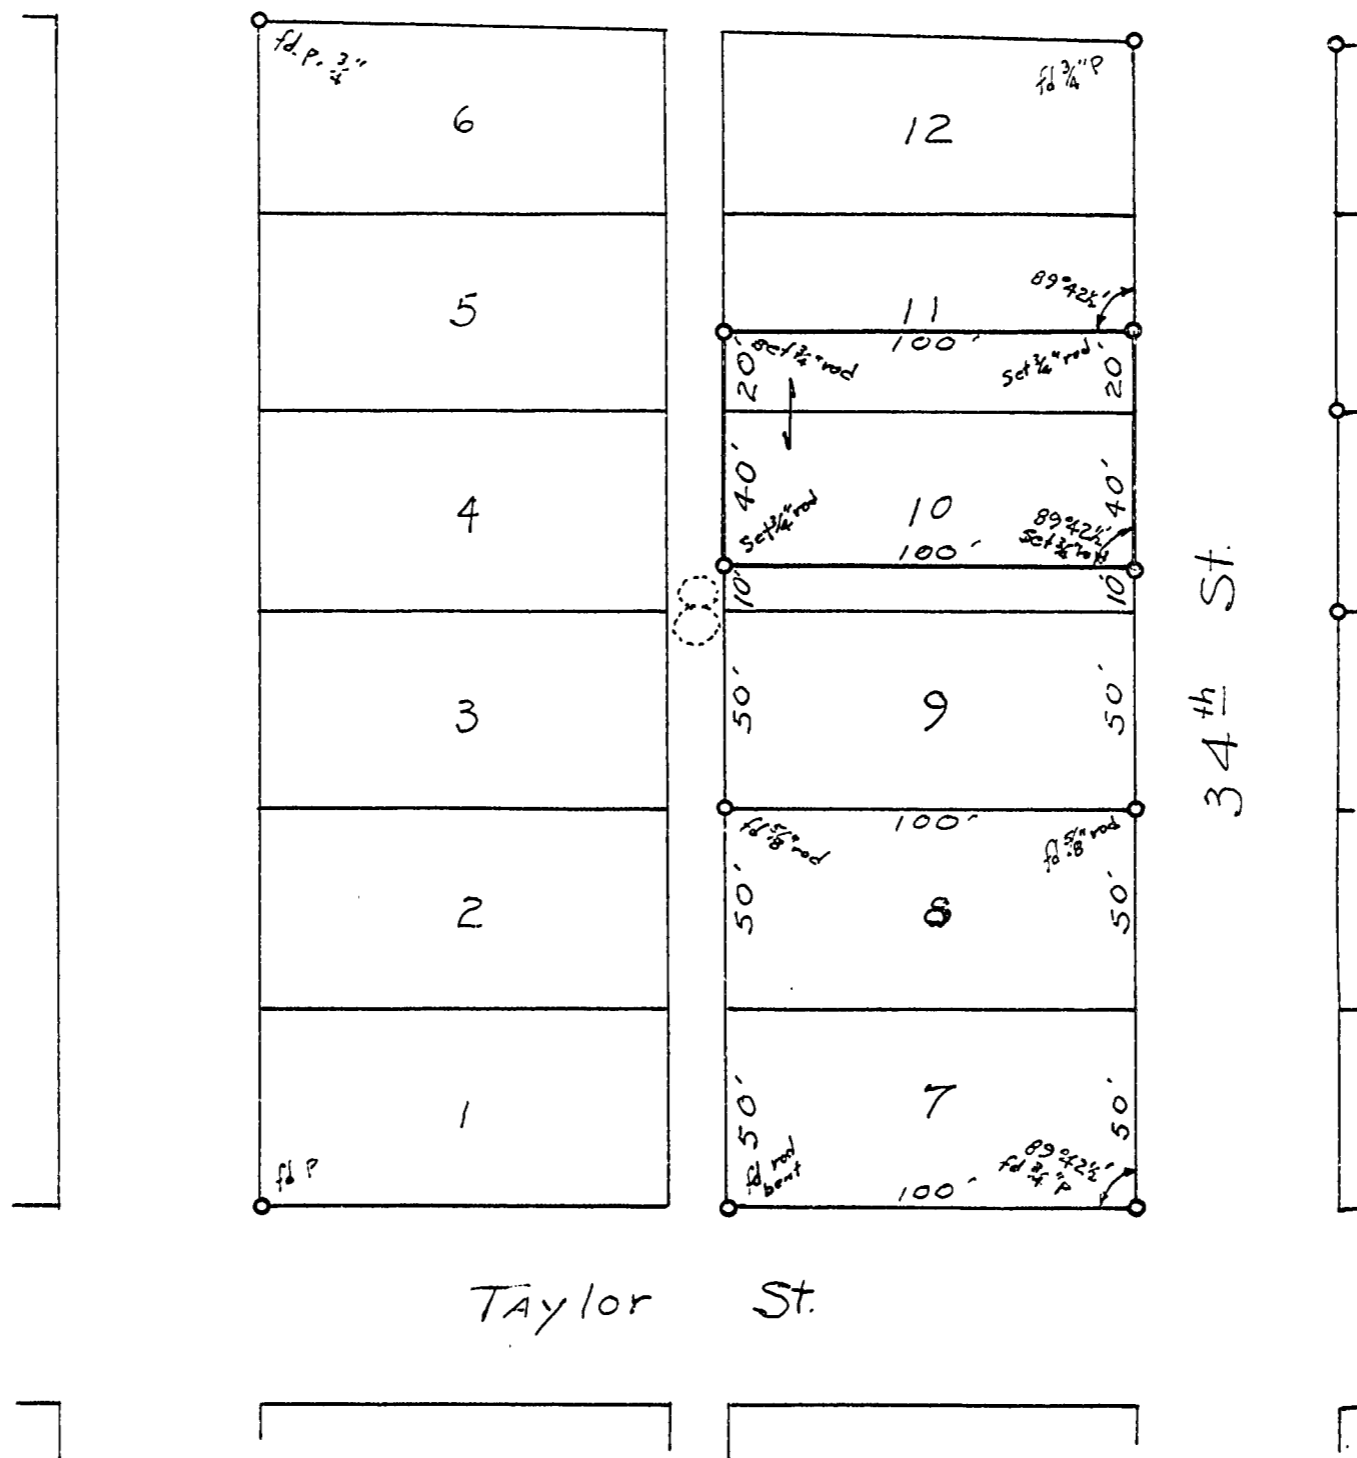

2412



LINE DATE July 25, 1952 PARTY *Beyerlein P*

Ames


PROJECT *D. M. Woodcock*

180085

KILHAM FORM P-172

CS = 52.67

S 20' Lot 11 & N 40' Lot 10 BIK 17
West Corvallis Adm

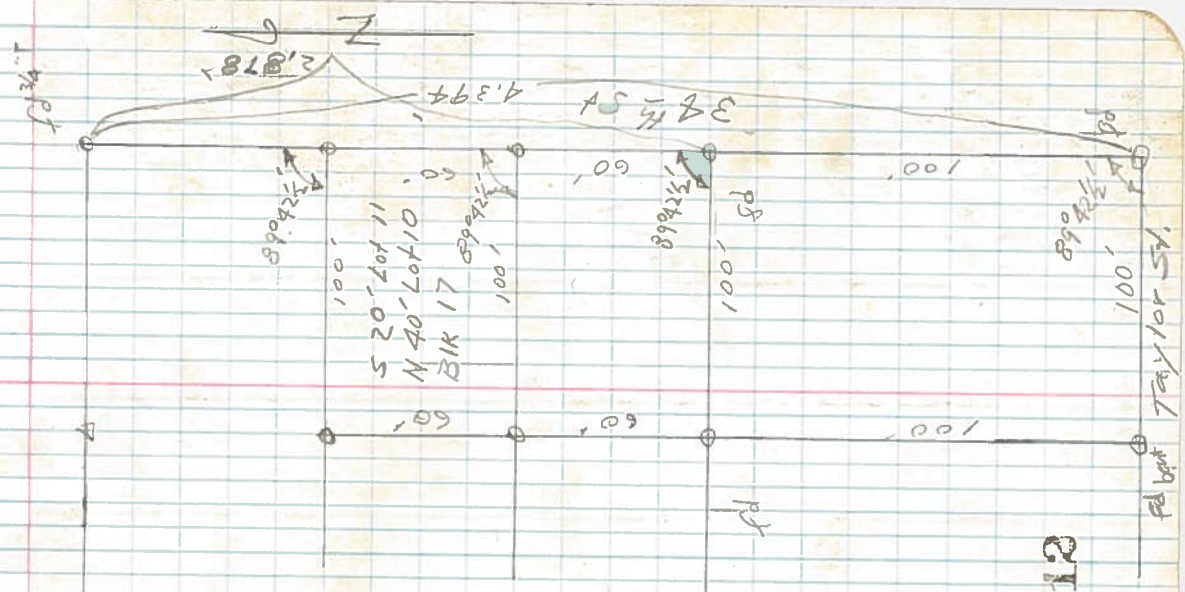

2412