


FRED OETJEN


PRIER SCOTT D.L.C. No. 44, T. 12 S., R. 5 W., W.M.

Scale: 1" = 50'

June 8, 1953

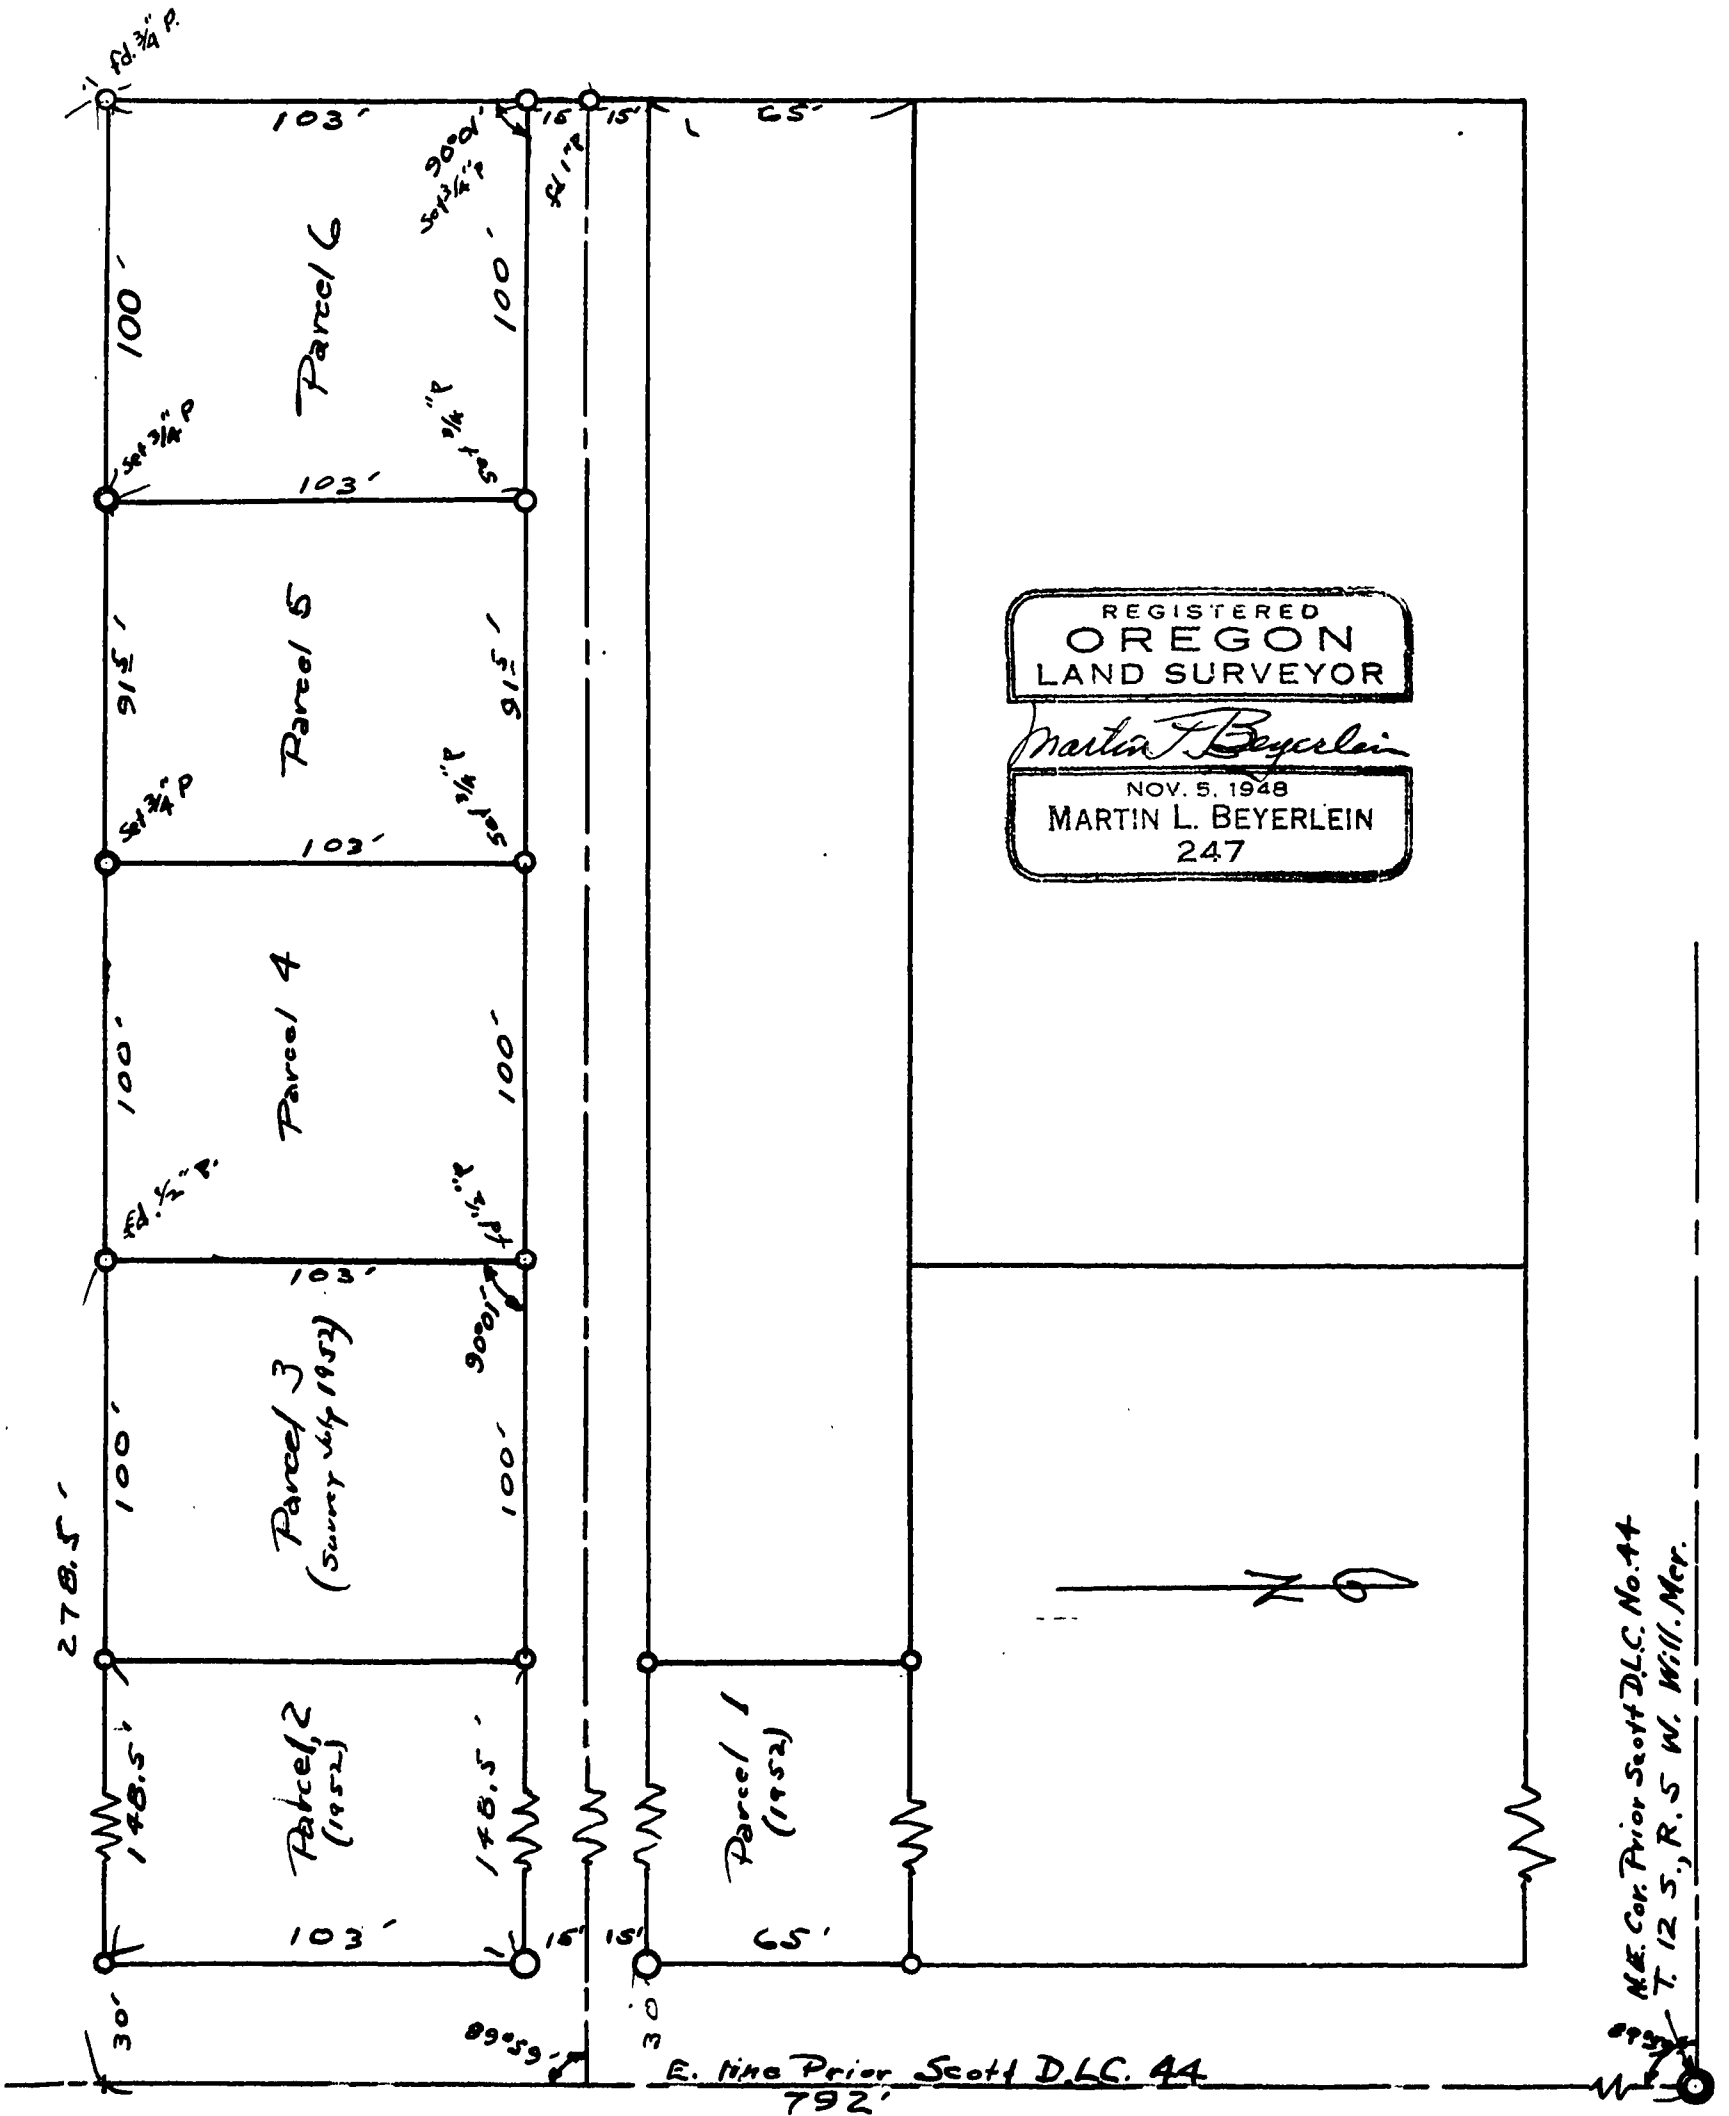

REGISTERED
OREGON
LAND SURVEYOR
Martin L. Beyerlein
NOV. 5, 1948
MARTIN L. BEYERLEIN
247

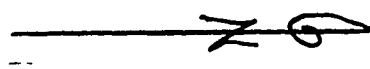

N.E. Cor. Prier Scott D.L.C. No. 44
T. 12 S., R. 5 W., Will. Mer.

E. line Prier Scott D.L.C. 44
792'