



CHARLES S. BENNETT

WILLIAM F. DIXON D.L.C.No.50, TWP. 11 S., R. 5 W., WILL. MER.

SCALE: 1 in. = 50 ft.

2498

JULY 23, 1953.

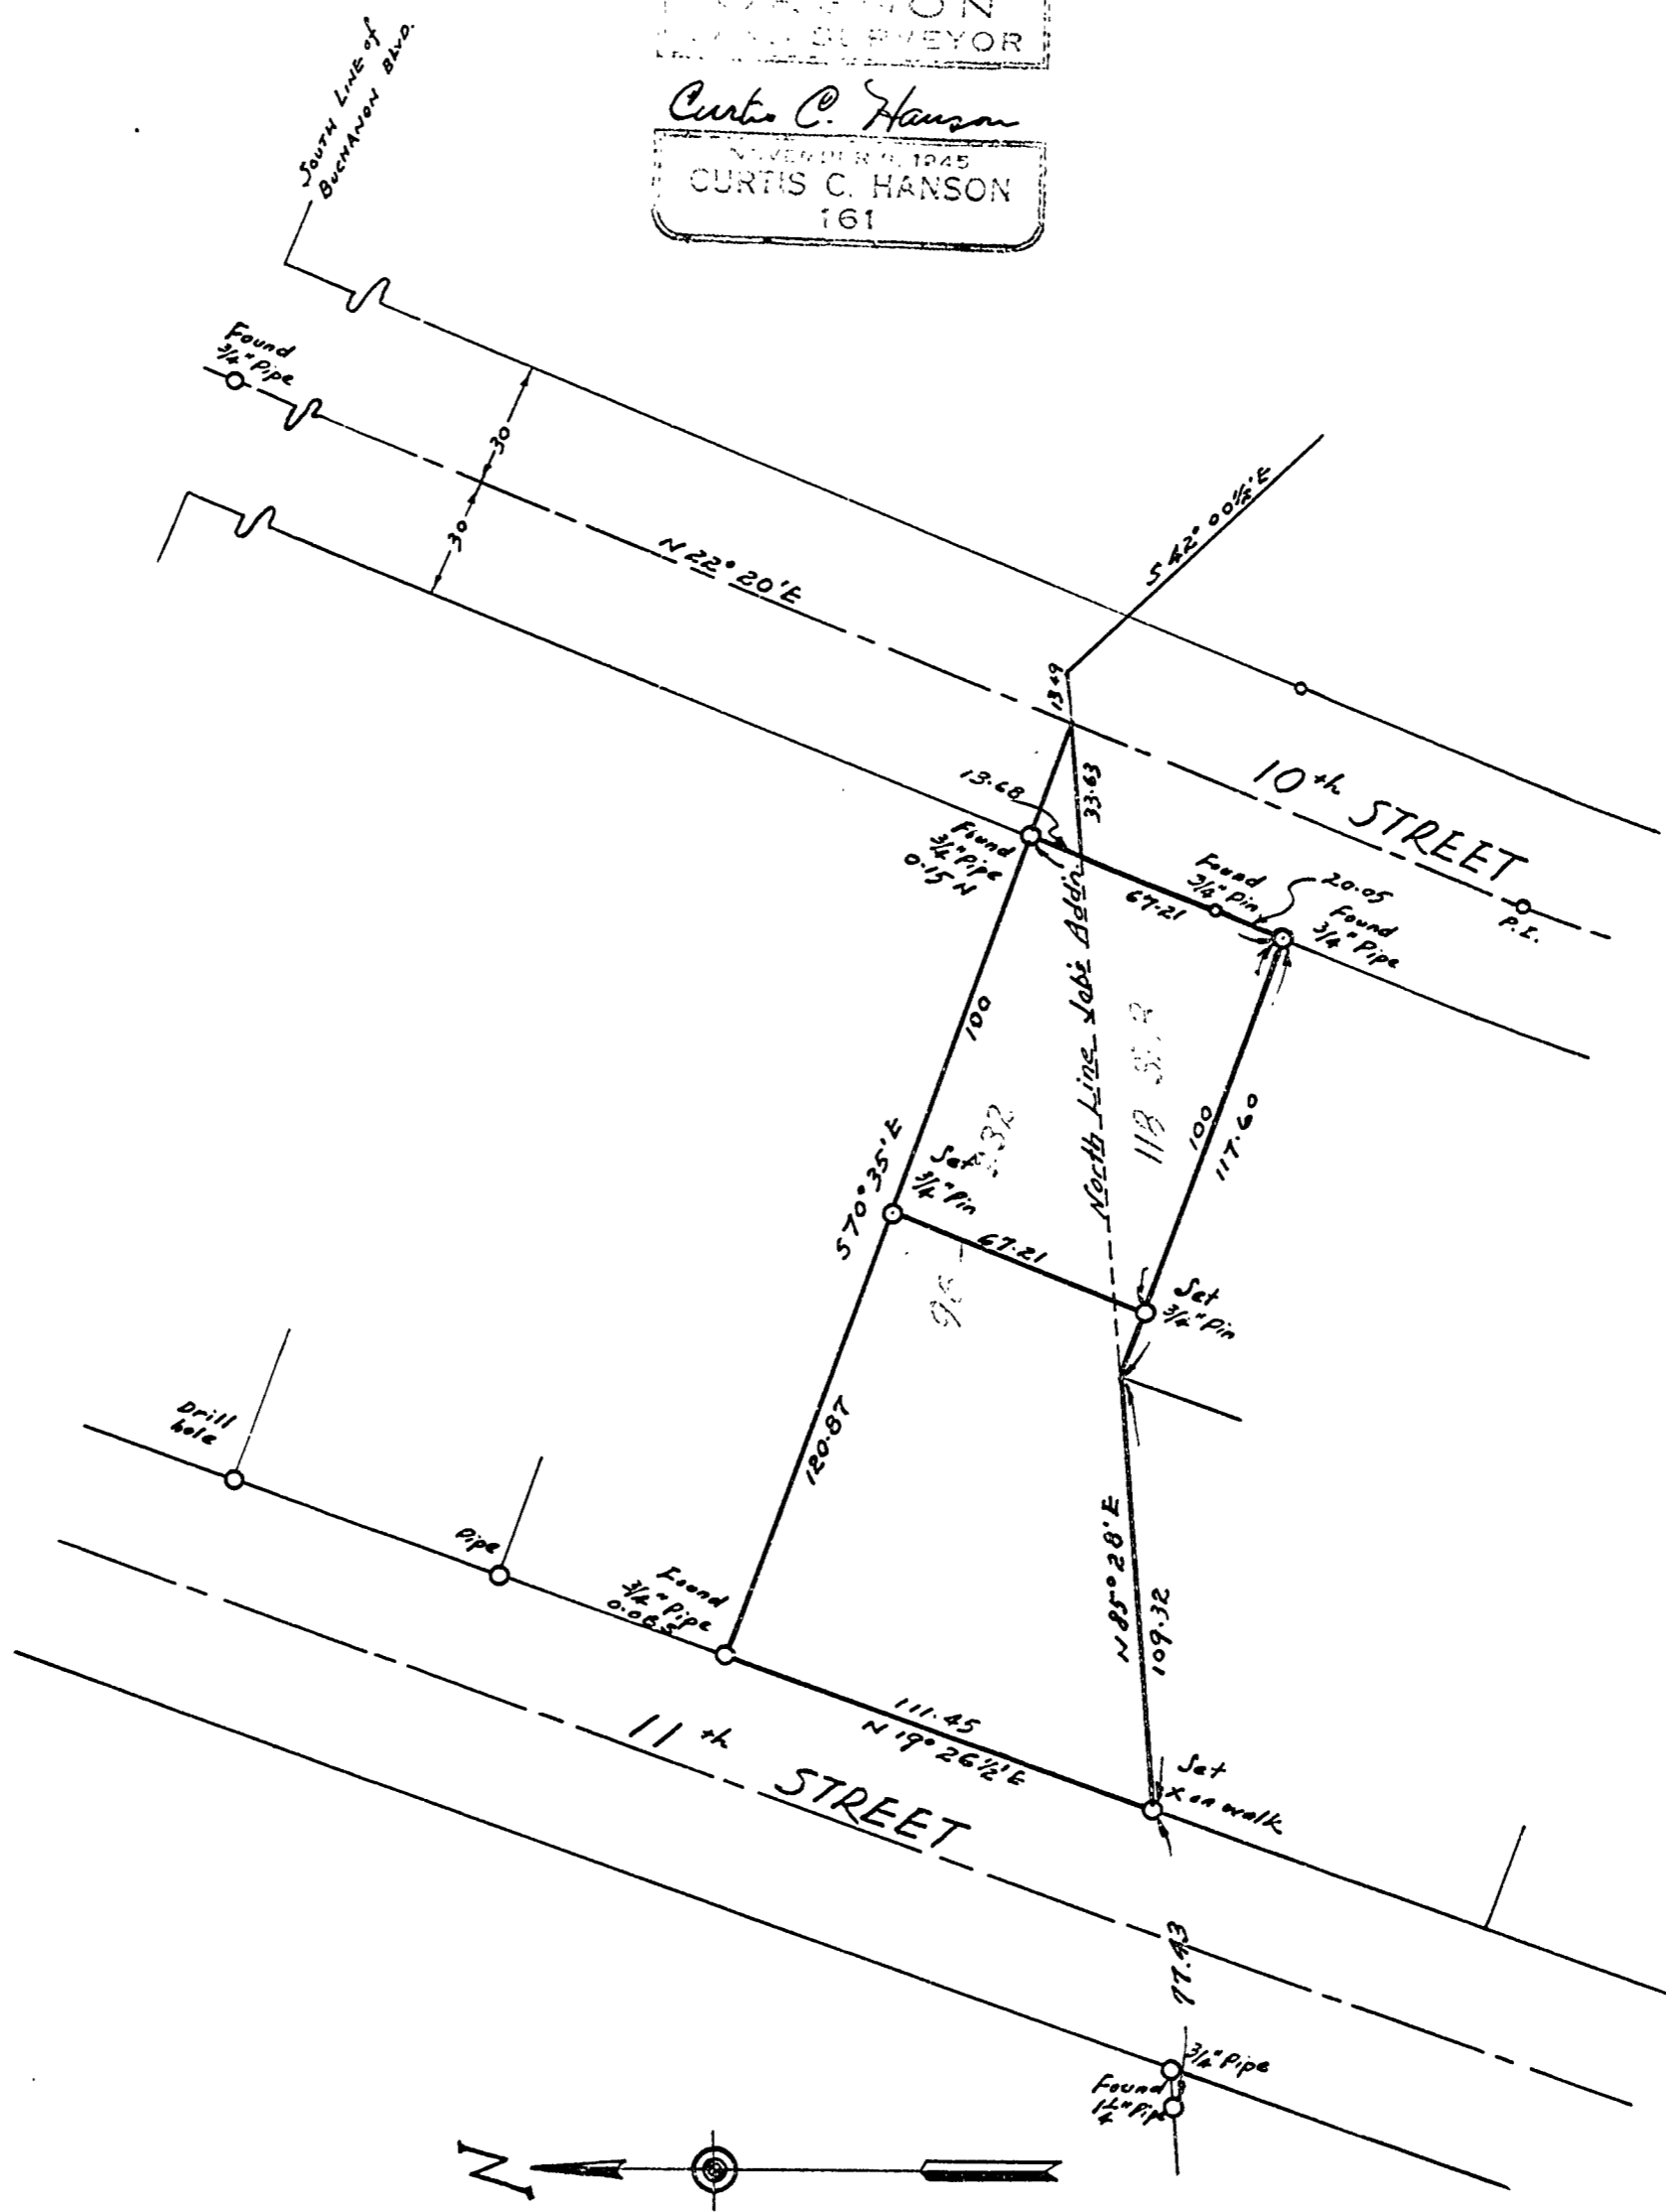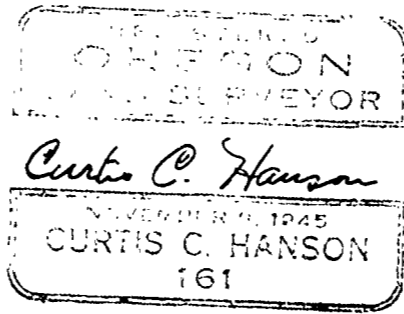

Jobs Addn
Adjacent

2498

7-23-53

Fw C.S. Bennett

7/2

