


C. E. WHITEMAN

JOHN STEWART D.L.C. NO. 49, T. 11S., R. 5W., WILL. MER.

SCALE: 1" = 50' JUNE 8, 1954

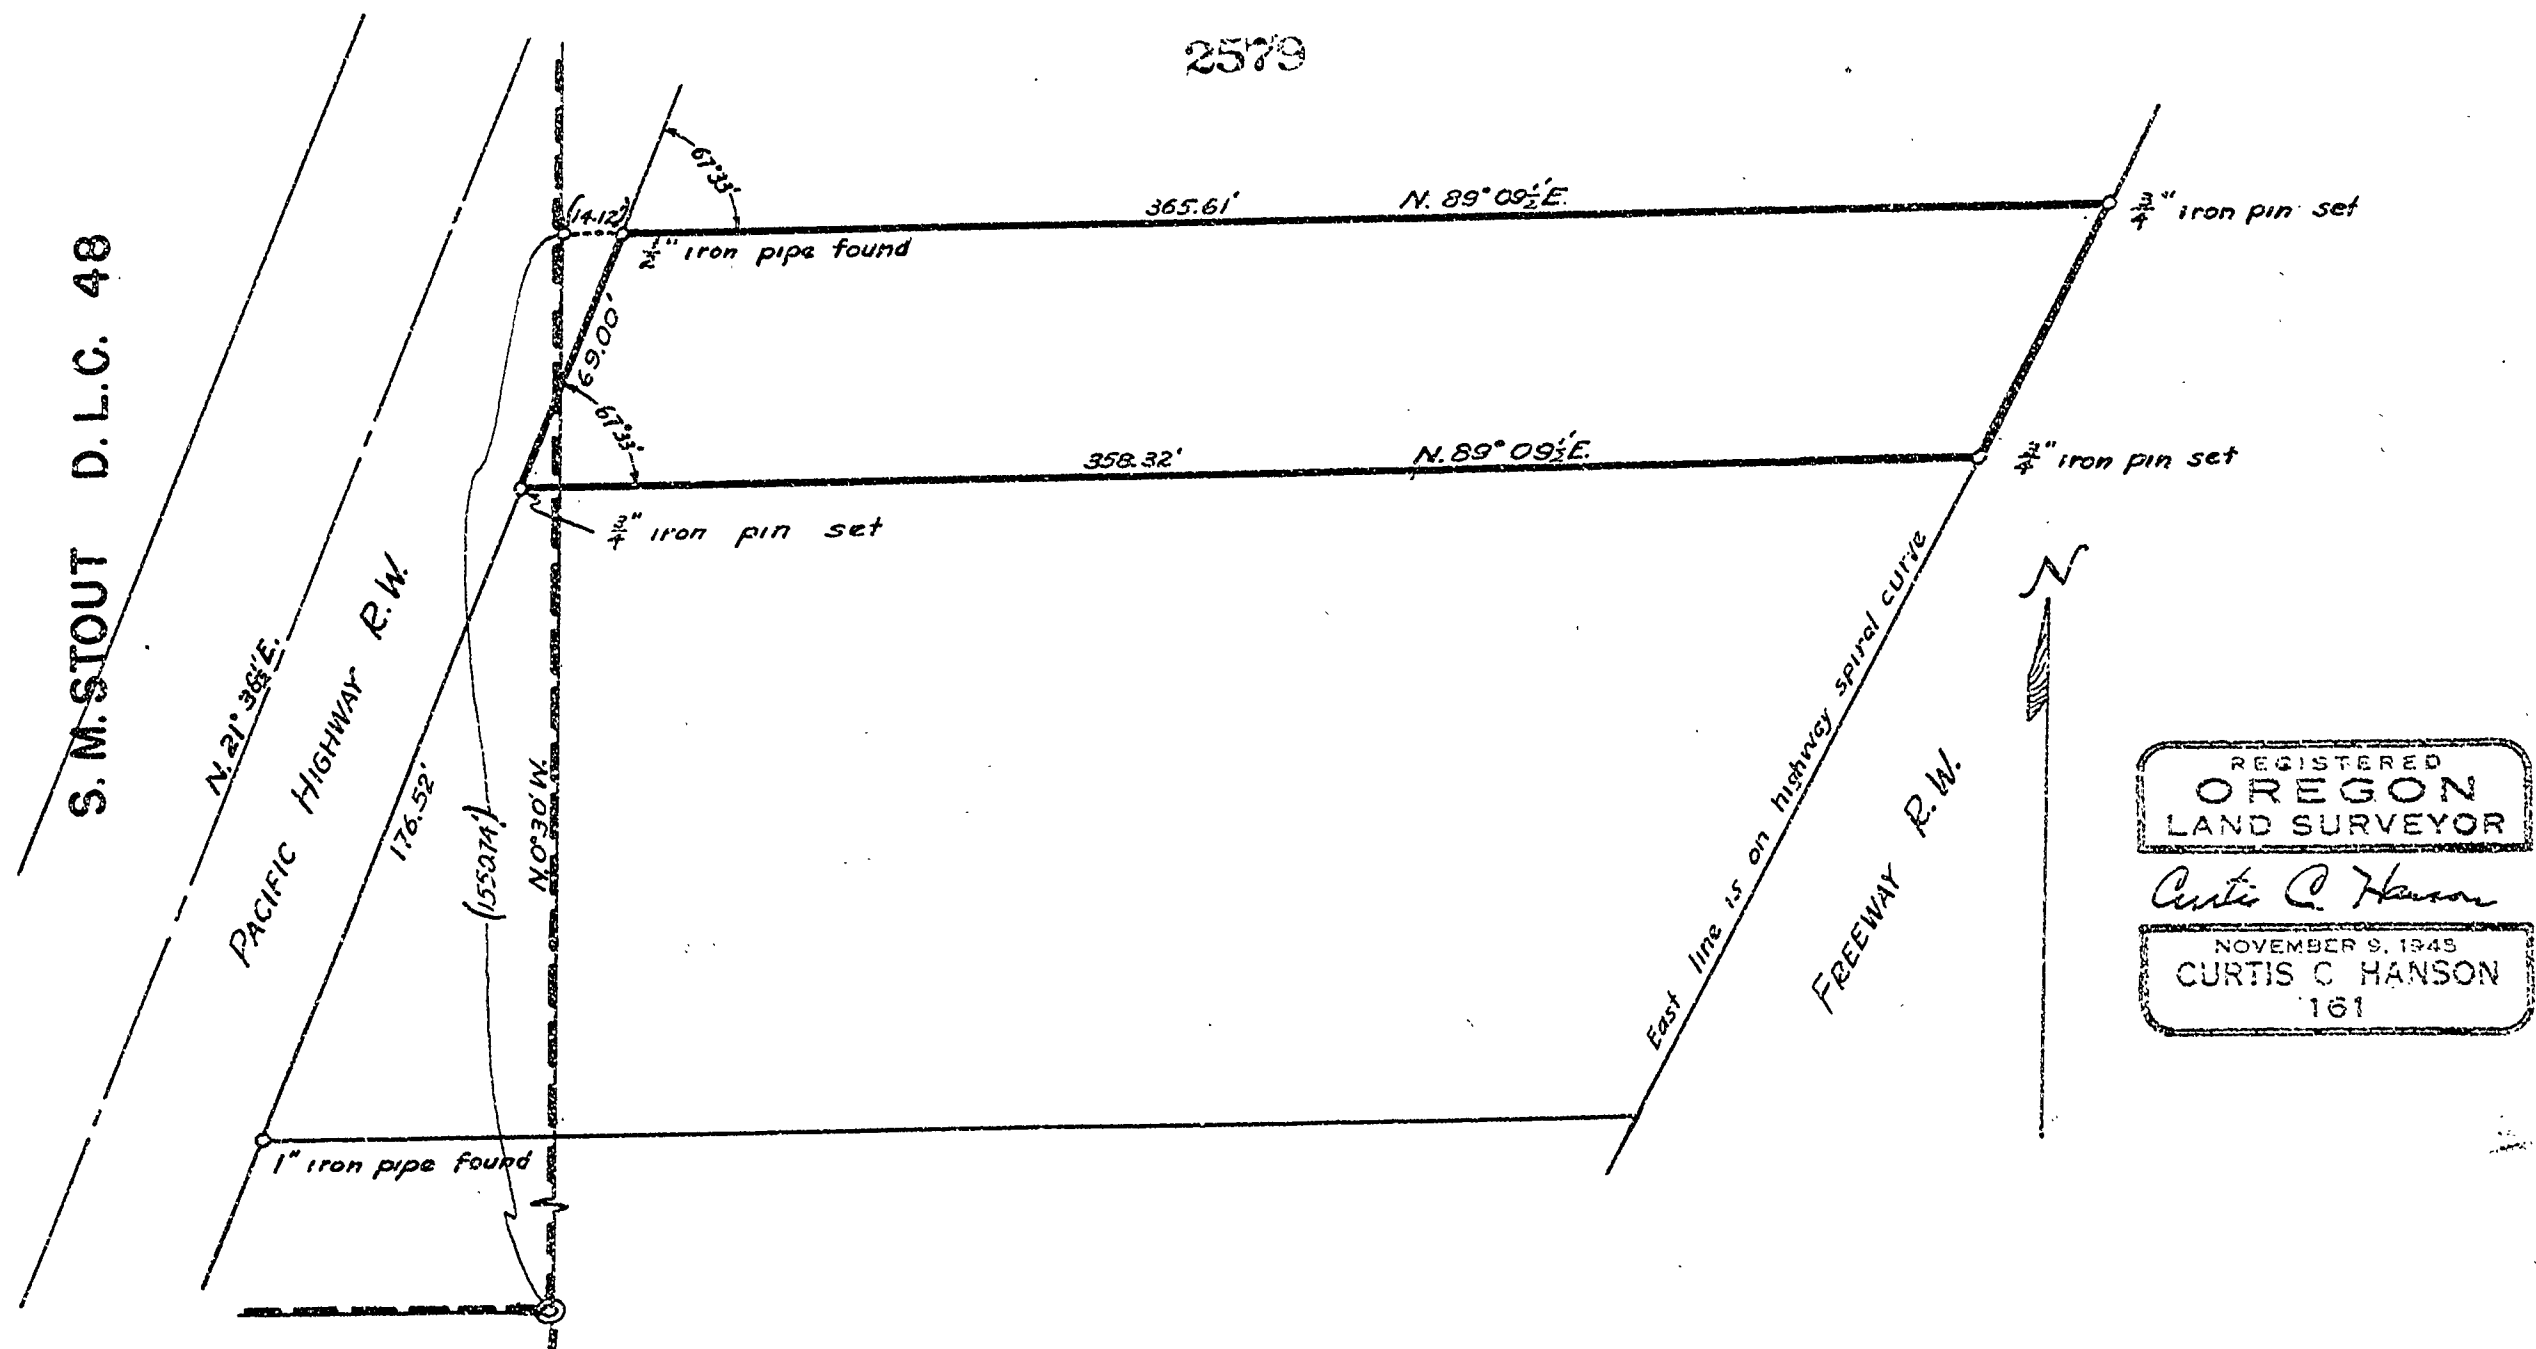

C.S. #

2579

6-2-54
Don Guinn
Skyles

For C.E. Whitman

