


Point South 327.3' & West 160.4'
 from S.W. corner J.C. Avery
 D.L.C. No. 41, T12S, R5W, W.M.

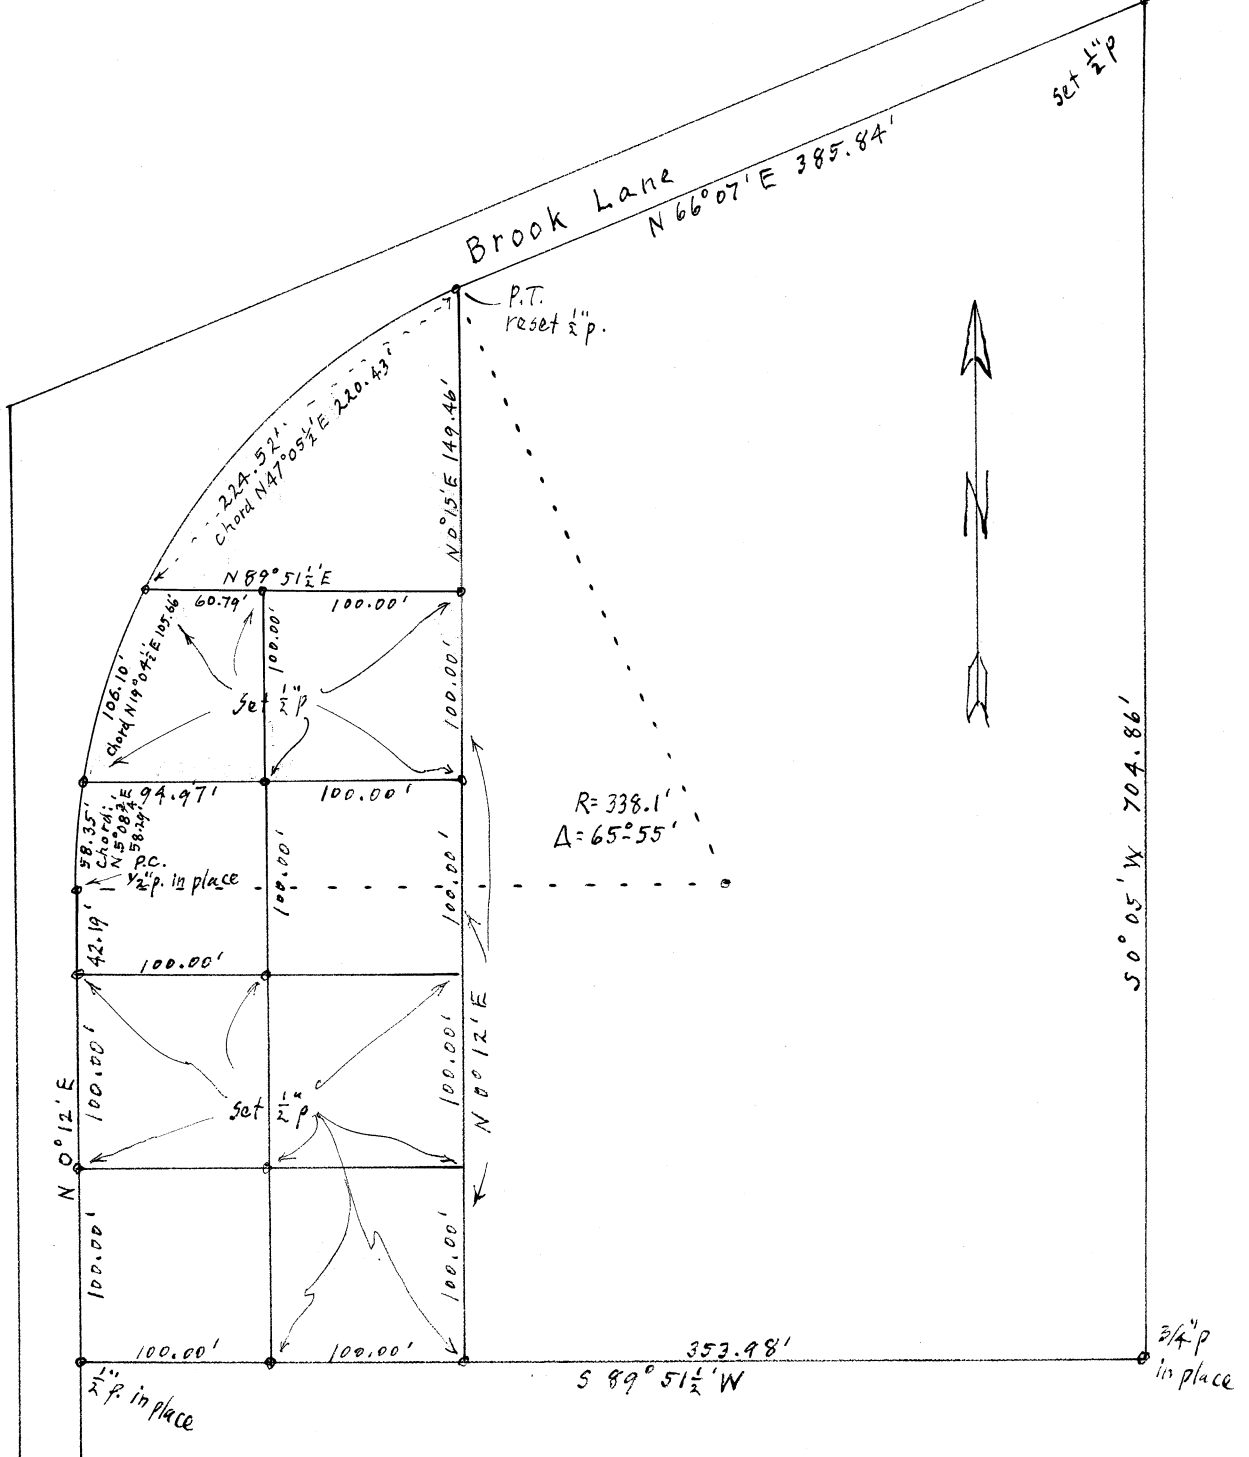

SURVEY

IN

Sec. 3 & 10, T12S, R5W, W.M.

FOR

Chuck Stradley

1" = 100'

O.H.M.

11/27/54

2635

