

MRS. LEONA FRANK



D.L.C. NO. 57 T. 11 S., R. 5 W., W. M.

SCALE 1" = 5 CHS. DEC. 23, 1954

REGISTERED
OREGON
LAND SURVEYOR

Curtis C. Hanson

NOVEMBER 9, 1945
CURTIS C. HANSON
161

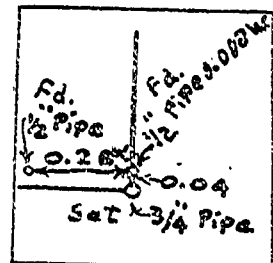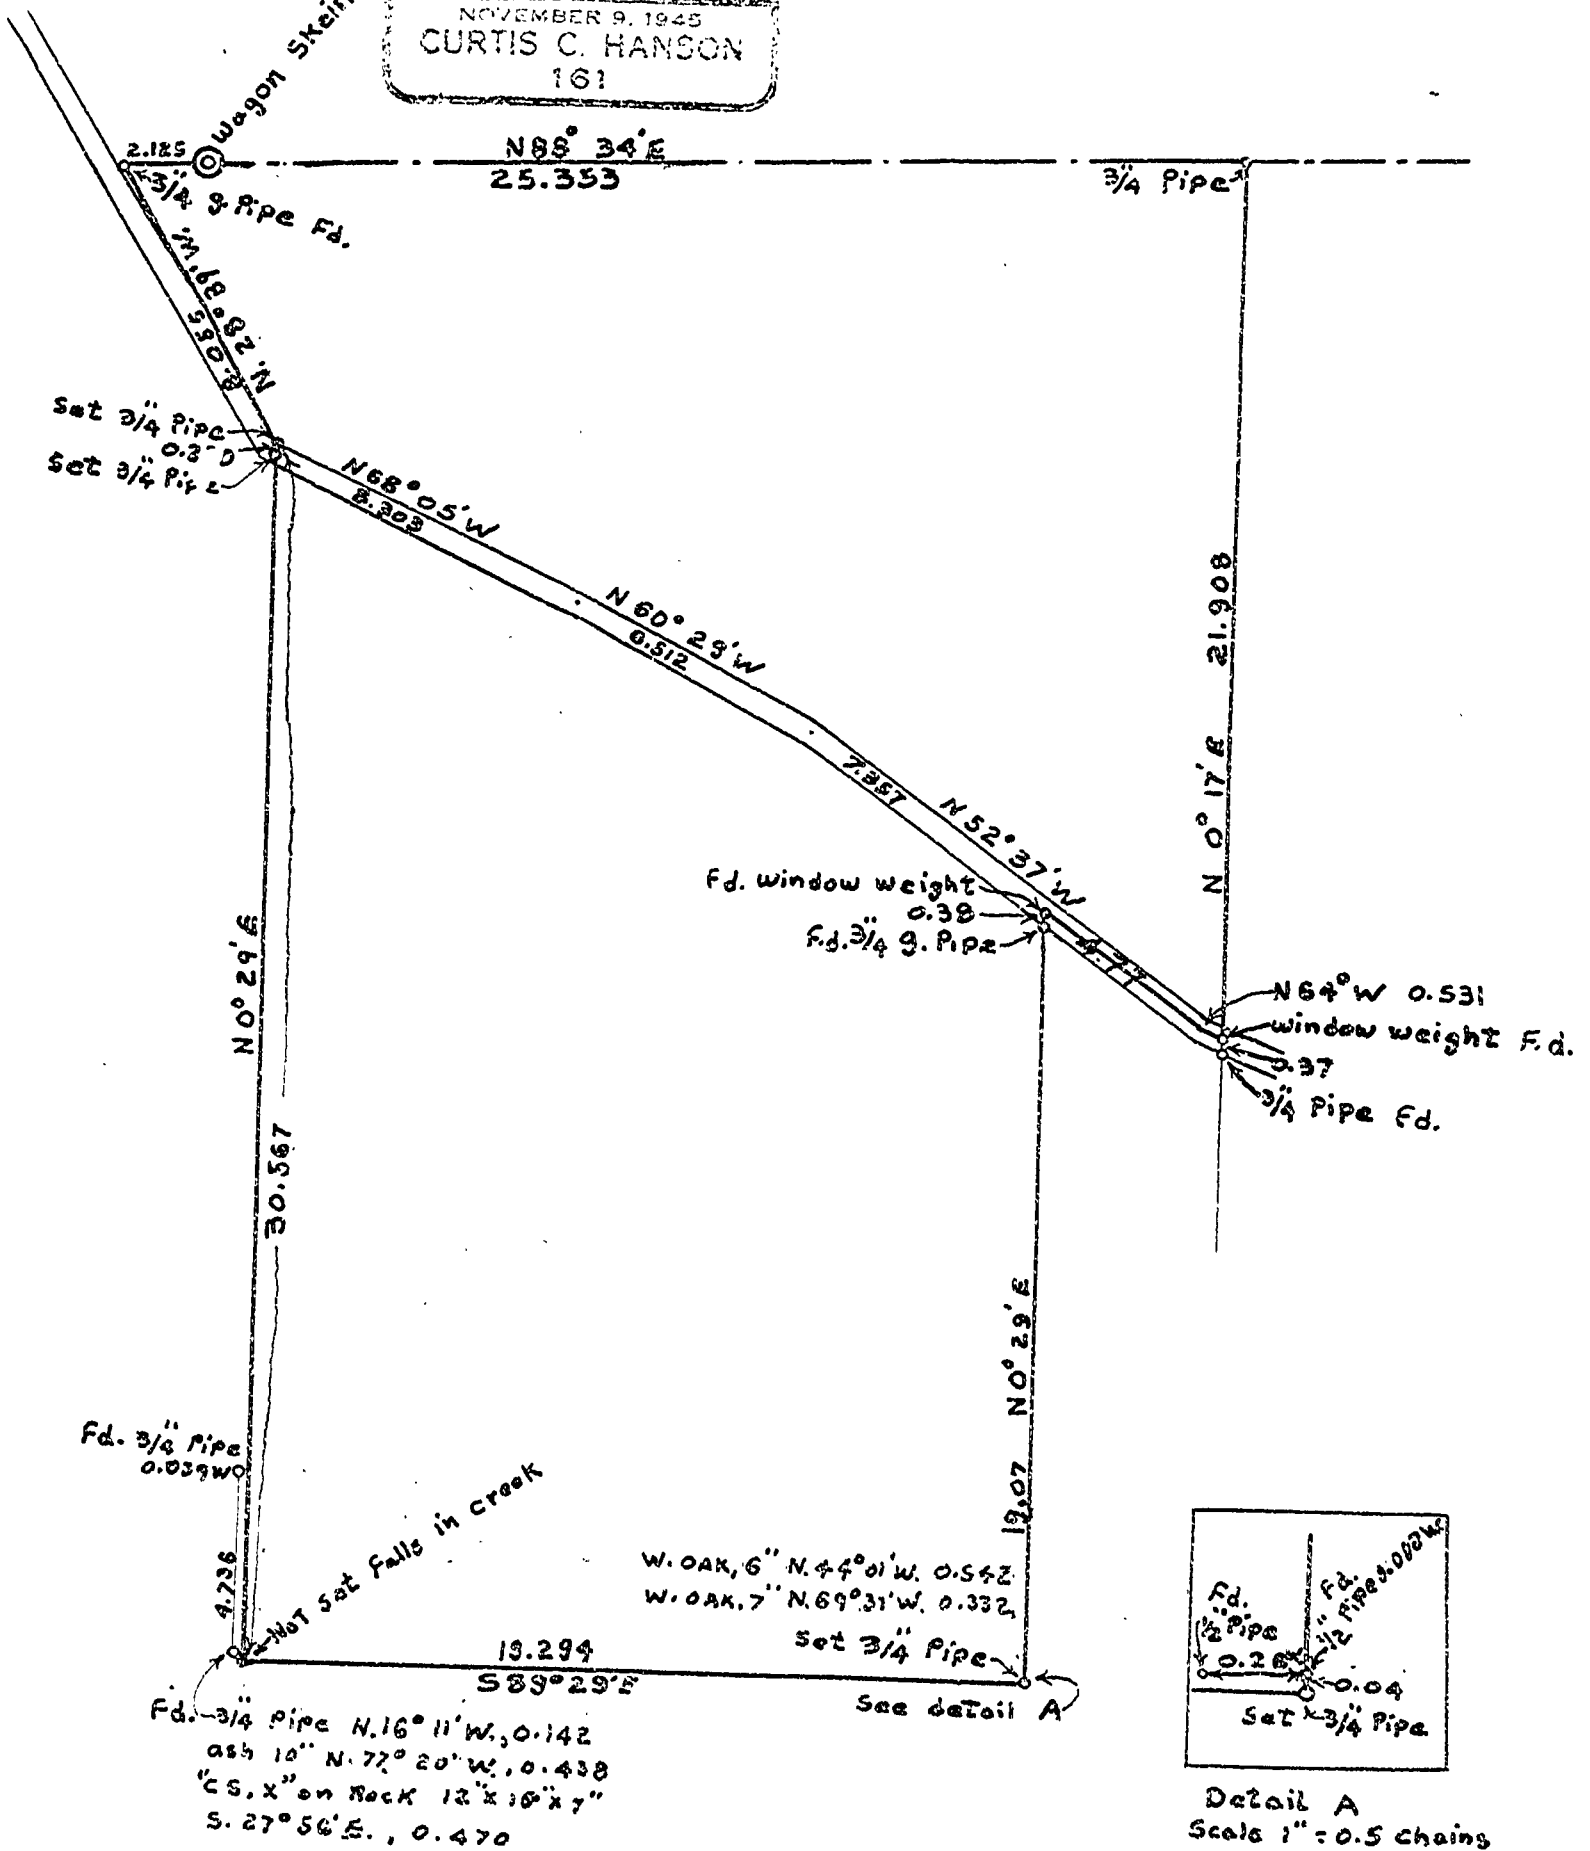

Detail A
Scale 1" = 0.5 chains

MRS. LEONA FRANK

D.L.C. NO. 57 T. 11 S., R. 5 W., W. M.

SCALE 1" = 5 CHS. DEC. 23, 1954

REGISTERED
OREGON
LAND SURVEYOR

Curtis C. Hanson

NOVEMBER 9, 1945
CURTIS C. HANSON
161

