


2043

PLAN OF THE WEST 32 FEET OF LOT 58 AND THE EAST 32 FEET OF LOT 59

GLOVERLAND VILLAGE, CORVALLIS, OREGON

SCALE: 1" = 10'

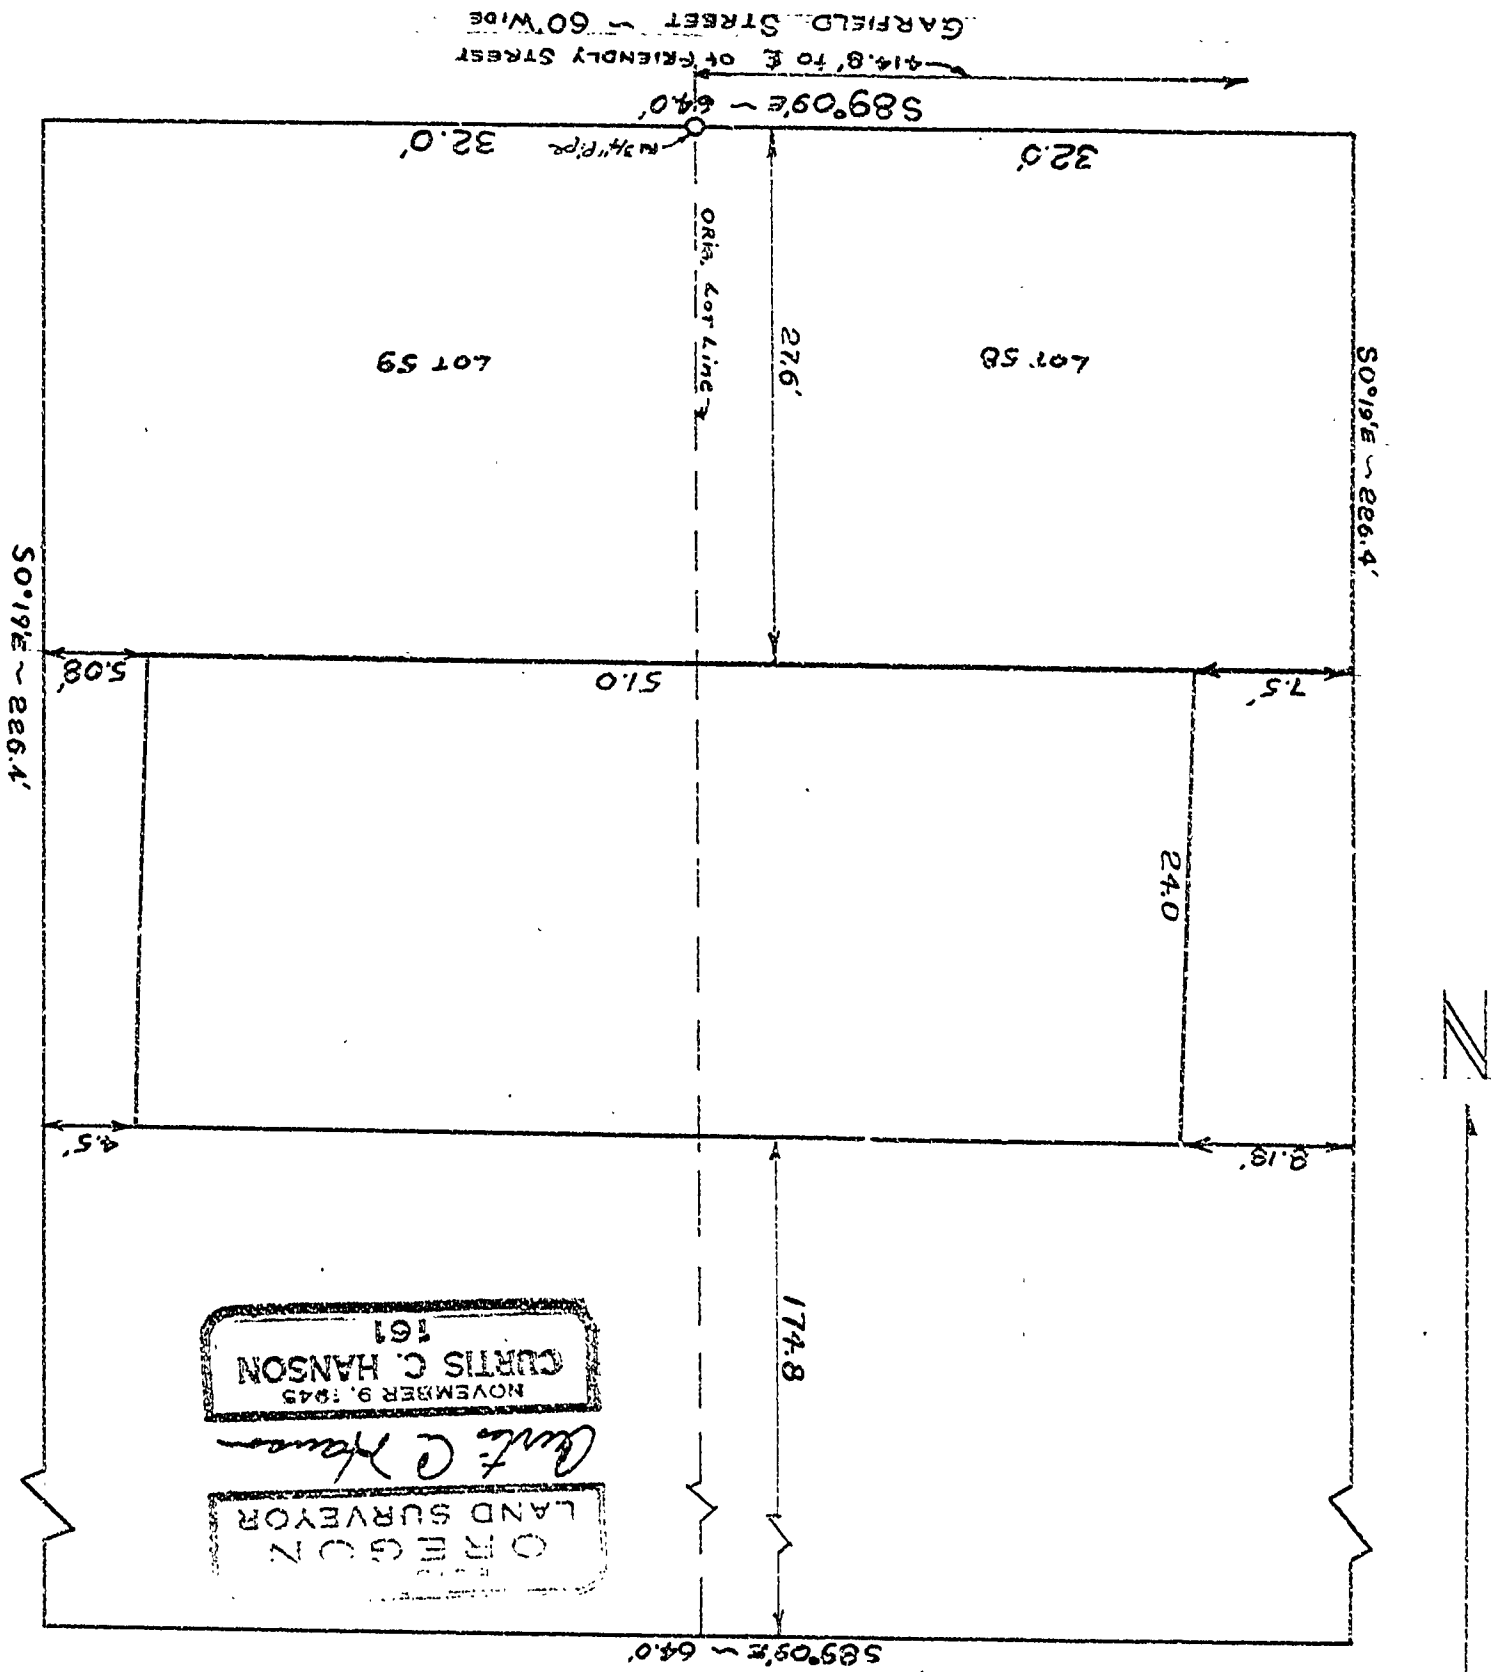


I hereby certify that I surveyed the herein described property and that I find the improvements set thereon to be on the premises in question, and that they do not overlap or encroach on the property lying adjacent thereto except as shown. I further certify that the walls and projections of buildings on adjacent property do not encroach upon the property described herein except as shown. The attached map shows a true and correct relation of the buildings to the property lines and street. The street number is as follows: 2500 Garfield Street. I have checked the building restrictions applicable to this property and find there is a violation of the side setback line.

1-18-55

PLAT OF THE WEST 32 FEET OF LOT 58 AND THE EAST 32 FEET OF LOT 59

CLOVERLAND VILLAGE, CORVALLIS, OREGON

SCALE: 1" = 10'

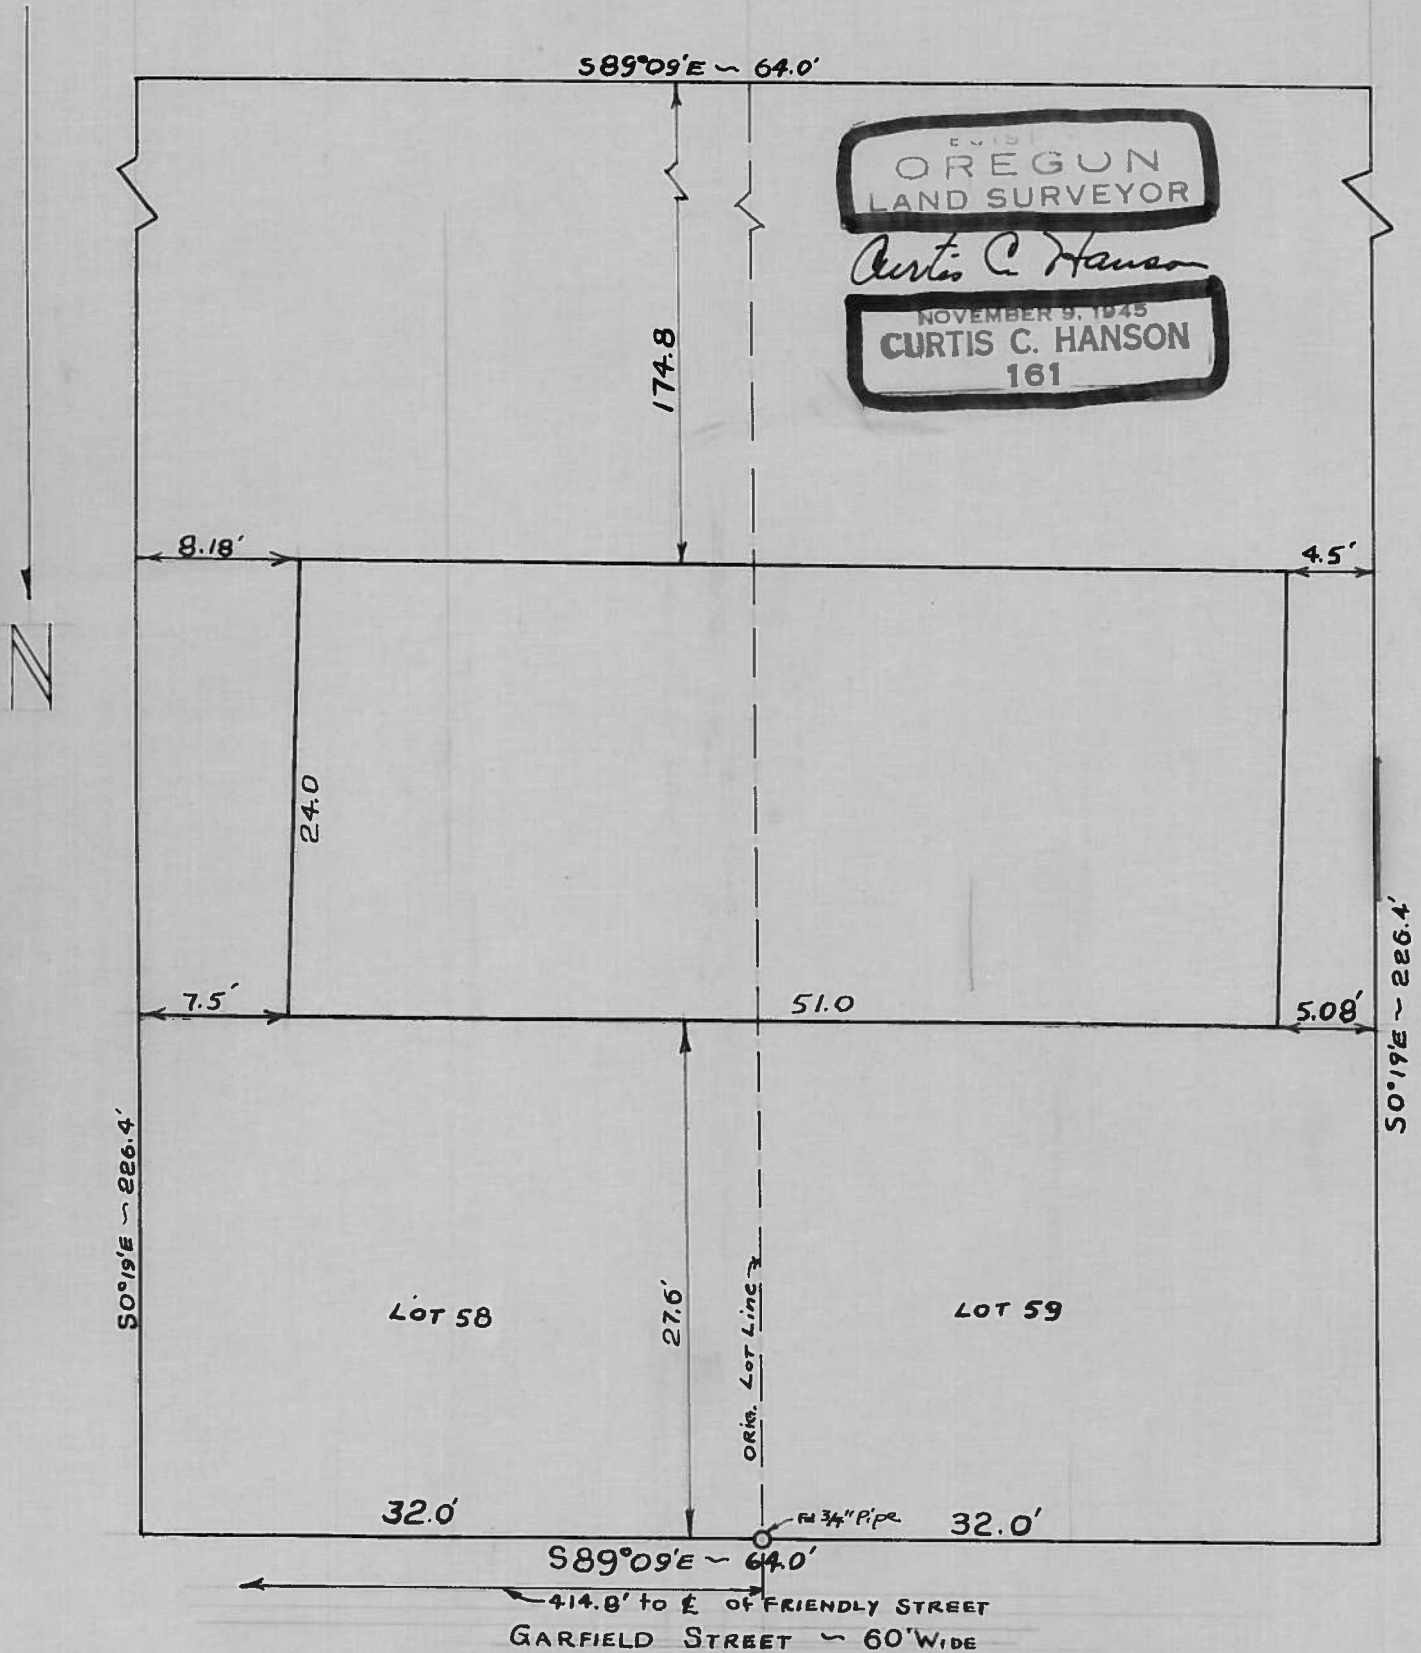

I hereby certify that I surveyed the herein described property and that I find the improvements set thereon to be on the premises in question, and that they do not overlap or encroach on the property lying adjacent thereto except as shown. I further certify that the walls and projections of buildings on adjacent property do not encroach upon the property described herein except as shown. The attached map shows a true and correct relation of the buildings to the property lines and street. The street number is as follows: 2500 Garfield Street. I have checked the building restrictions applicable to this property and find there is a violation of the side setback line.


1-18-55

2.7/16

7 1/8

2649

W 288.6 from Sugar Friendly

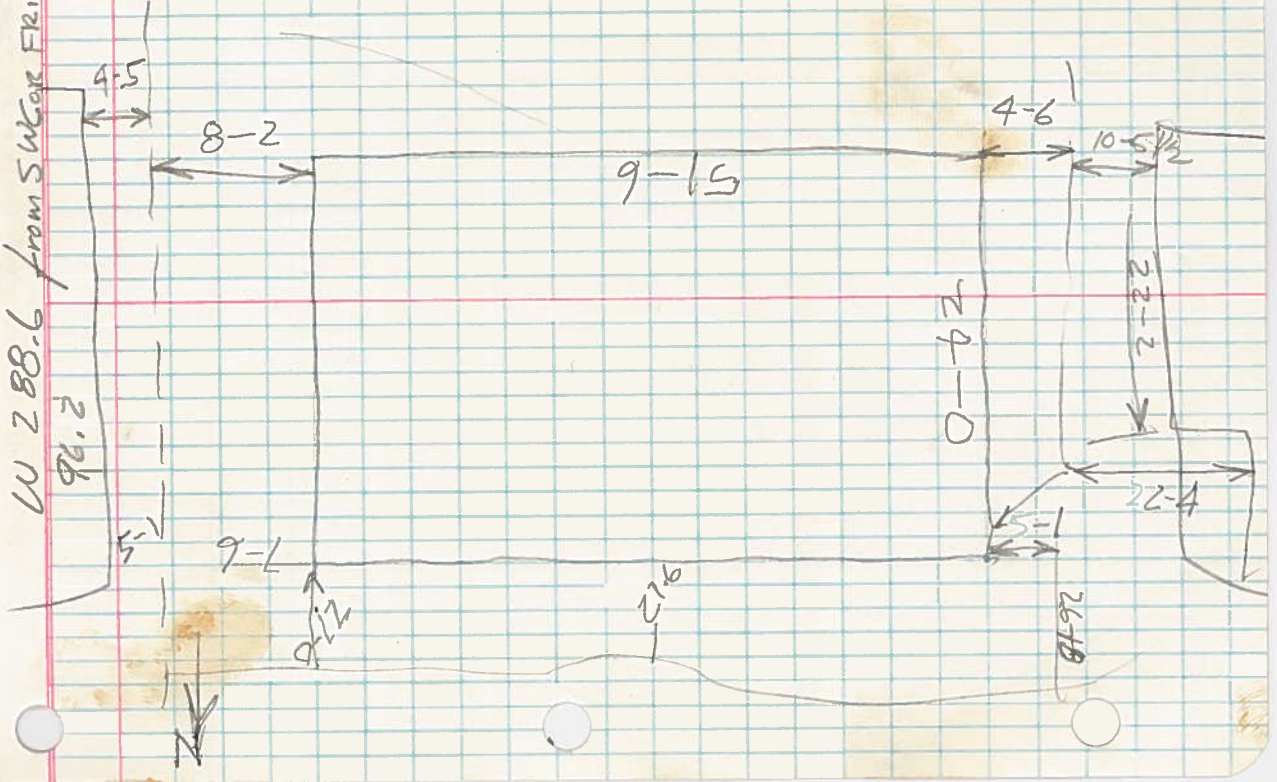

2.7/16

276

2678