

2053


PLAT OF LOTS 54, 55 AND 56

CORVALLIS, OREGON

SCALE: 1" = 30'


I hereby certify that I surveyed the herein described property and that I find the improvements set thereon to be on the premises in question, and that they do not overlap or encroach on the property lying adjacent thereto except as shown. I further certify that the walls and projections of buildings on adjacent property do not encroach upon the property described herein except as shown. The attached map shows a true and correct relation of the buildings to the property lines and street. The street number is as follows: 2308 Garfield Street. I have checked the building restrictions applicable to this property and find the front setback line is in violation of the deed restrictions.

### GARFIELD STREET

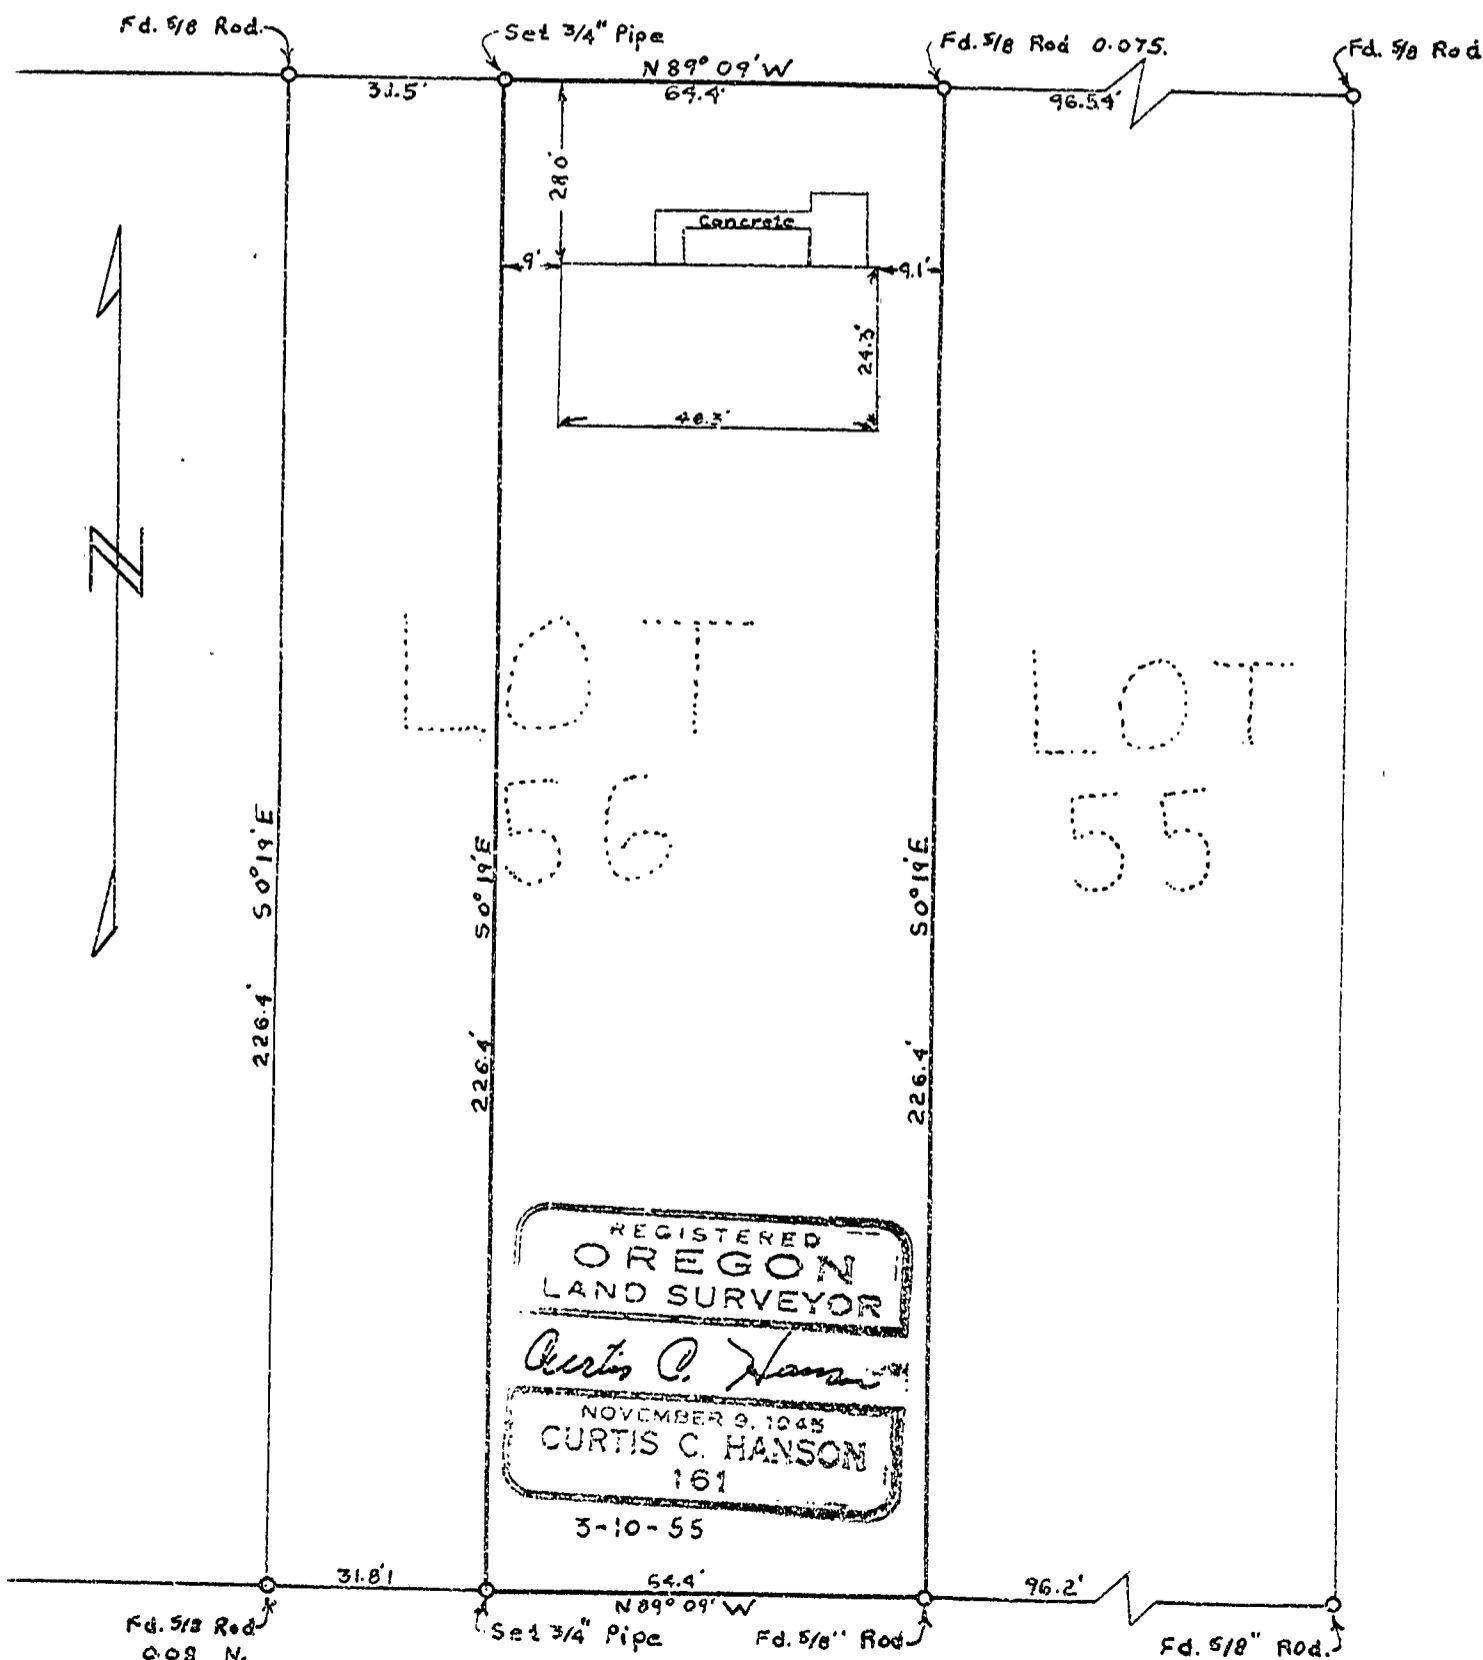

23rd STREET

Lot 56 Cloverland Village  
 # 55

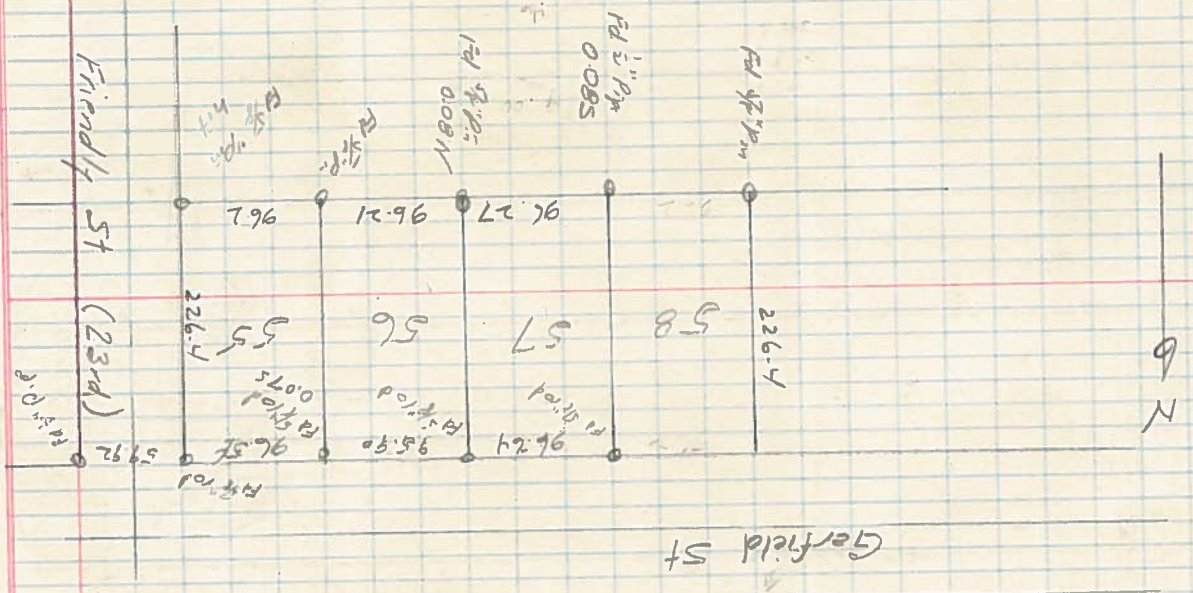

2658


LINE DATE 3-9-55

PARTY Hansen

Wallace

PROJECT Lot - 56 - Cloverland Village

KILHAM FORM P-172 - 196251

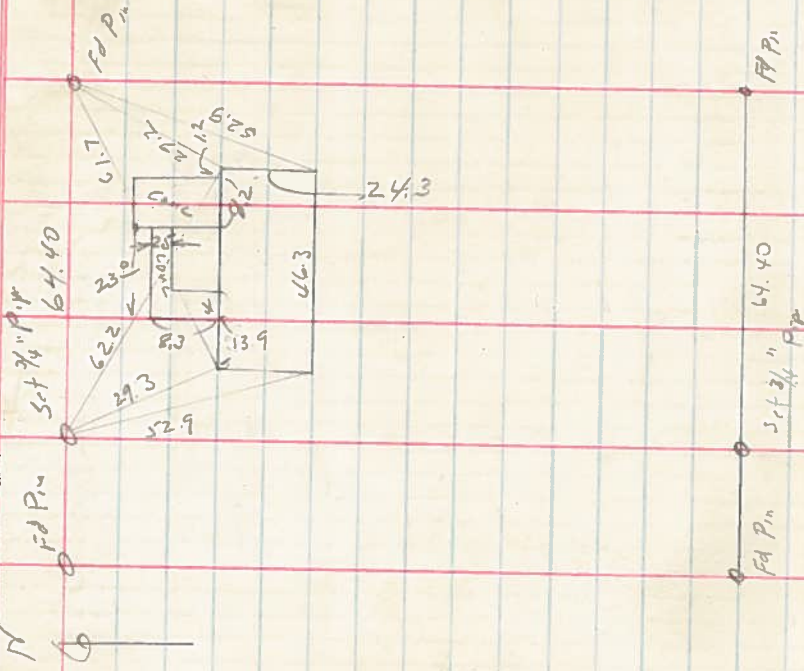


PLAT OF EAST 64.4 FEET OF LOT 56  
CLOVERLAND VILLAGE, CORVALLIS, OREGON

SCALE: 1" = 30'

I hereby certify that I surveyed the herein described property and that I find the improvements set thereon to be on the premises in question, and that they do not overlap or encroach on the property lying adjacent thereto except as shown. I further certify that the walls and projections of buildings on adjacent property do not encroach upon the property described herein except as shown. The attached map shows a true and correct relation of the buildings to the property lines and street. The street number is as follows: 2308 Garfield Street. I have checked the building restrictions applicable to this property and find the front setback line is in violation of the deed restrictions.

GARFIELD STREET

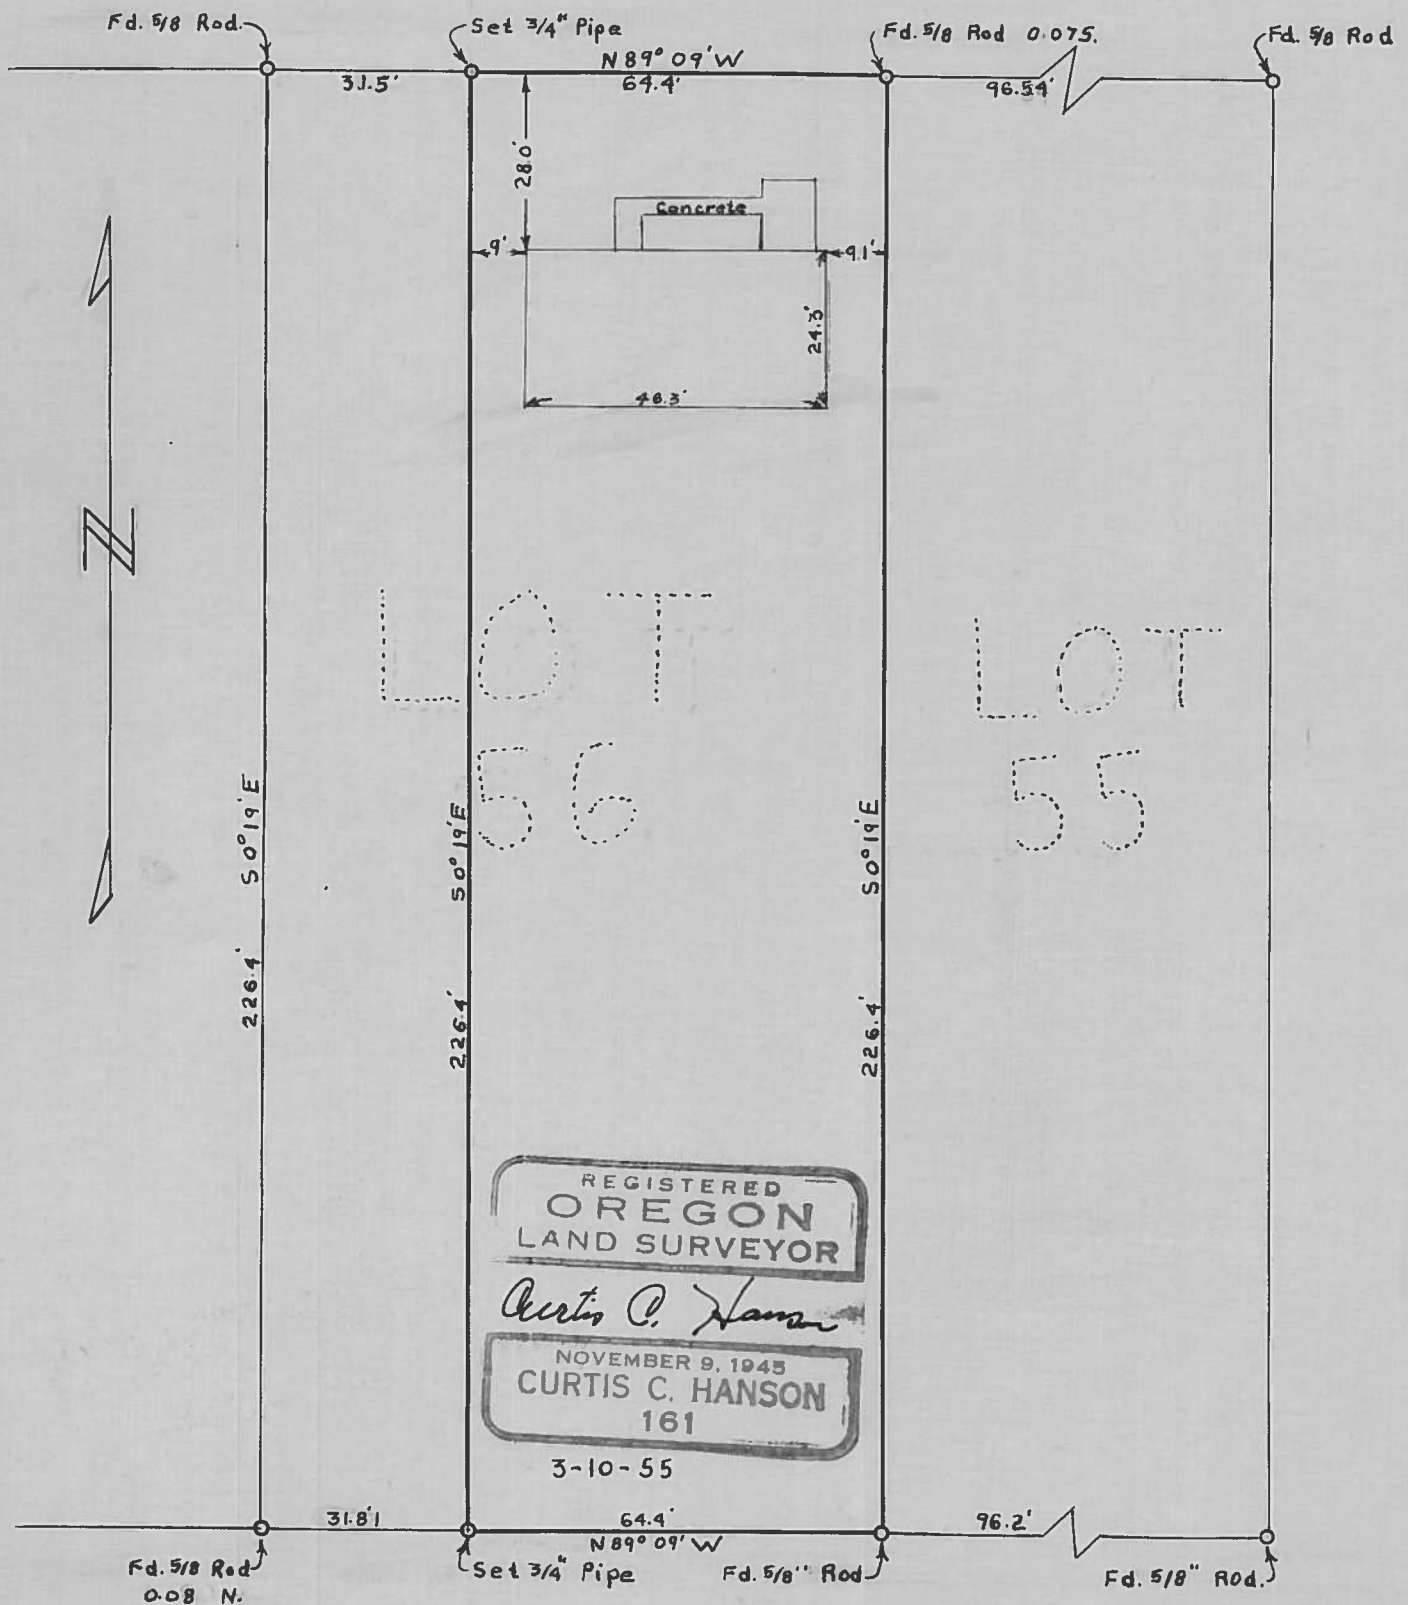

23rd STREET