

2683

GERALD HARRIS

Sec. 32, T. 11 S., R. 6 W., Will. Mer.


Scale: 1" = 400 ch.

MAY 27 1953

REGISTERED
OREGON
LAND SURVEYOR

Martin L. Beyerslein

NOV. 5, 1948
MARTIN L. BEYERLEIN
247

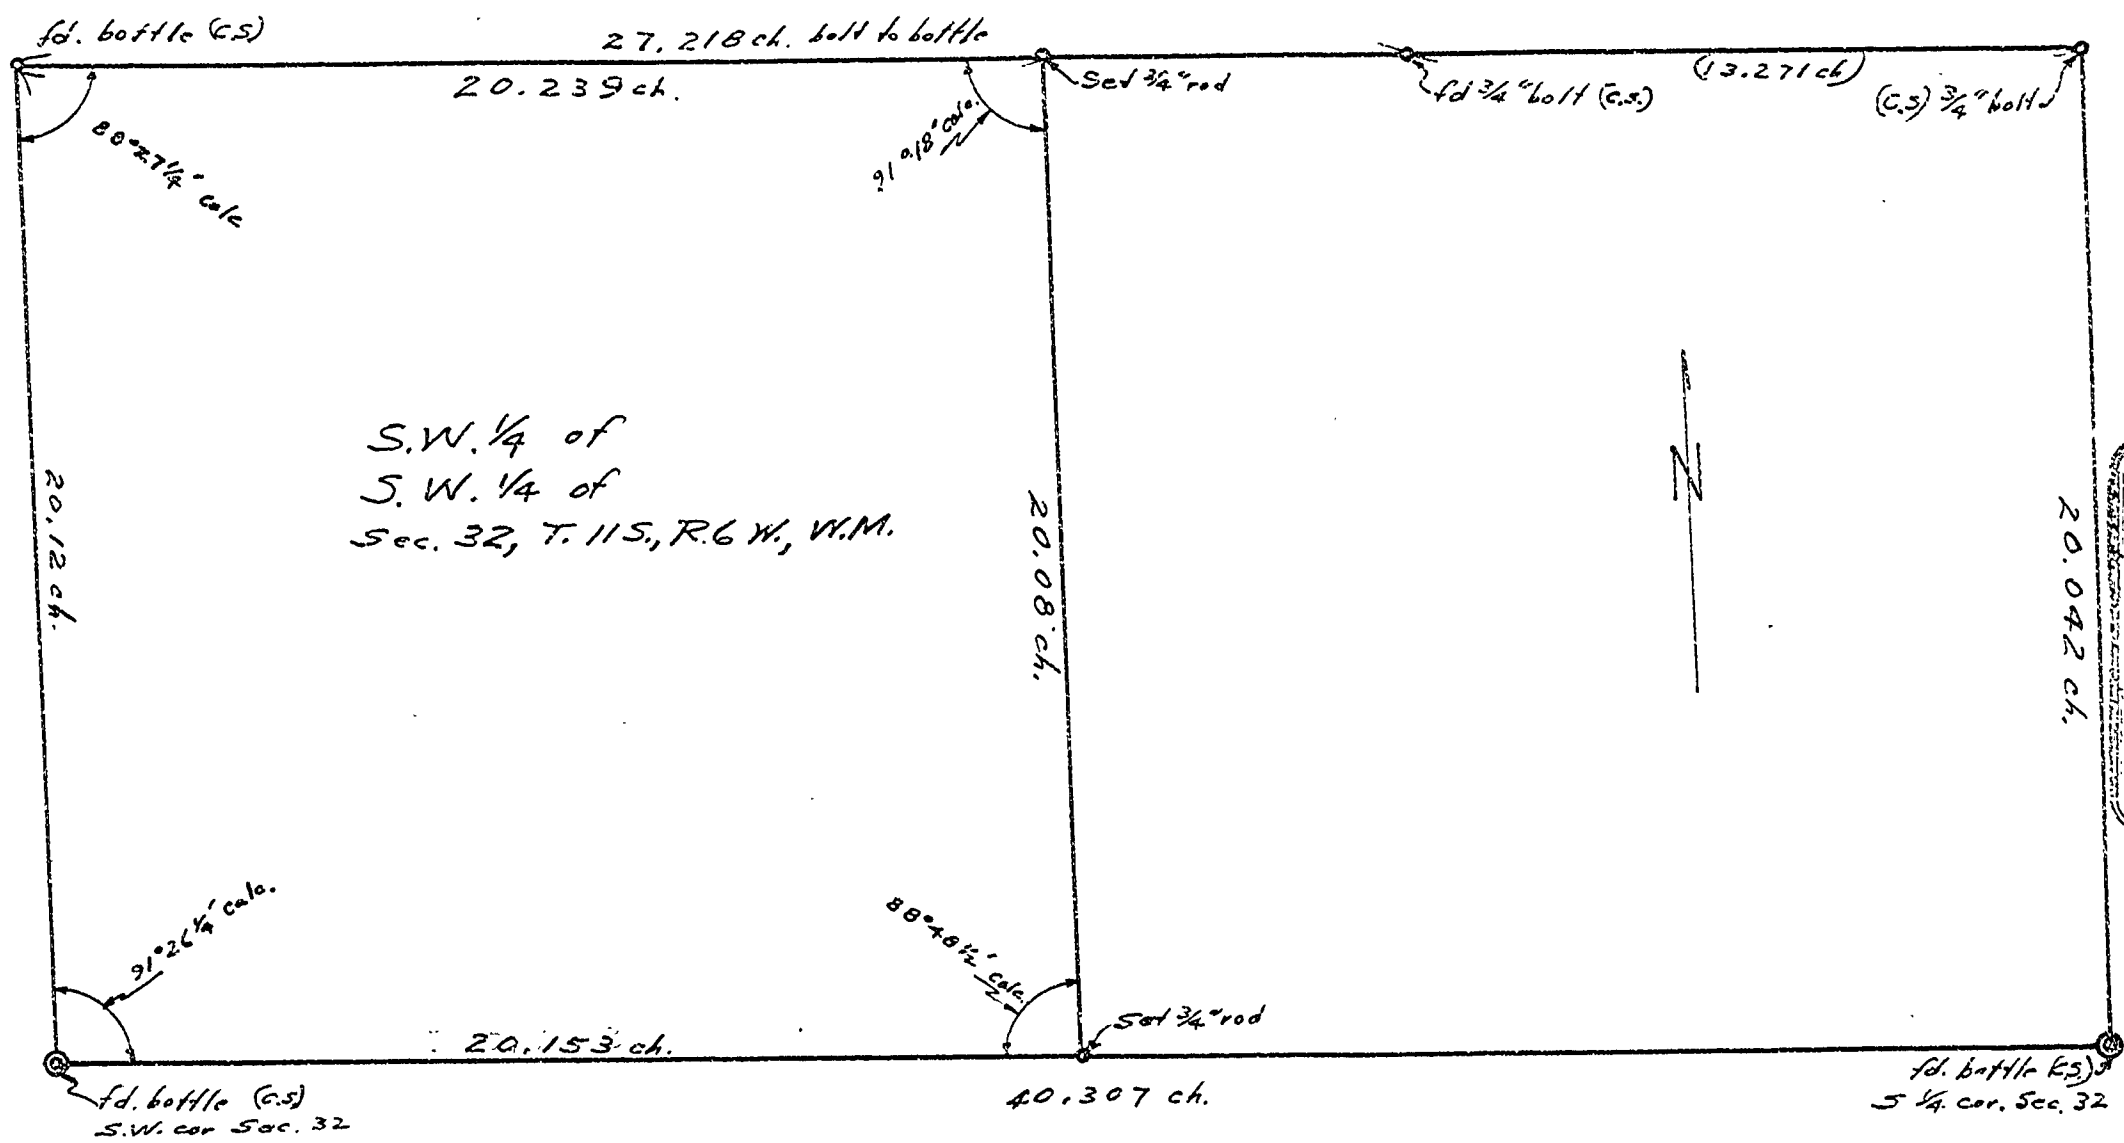

2683

GERALD HABRIS

Sec. 32, T. 11 S., R. 6 W., Will. Mer.

Scale: 1" = 4.00 ch.

May 27, 1955

REGISTERED
OREGON
LAND SURVEYOR

Martin L. Beyerlein

NOV. 5, 1948
MARTIN L. BEYERLEIN
247

