


Nov. 17, 1955



SURVEY FOR Z.E. MERRILL
IN
Sec. 31, T 10 S, R 3 W, W. M.

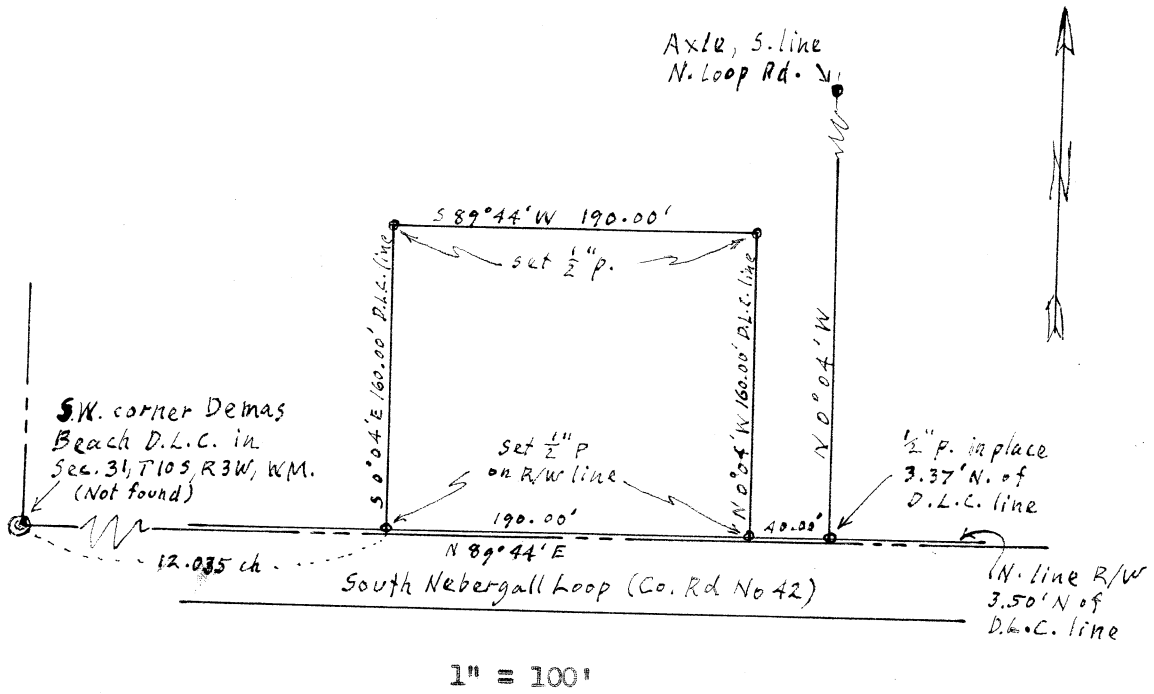