


C.S. 2841  
 Clarence White Agency  
 Lot 10 Bk. 4 Cathercool Addition Corvallis Oregon

Scale 1" = 20'  
 Nov. 16 - 1956

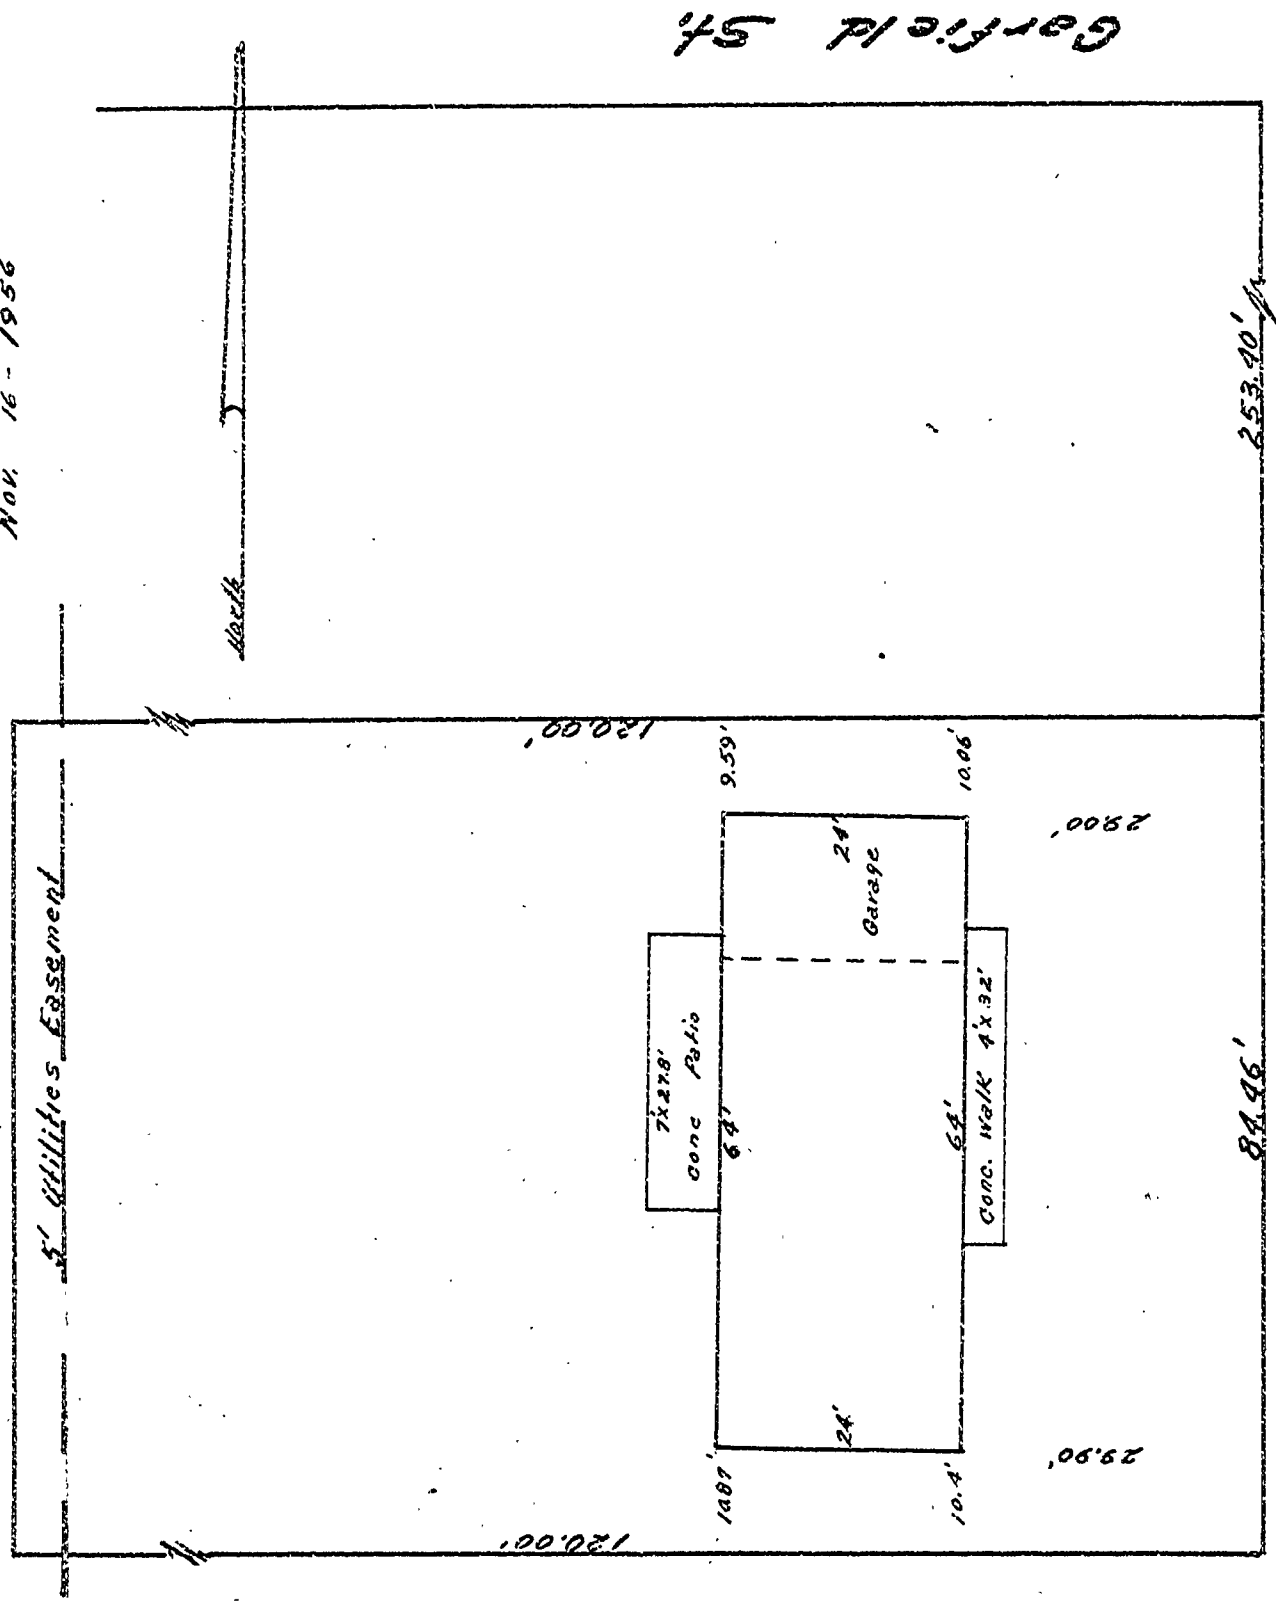

Dixie St.

I hereby certify that I have surveyed the herein described property and that I find the improvements set thereon to be on the premises in question and that they do not overlap or encroach on the property lying adjacent thereto.

I further certify that the walls and projections of buildings on adjacent property do not encroach upon the property described herein.

The attached map shows a true and correct relation of the building to the property lines and streets. The street number of the property surveyed is as follows: 1532 Dixie

I have checked the building restrictions applicable to this property and find there is no violation of the set back line.

REGISTERED  
 OREGON  
 LAND SURVEYOR

J. W. Hanna  
 NOV. 6, 1956  
 J. W. HANNA  
 306