


15TH ST.

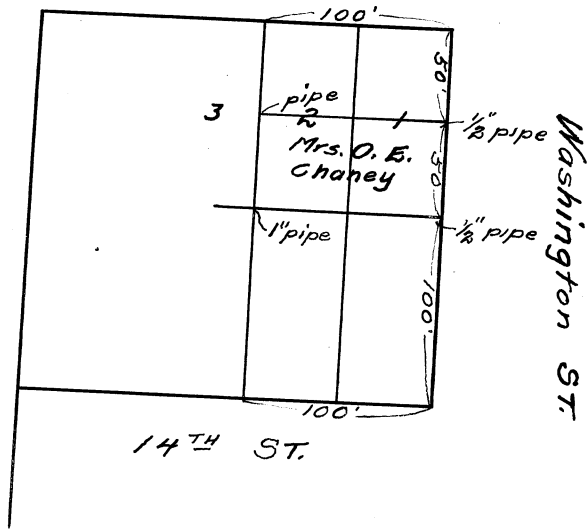

Oct. 30, '19

(12) "A"

2899