

C.S. No. 2952
 SURVEY FOR
 OREGON STATE BOARD OF FORESTRY
 SOUTH HALF OF SECTION LINE 25 & 30
 SECTION LINE 31 AND 36
T 10 S. R 6 AND 7 W. W.M
 BENTON COUNTY, OREGON


TRANSIT AND CHAIN SURVEY BY R.M.B., D.B., G.S., H.B., B.D.,

MARCH, 1957

SCALE 1" = 300'

SOLAR OBSERVATION

MAGNETIC VARIATION	21° 30' E
DATE	APRIL 1, 1957
STANDARD TIME	10:28:12 A.M.
LOCAL TIME	10:14:16 A.M.
SUN DECLINATION	N 4°-39'-15"
REFRACTION CORRECTION	- 55"
LATITUDE	44°-40'-26"
SUN'S ALTITUDE	43°-19'-05"
PLACE OF OBSERVATION	N 59°-48' W 480.7
	F.T. FROM 1/4 COR.
	COMMON TO SEC'S
	25 AND 30

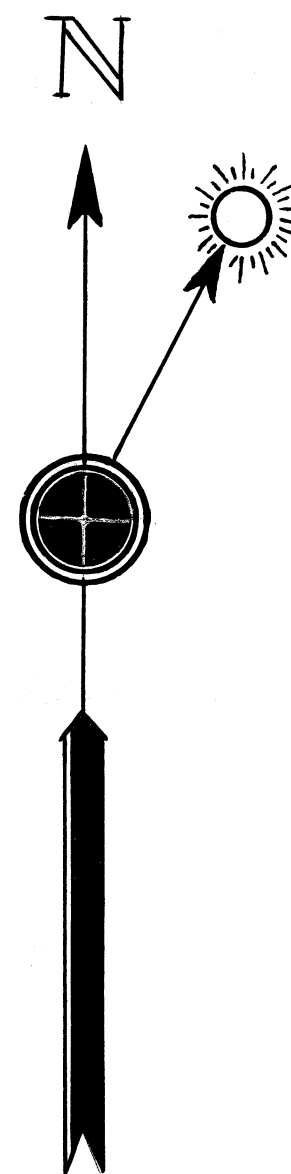

C.S. No. 2952

REESTABLISHED CORNER FOR OREGON STATE BOARD OF FORESTRY

One Quarter corner common to Sections 31 and 36, T. 10S., R. 6 and 7W., W.M.,
Benton County, Oregon

ORIGINAL (No evidence of original corner found)

REESTABLISHED

Set $1\frac{1}{2}$ " x 36" galvanized iron pipe with 3" bronze cap marked "OREGON STATE
BOARD OF FORESTRY 1/4 S31 S36 1957 RE2311," 28 inches in ground, from
which a:


24" fir bears S79°W. 12.7 ft.; scribed 1/4 S36 BT RE2311

26" fir bears N29°E 39.4 ft.; scribed 1/4 S31 BT

Oregon State Board of Forestry metal location poster on 24" fir BT.
Set 4" x 4" x 6' white painted cedar post 2.0 ft. SW of pipe.
Also poster on white painted cedar post 128.6 ft. East, on West
edge of Moser log road

Dated April 3, 1957

Reestablished by *R. M. Baldock* under my direction.
R. M. Baldock, Ass't. Engineer

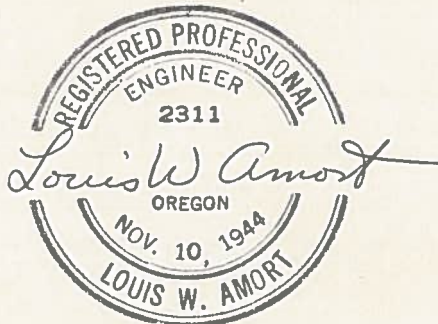

Present and witnessed by D. Bagger
H. Baughn
B. Davis

C. S. No. 2952

RESTORED CORNER FOR OREGON STATE BOARD OF FORESTRY

Section corner common to Sections 25, 30, 31 and 36,
T. 10S, Rges. 6 & 7W, W.M., Benton County, Oregon.

ORIGINAL

Post (now missing, found 12"x8"x12" stone in place) from which a:

- 30" Fir bears N9° E 325 lks.; now 50", burnt face, scribe visible.
- 36" Fir bears S75°W 17 lks.; now 36" snag, no scribe visible.
- 20" Fir bears N54°W 145 lks.; now rotten stump.
- 3" Willow bears S68°E 11 lks.; missing.

RESTORED

Var. 20°E

"Used Above Stone" as corner, from which a:

- 13" Fir bears N56°W 28.0 ft.; scribed T10S R7W S25 BT.
- 10" Fir bears S45°W 25.2 ft.; scribed T10S R7W S36 BT.
- 14" Fir bears S39°E 17.0 ft.; scribed T10S R6W S31 BT RE 2311.
- 13" Fir bears N66°E 80.0 ft.; scribed T10S R6W S30 BT.

4 ft. x 40 ft. well bears S65°W 65.0 ft.; erected temporary fence around it.

Oregon State Board of Forestry metal location poster on 14" Fir bt.

Set 4"x4"x72" white painted Cedar post 1.5 ft. SE of stone.

Dated February 27, 1957.

Restored by



Present and witnessed by R. Baldock
D. Bagger
H. Baughn
B. Davis

C. S. No. 2952

ESTABLISHED CORNER FOR OREGON STATE BOARD OF FORESTRY

South one-sixteenth corner common to Sections 25 and 30, T. 10S., R. 6 and 7W.,
W.M., Benton County, Oregon

ESTABLISHED

Set $1\frac{1}{2}$ " x 36" galvanized iron pipe with 3" bronze cap marked, "OREGON STATE
BOARD OF FORESTRY S 1/16 S25 S30 1957 RE2311," 30 inches in ground, and
from which a:

46" fir bears N $61\frac{1}{2}$ °W 36.4 ft.; scribed S 1/16 S25 BT RE2311

33" fir bears N38°E 53.0 ft.; scribed S 1/16 S30 BT

Oregon State Board of Forestry metal location poster on 46" fir BT.
4" x 4" x 6' white painted cedar post 1.5 ft. NE of pipe.

Dated April 4, 1957

Established by D. C. Bagger under my direction.
D. C. Bagger, Engineer Aide



Present and witnessed by H. Baughn
B. Davis.