


C.S. No. 3016

# NORTHSIDE LUMBER CO.

## SEC. 14, T12S, R6W

SCALE 1" = 400'    NOVEMBER 1957

BERT W. UDELL RPE #2301

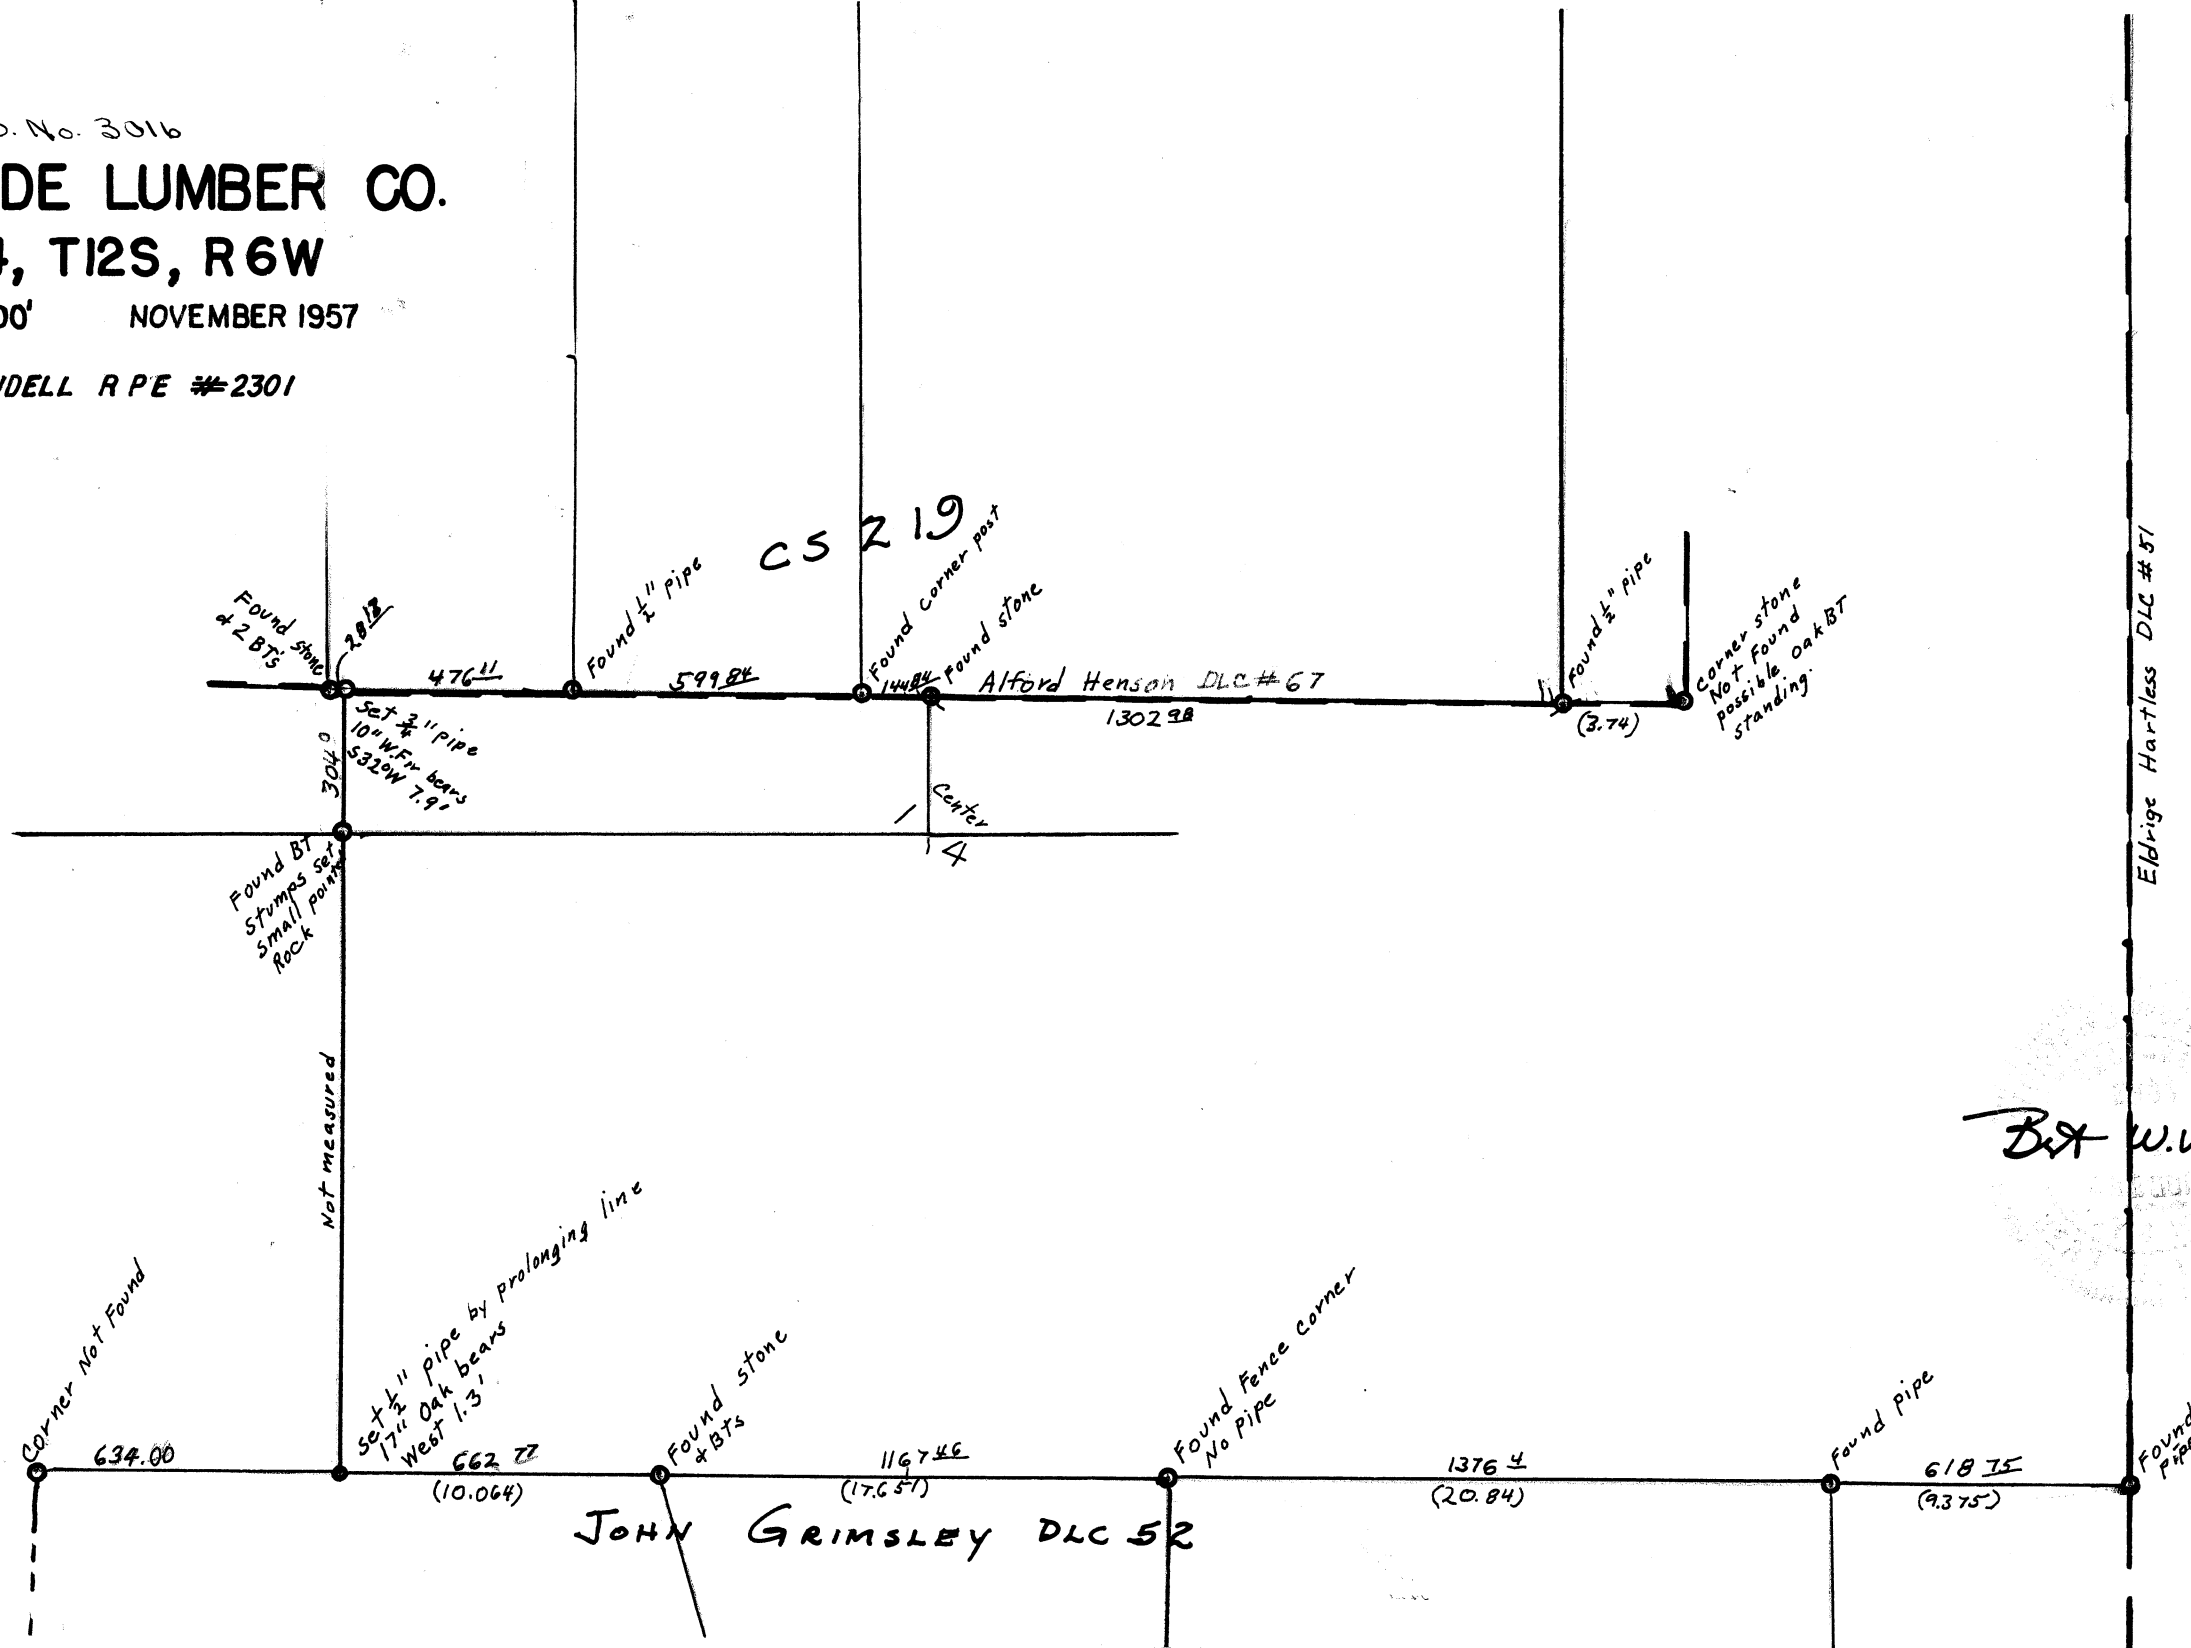

Bert W. Udell

