


NO. 58-8-179
PACIFIC TELEPHONE CO.

CS No. 3078

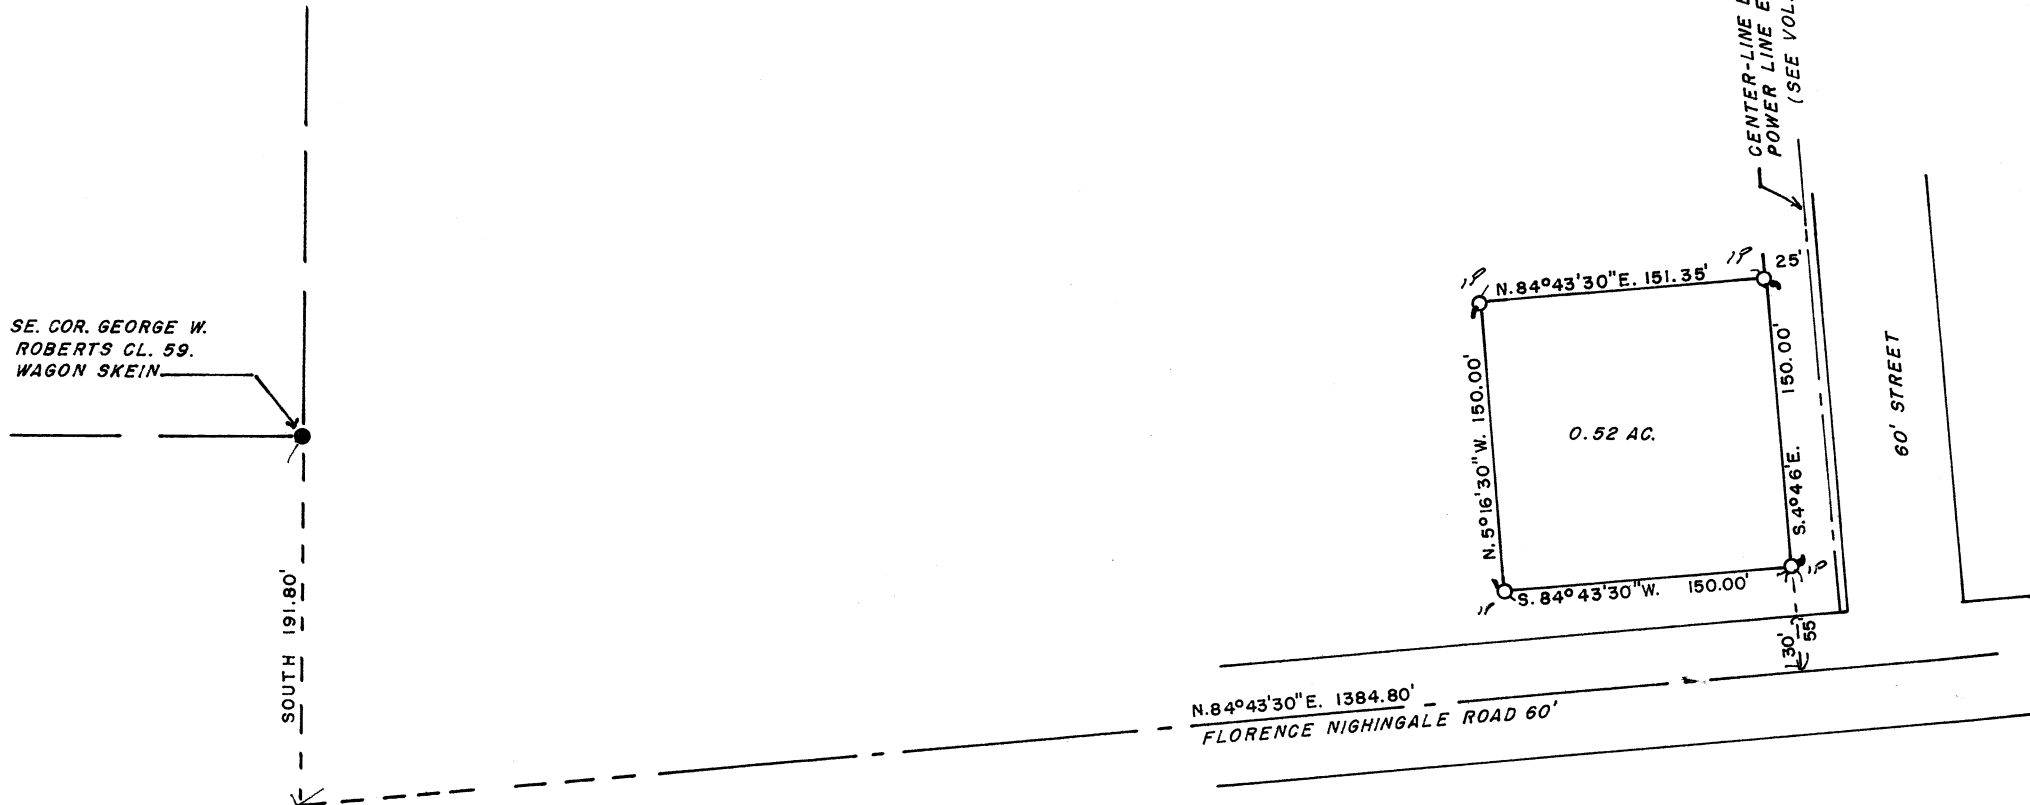

* DENOTES MONUMENTS SET ● DENOTES MONUMENTS FOUND
T10 S R 4 W SEC. 30 (BEARING & DIST. OF RECORD)

BENTON COUNTY
OREGON

RALPH G. BARNES
LAND SURVEYOR
990 Shipping St.
Salem, Oregon.

REGISTERED
OREGON
LAND SURVEYOR

Ralph G. Barnes

MAY 5, 1950
RALPH G. BARNES
263

2017