

COUNTY SURVEY No 3193


D. E. NEBERGALL

SEC. 32, T. 10 S., R. 3 W., W.M.

SCALE: 1" = 50'

DECEMBER 13, 1948

DONALD R. SHORT  
REG. LAND SURVEYOR

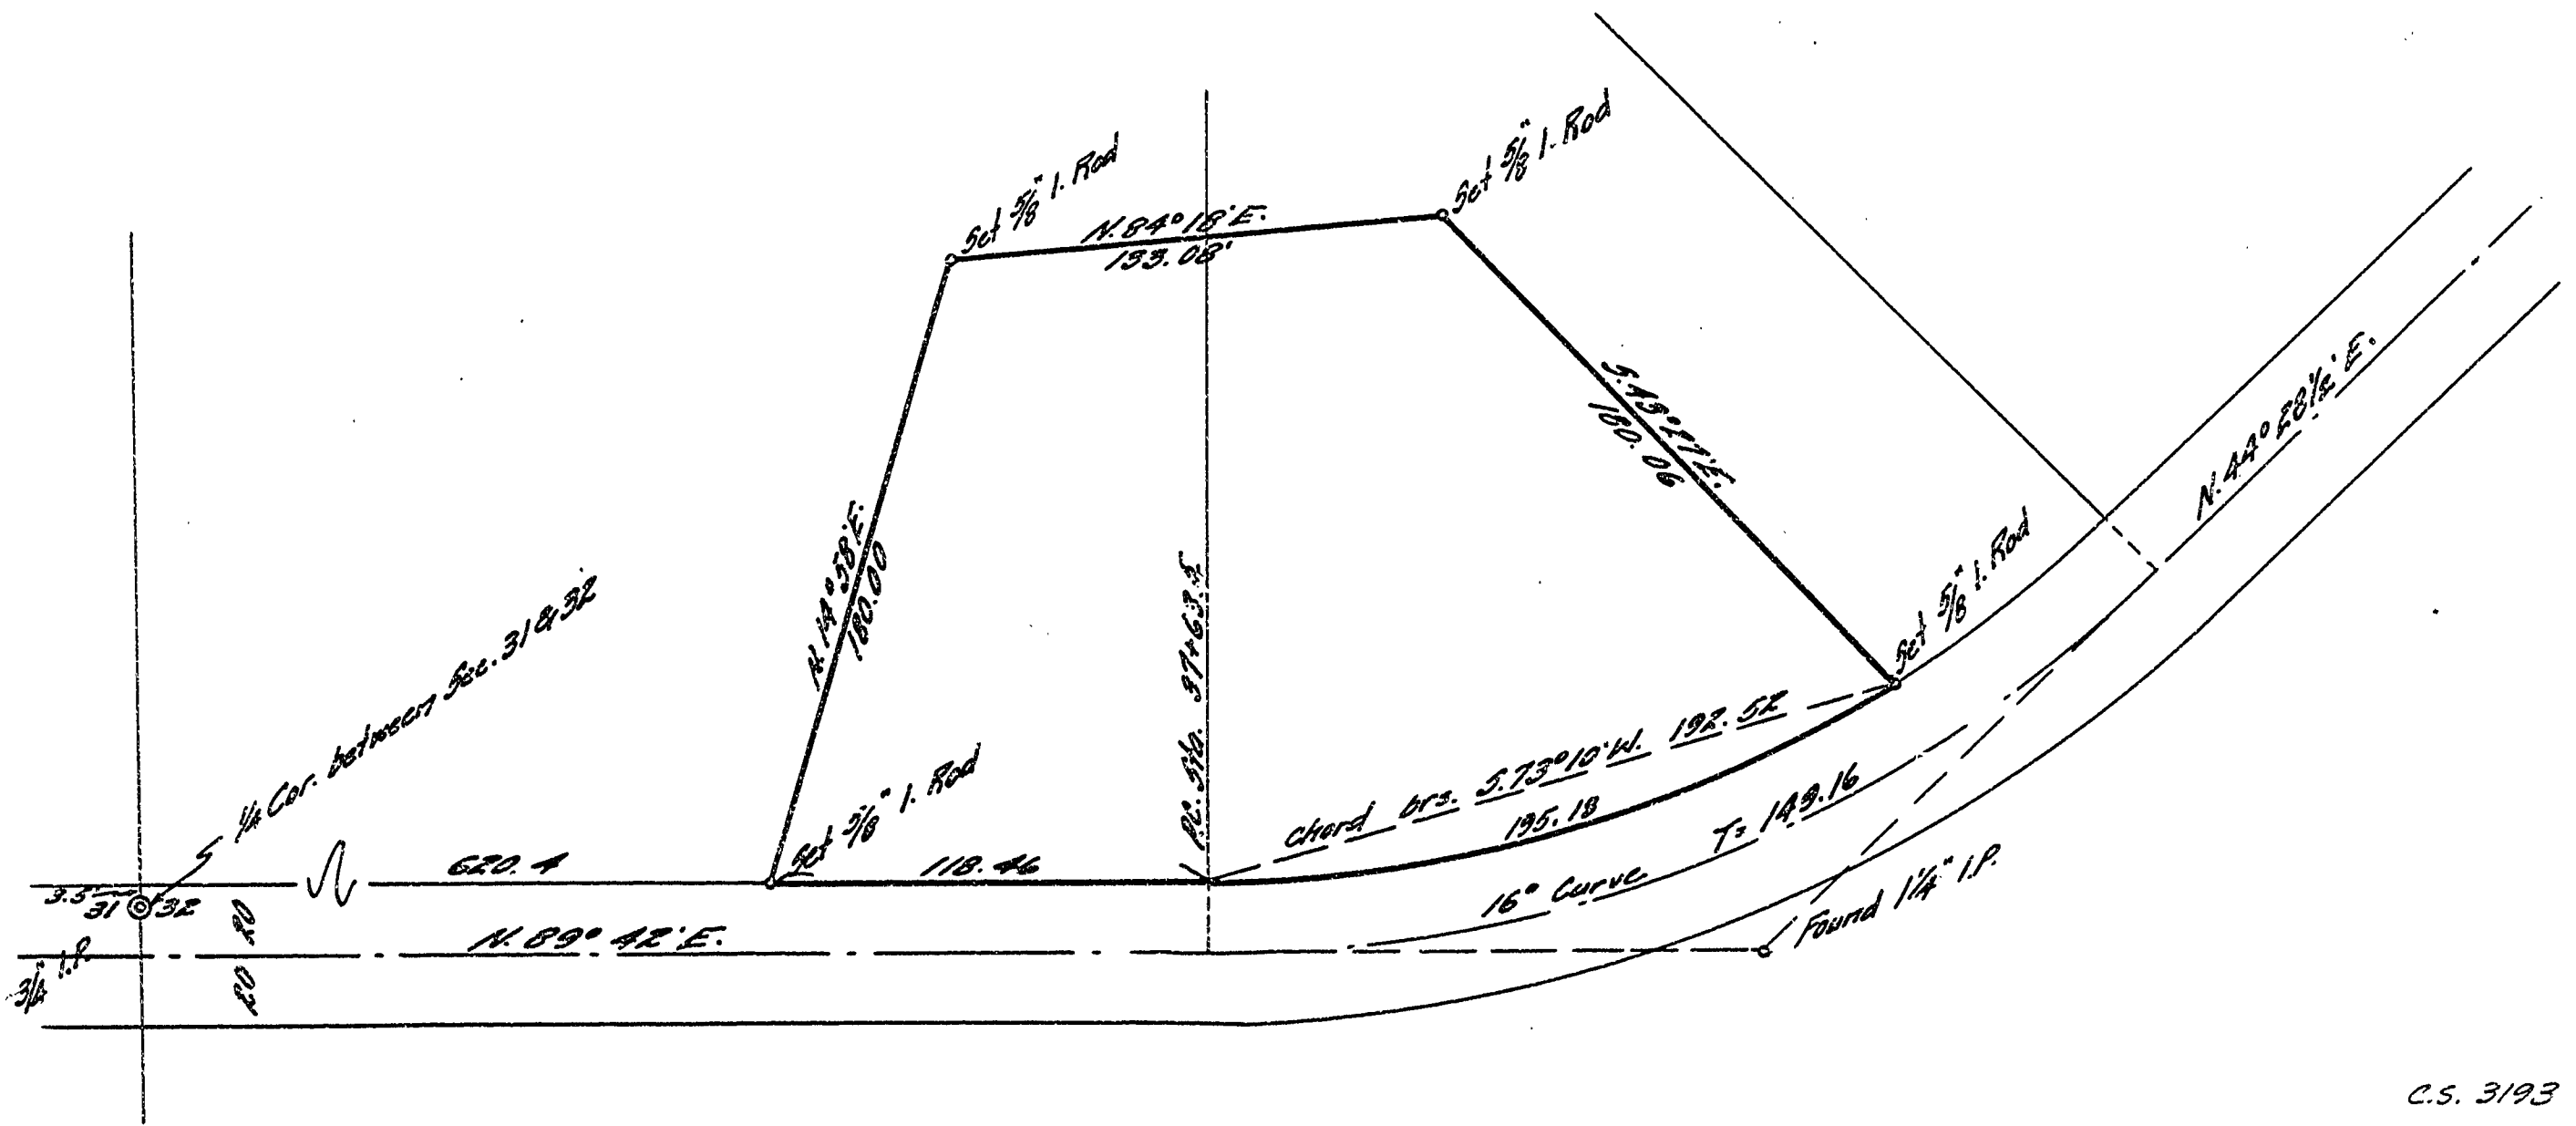

C.S. 3193